Scan # 47957 11-00-055-000-030

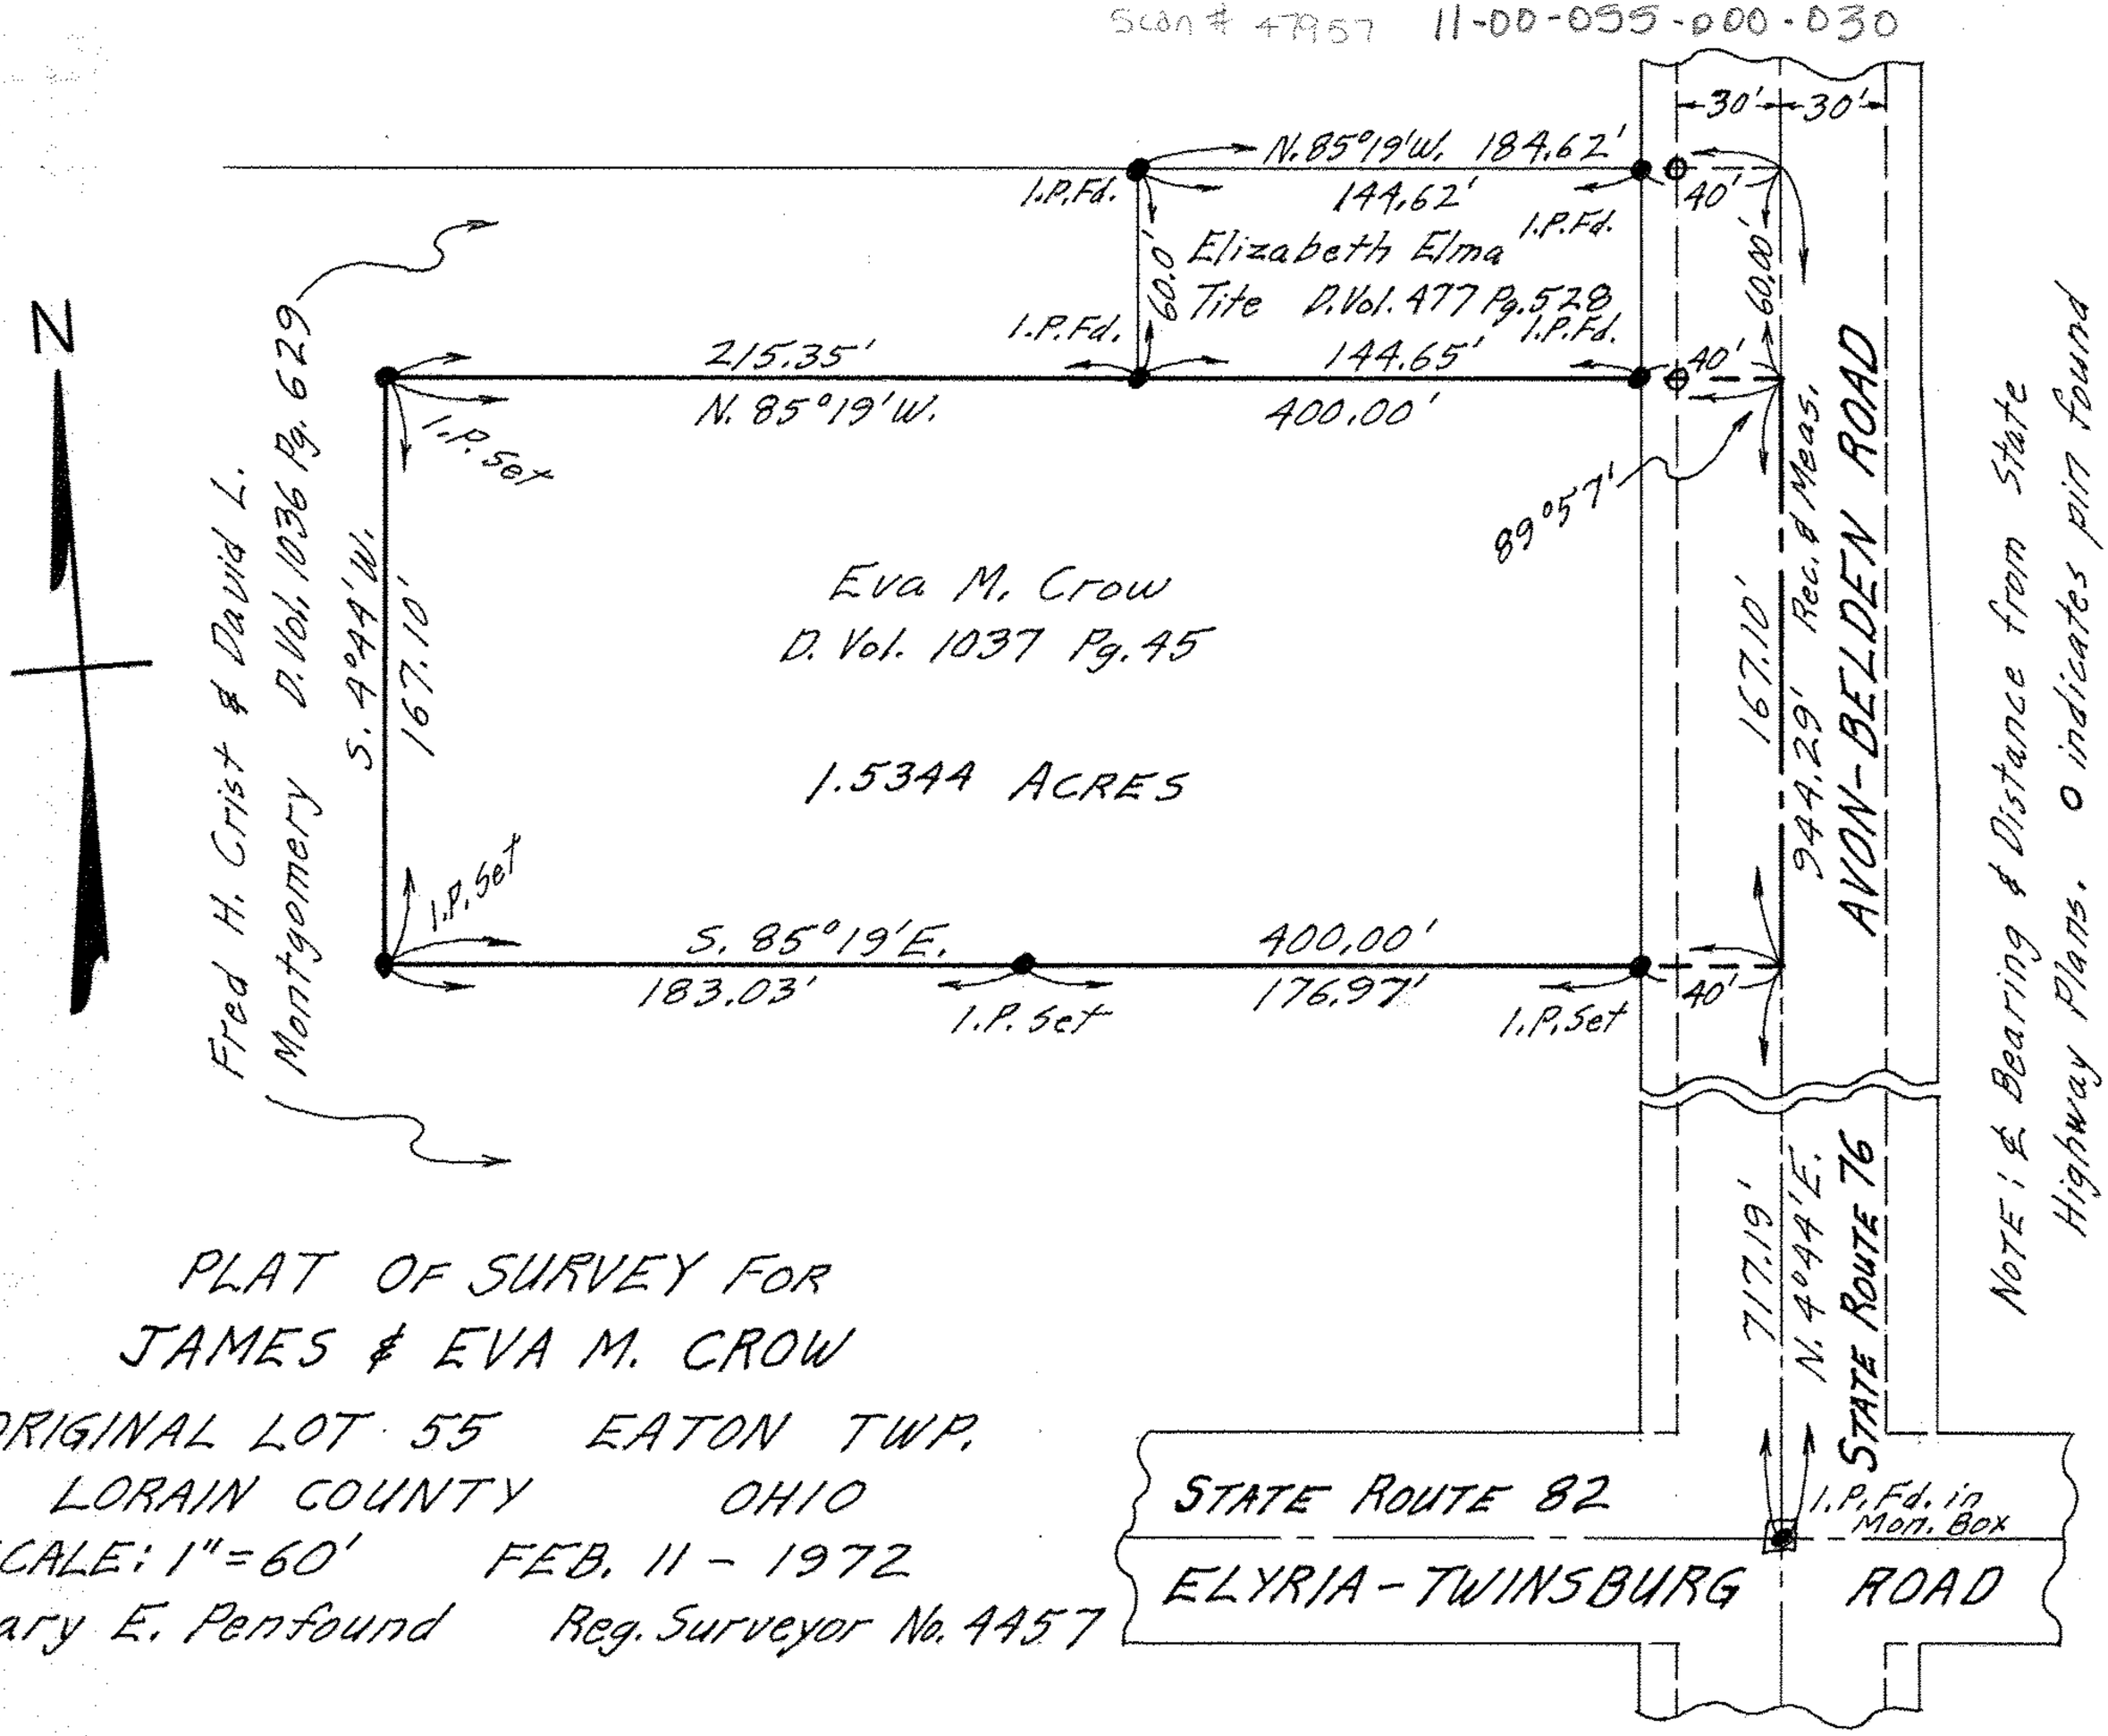

PLAT OF SURVEY FOR
JAMES & EVA M. CROW
ORIGINAL LOT 55 EATON TWP.
LORAIN COUNTY OHIO
SCALE: 1"=60' FEB. 11 - 1972
Gary E. Penfound Reg. Surveyor No. 4457