Scan # 47972 11-00-072-000-007

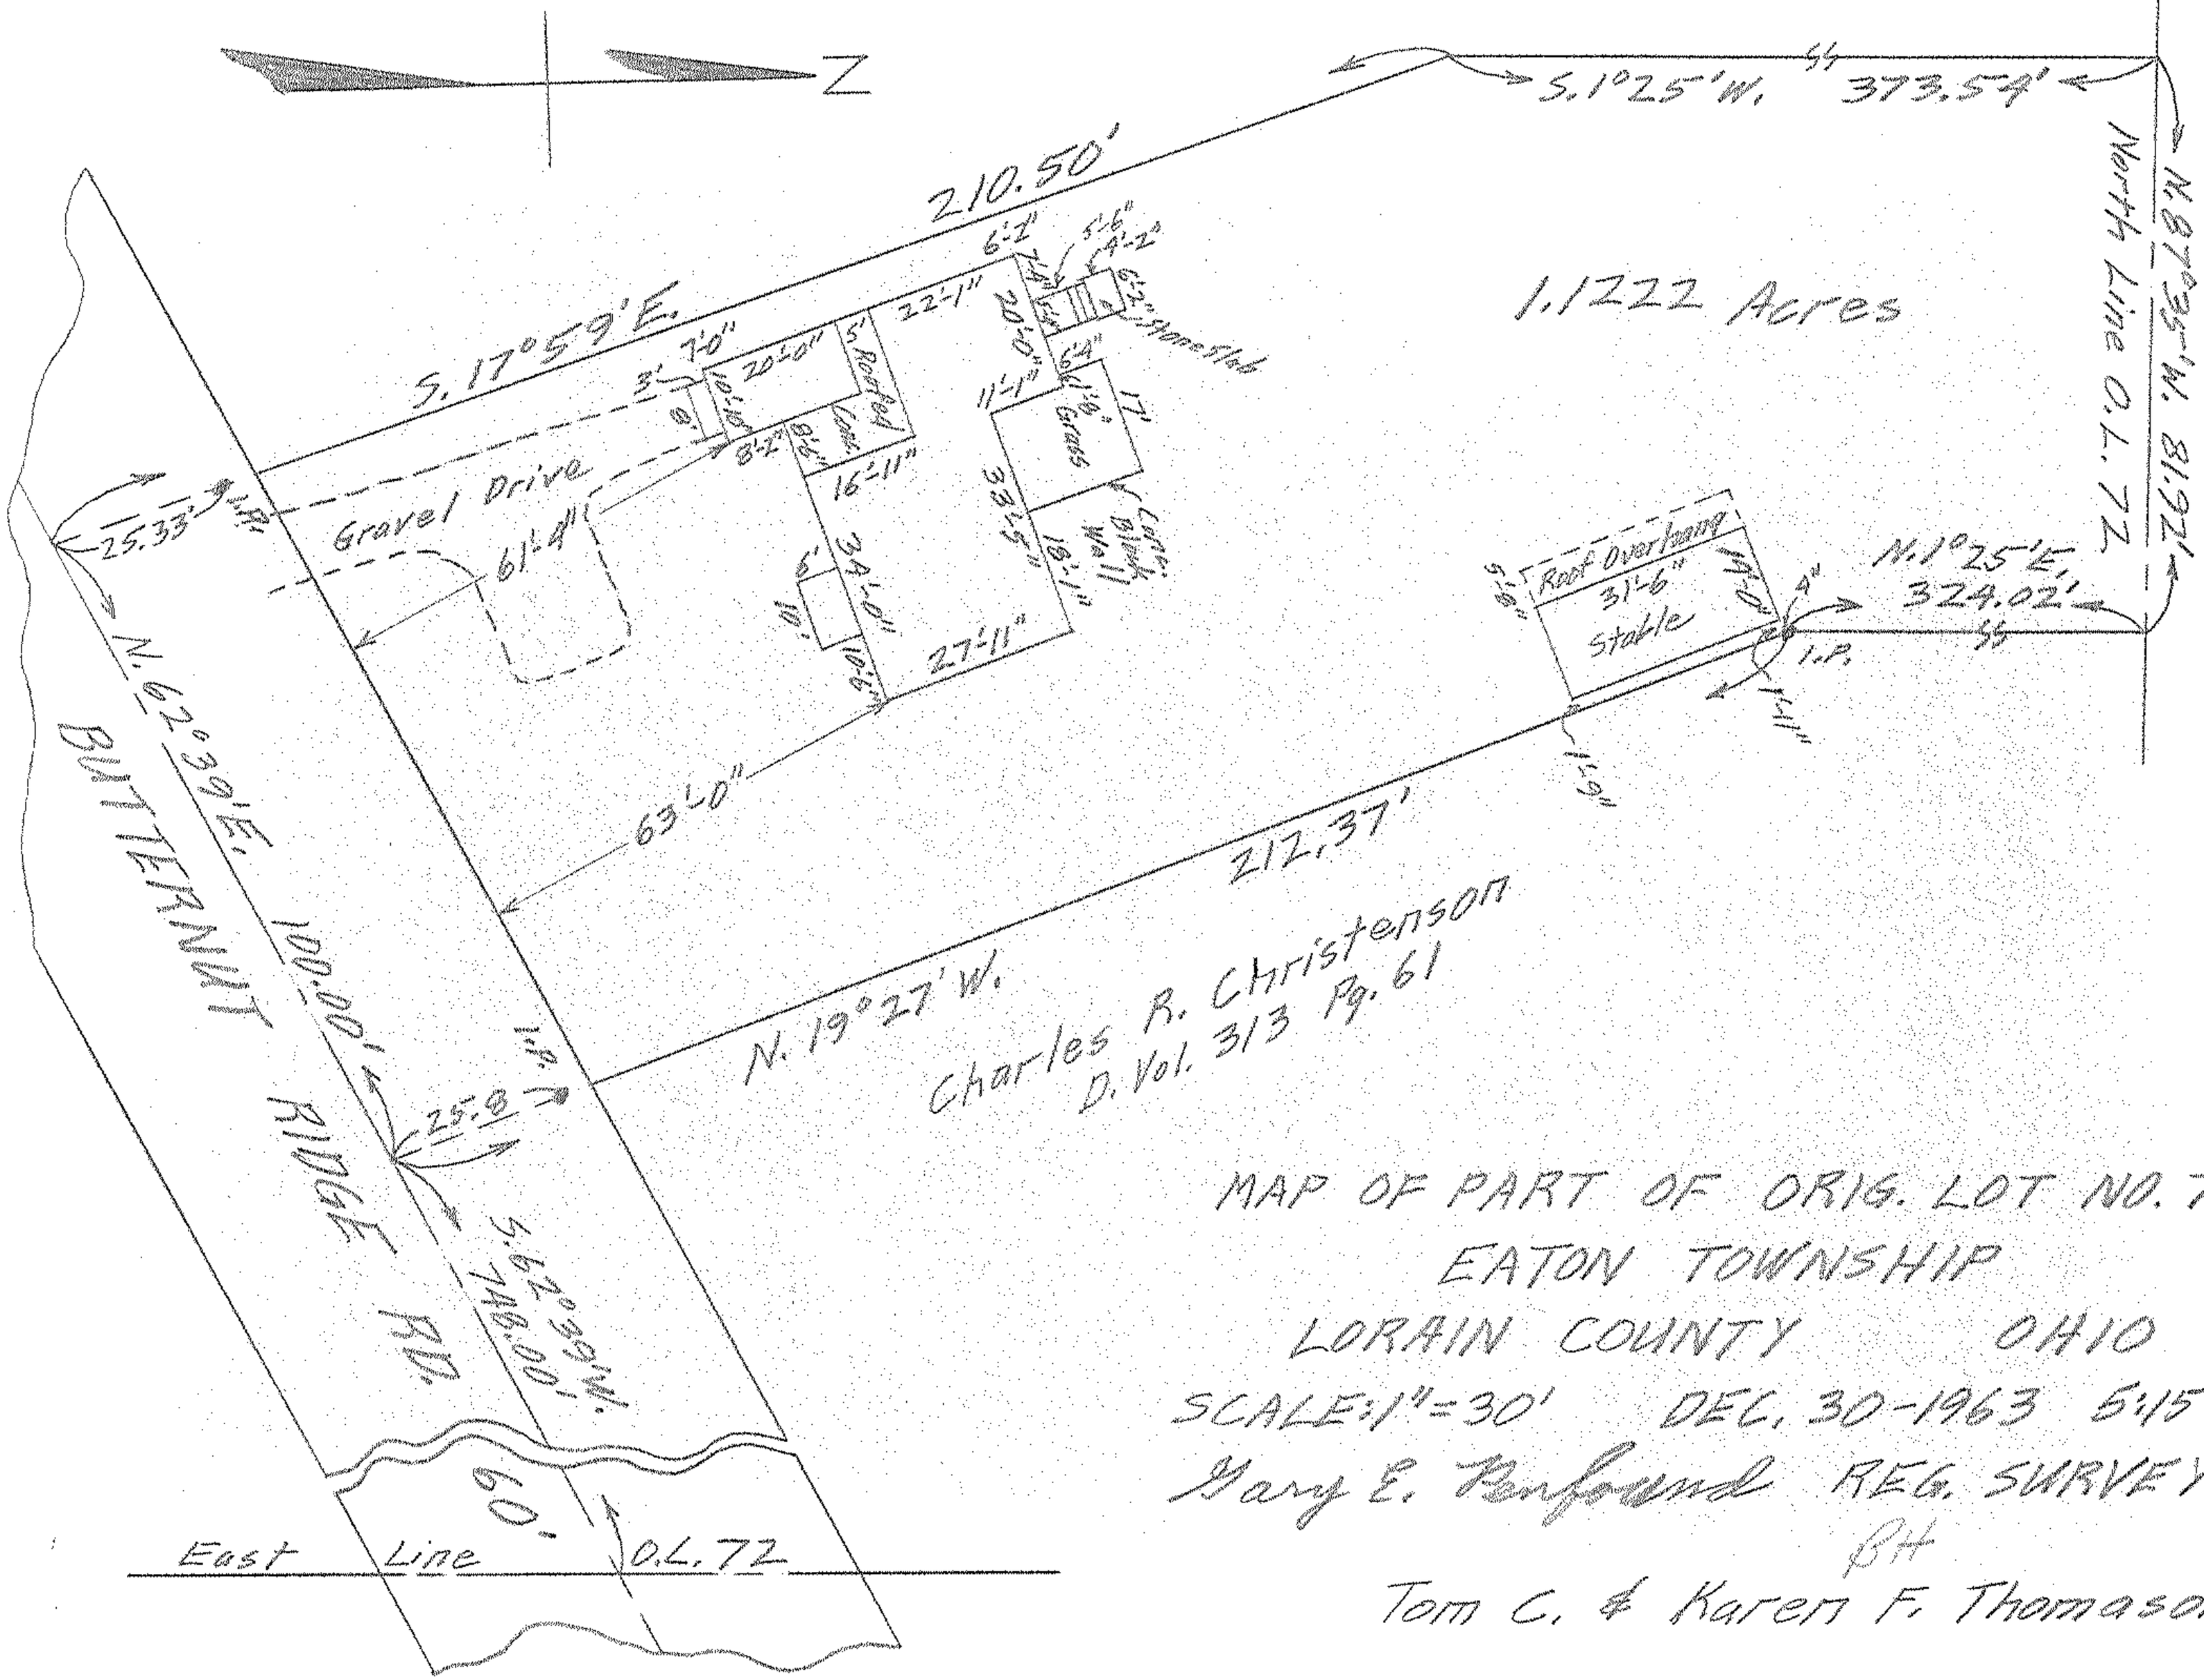

MAP OF PART OF ORIG. LOT NO. 72
EATON TOWNSHIP
LORAIN COUNTY OHIO
SCALE: 1" = 30' DEC. 30-1963 5:15 P.M.
Gary E. Benfound REG. SURVEYOR
BH
Tom C. & Karen F. Thomason