PLAT OF SURVEYS FOR
DONALD KNECHTGES

ORIGINAL LOT 78 – EATON TWP.
LORAIN COUNTY OHIO
SCALE: 1"=100' MARCH 31 – 1973

Gary E. Penfound
Reg. Surveyor No. 4457

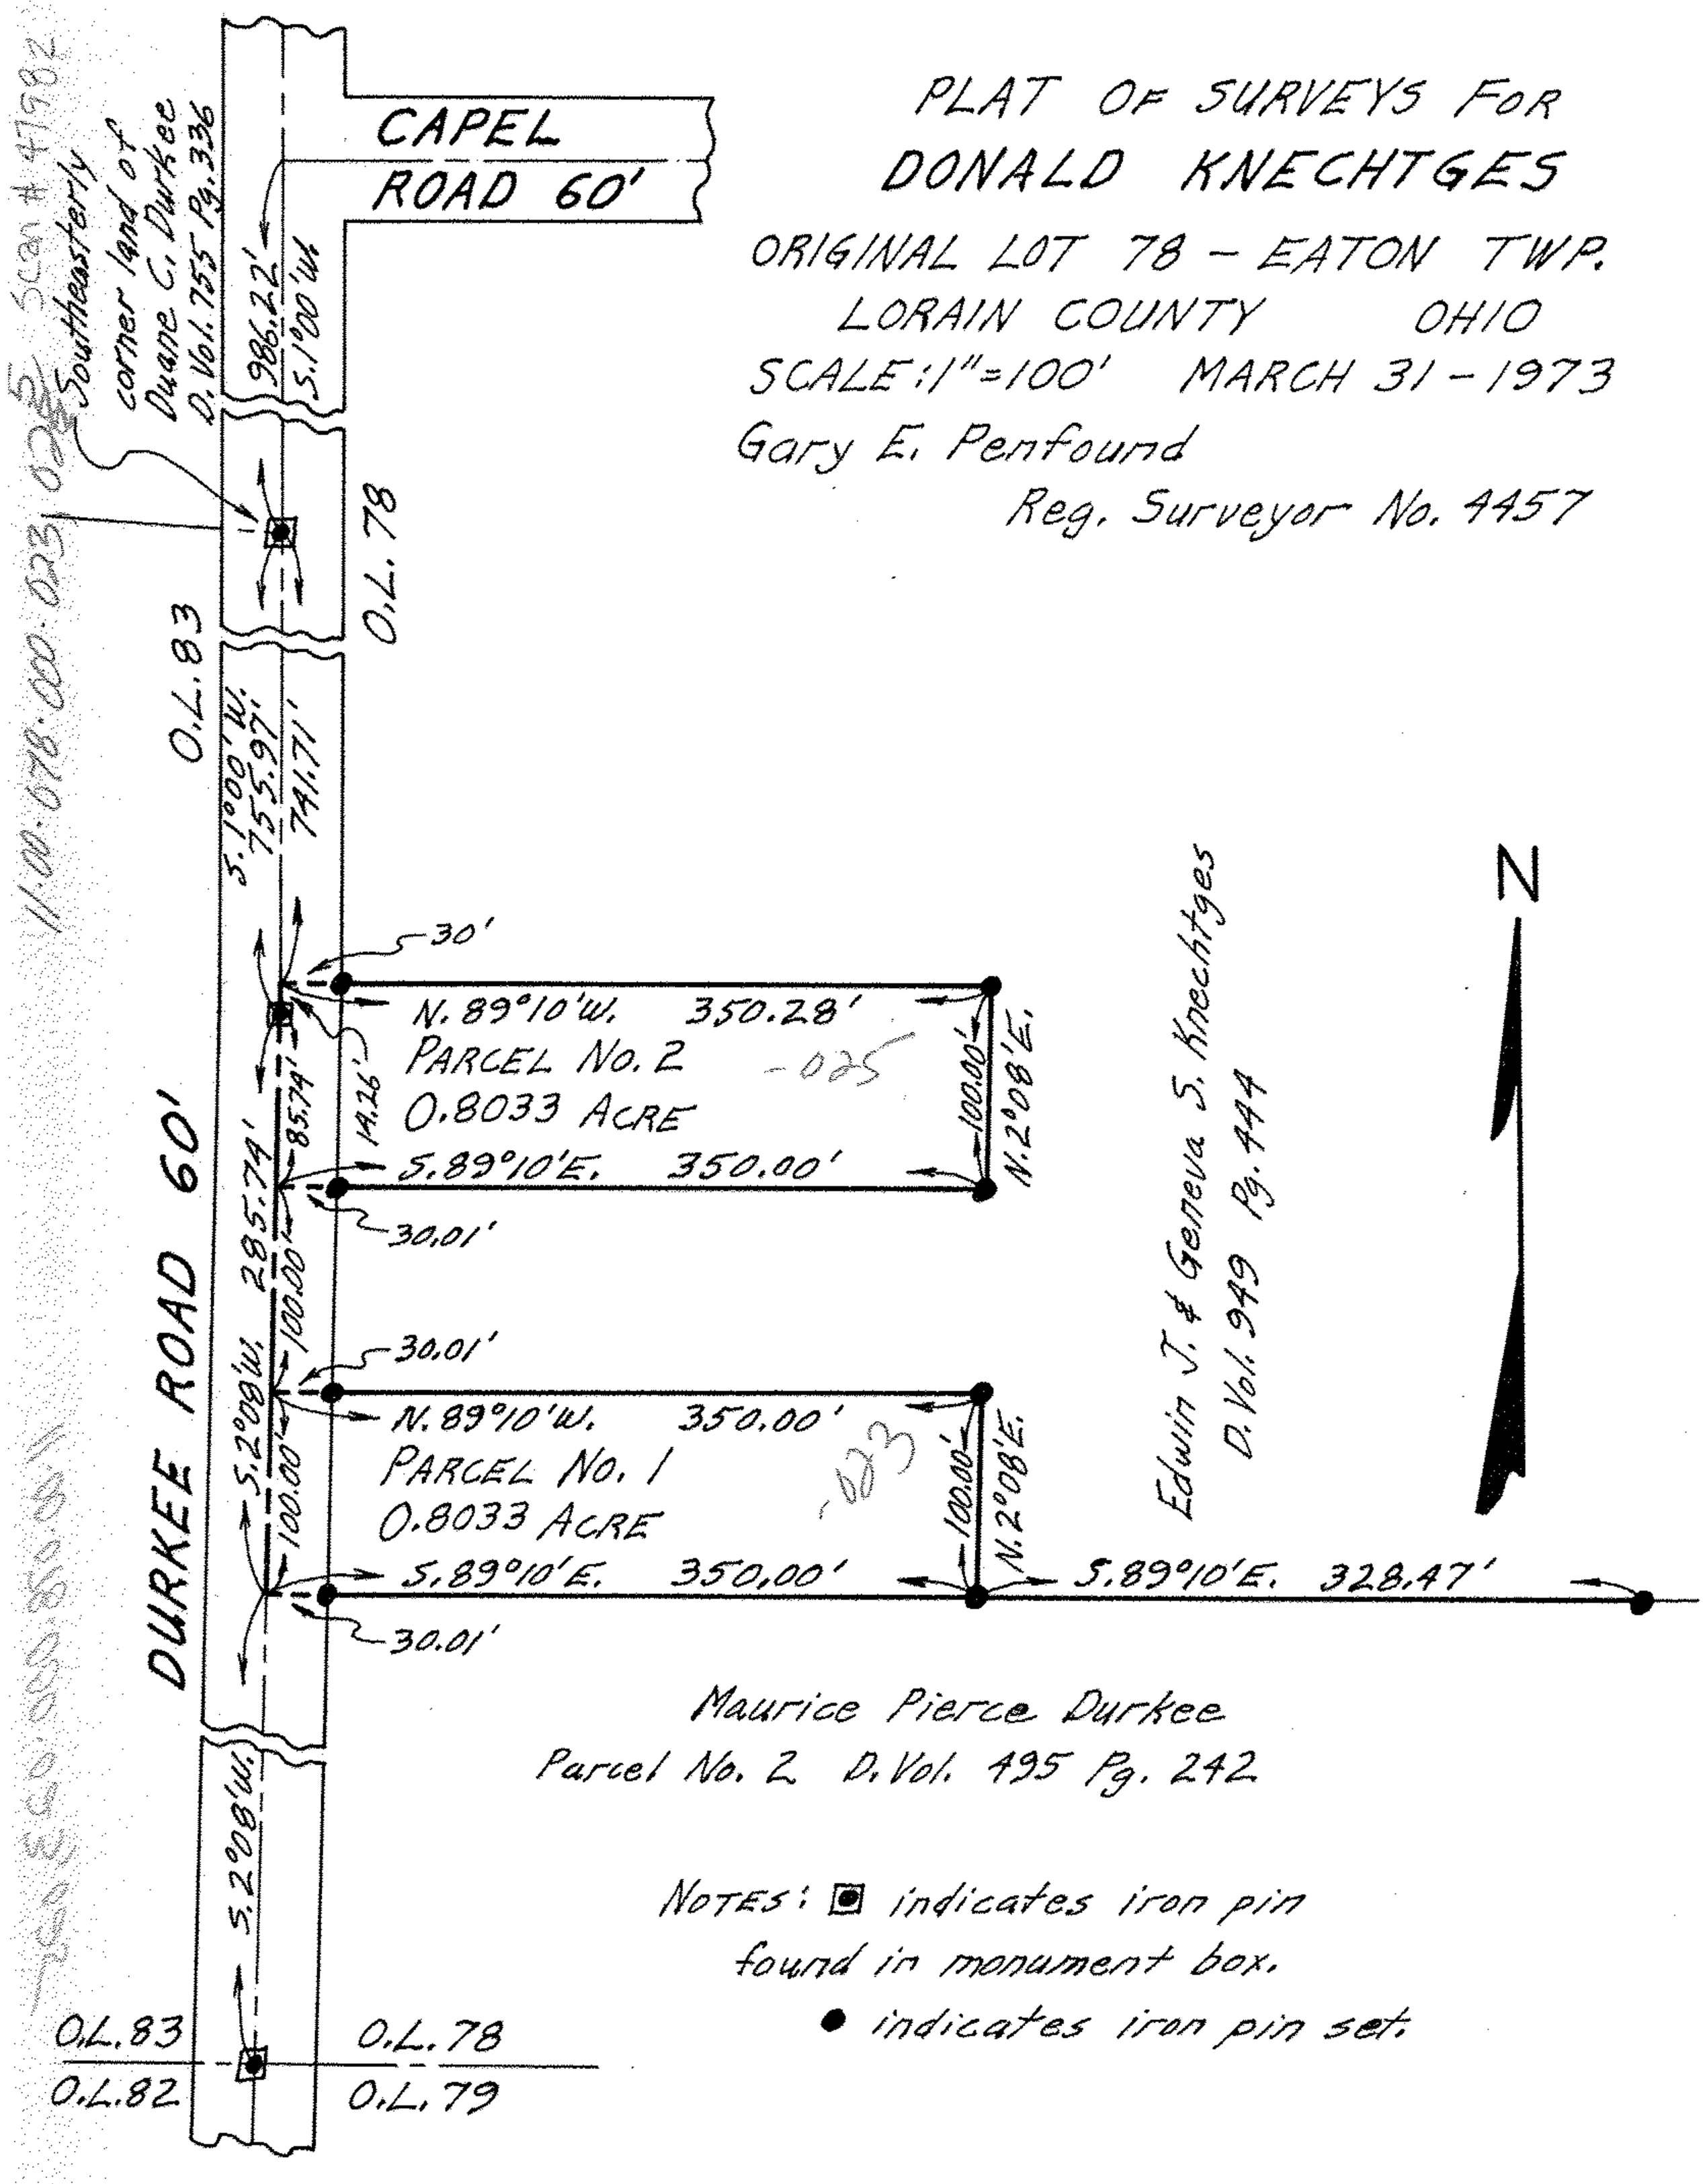

Maurice Pierce Durkee
Parcel No. 2 D. Vol. 495 Pg. 242

NOTES: ▣ indicates iron pin found in monument box.
● indicates iron pin set.