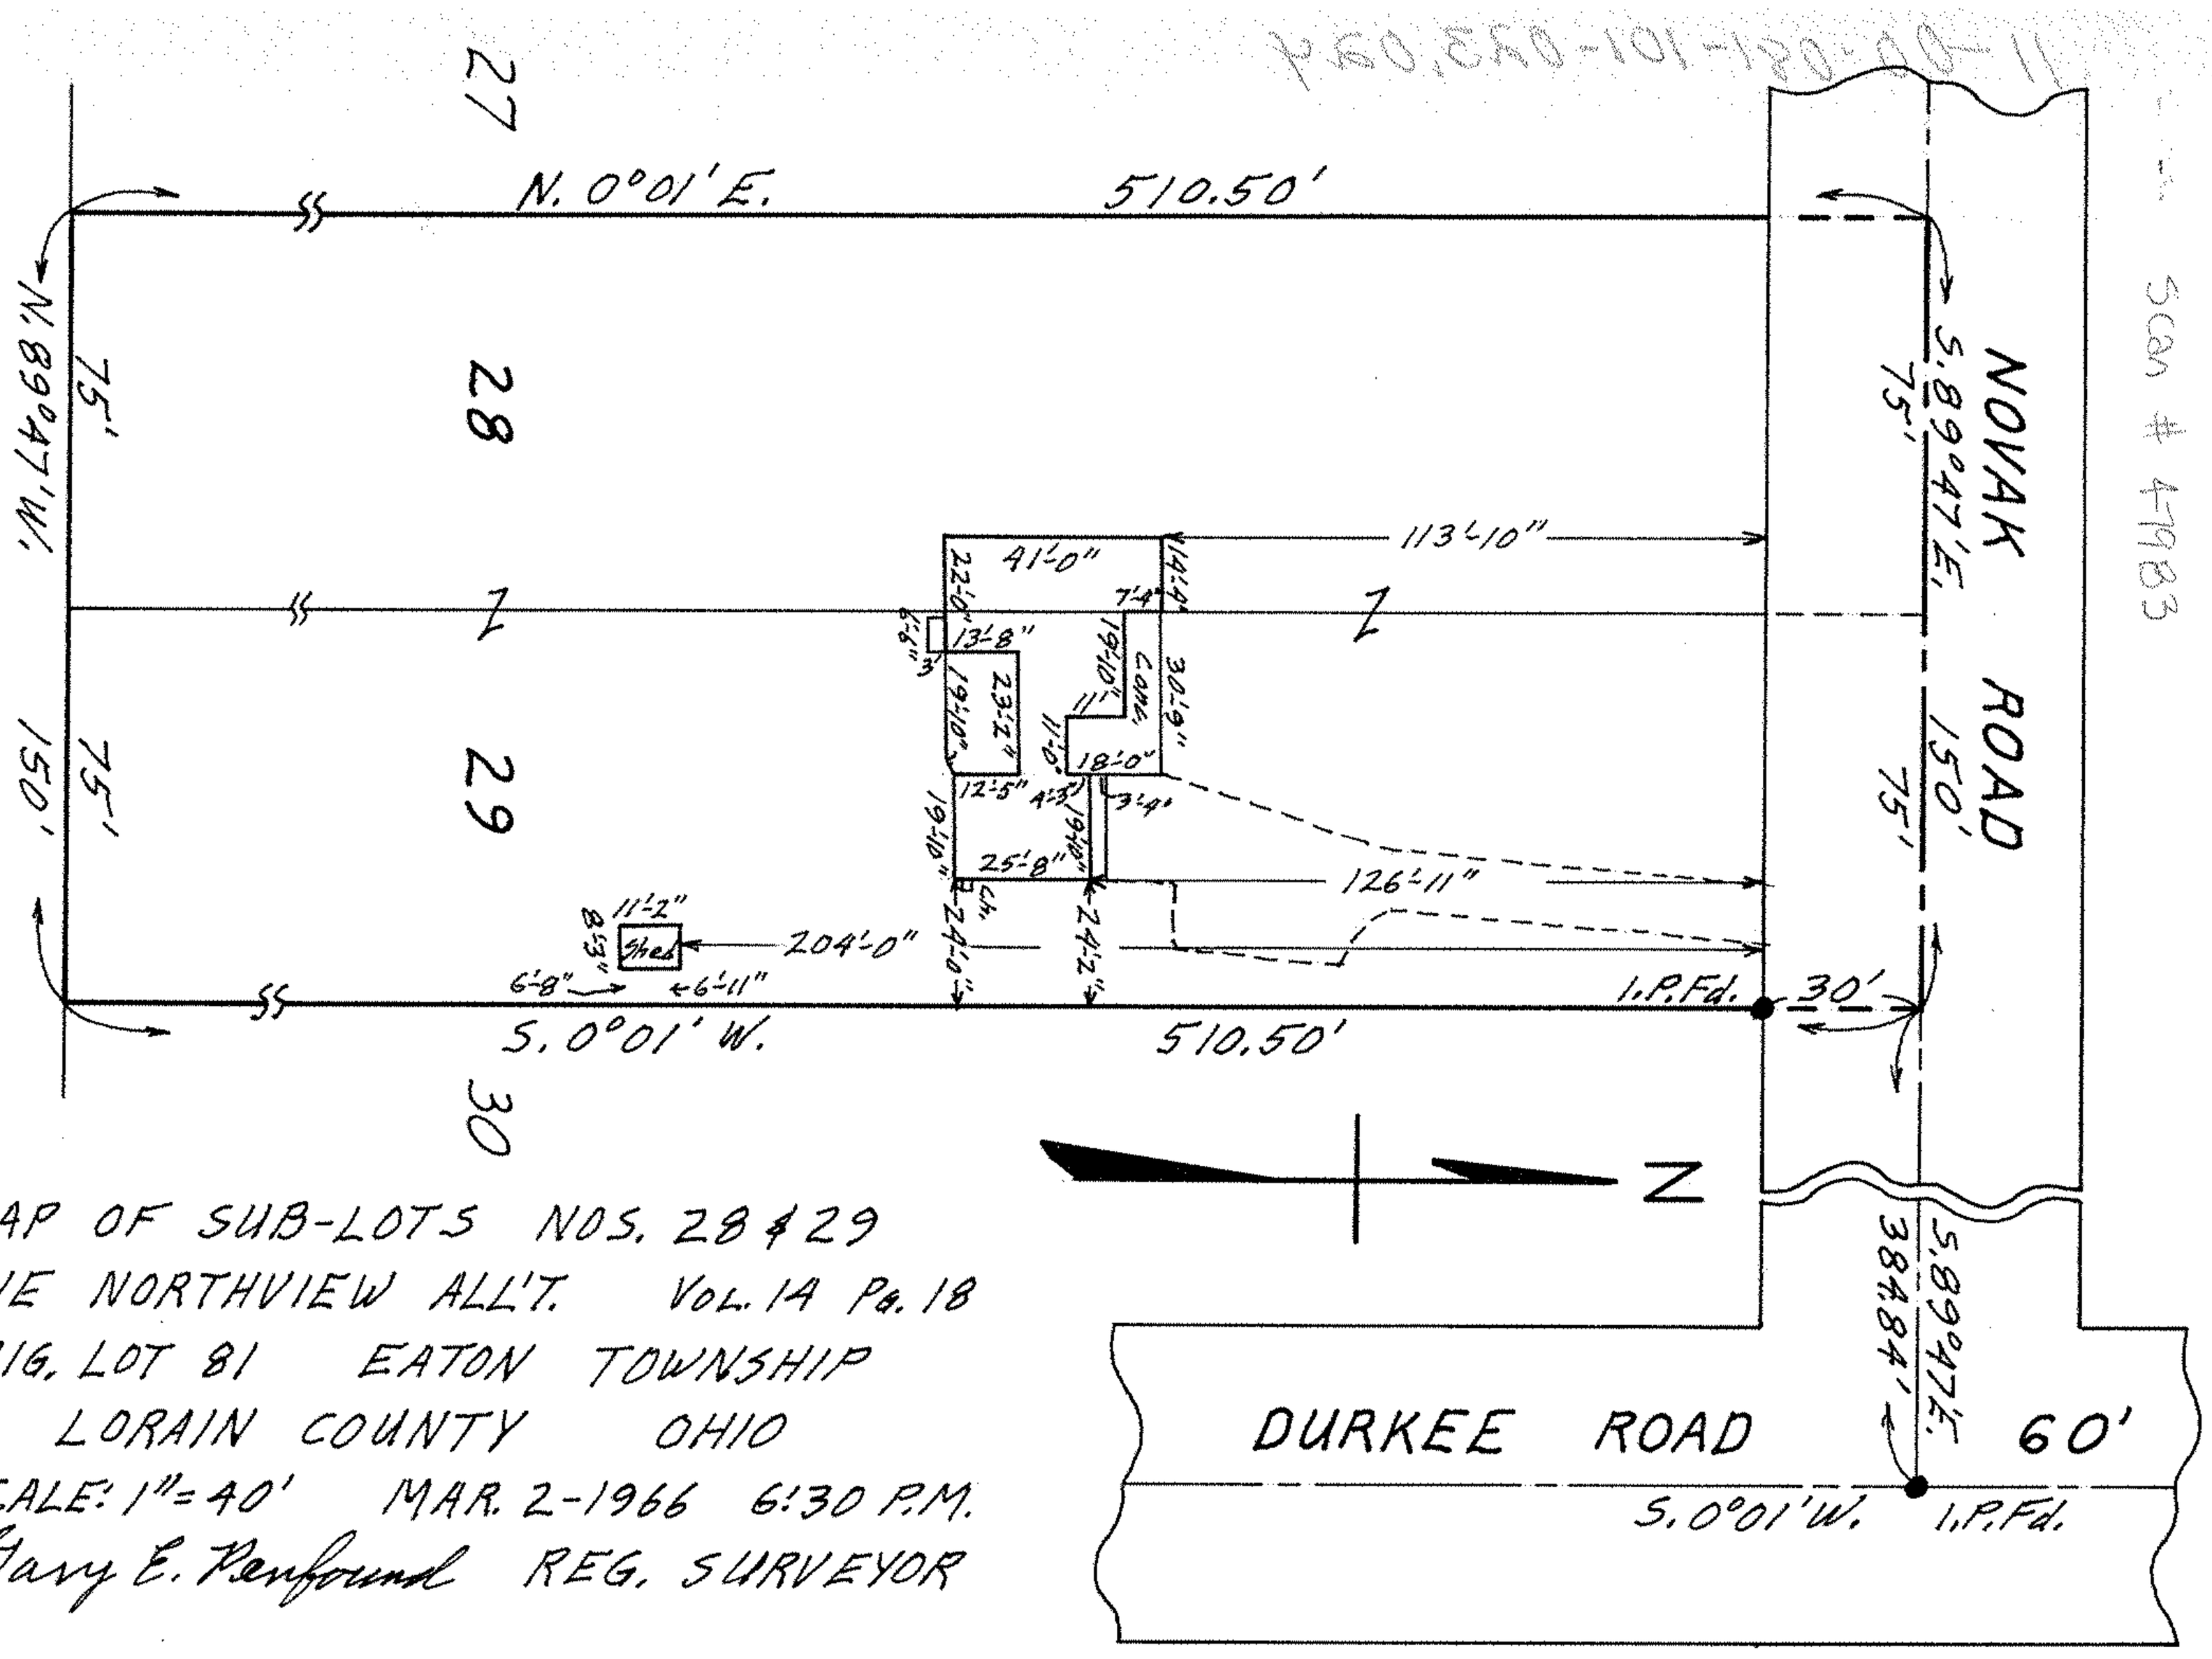

MAP OF SUB-LOTS NOS. 28 & 29
THE NORTHVIEW ALL'T. VOL. 14 PG. 18
ORIG. LOT 81 EATON TOWNSHIP
LORAIN COUNTY OHIO
SCALE: 1" = 40' MAR. 2-1966 6:30 P.M.
Gary E. Penfound REG. SURVEYOR

BERKS TITLE INS. CO. Order No. 1645

Scan # 47983