LAUNDON . SIMON . CAHL & ASSOC. INC.
CONSULTING ENGINEERS & SURVEYORS
219 COURT ST. ELYRIA, OHIO 44035

SURVEY FOR:

FRANCES M. FELVER
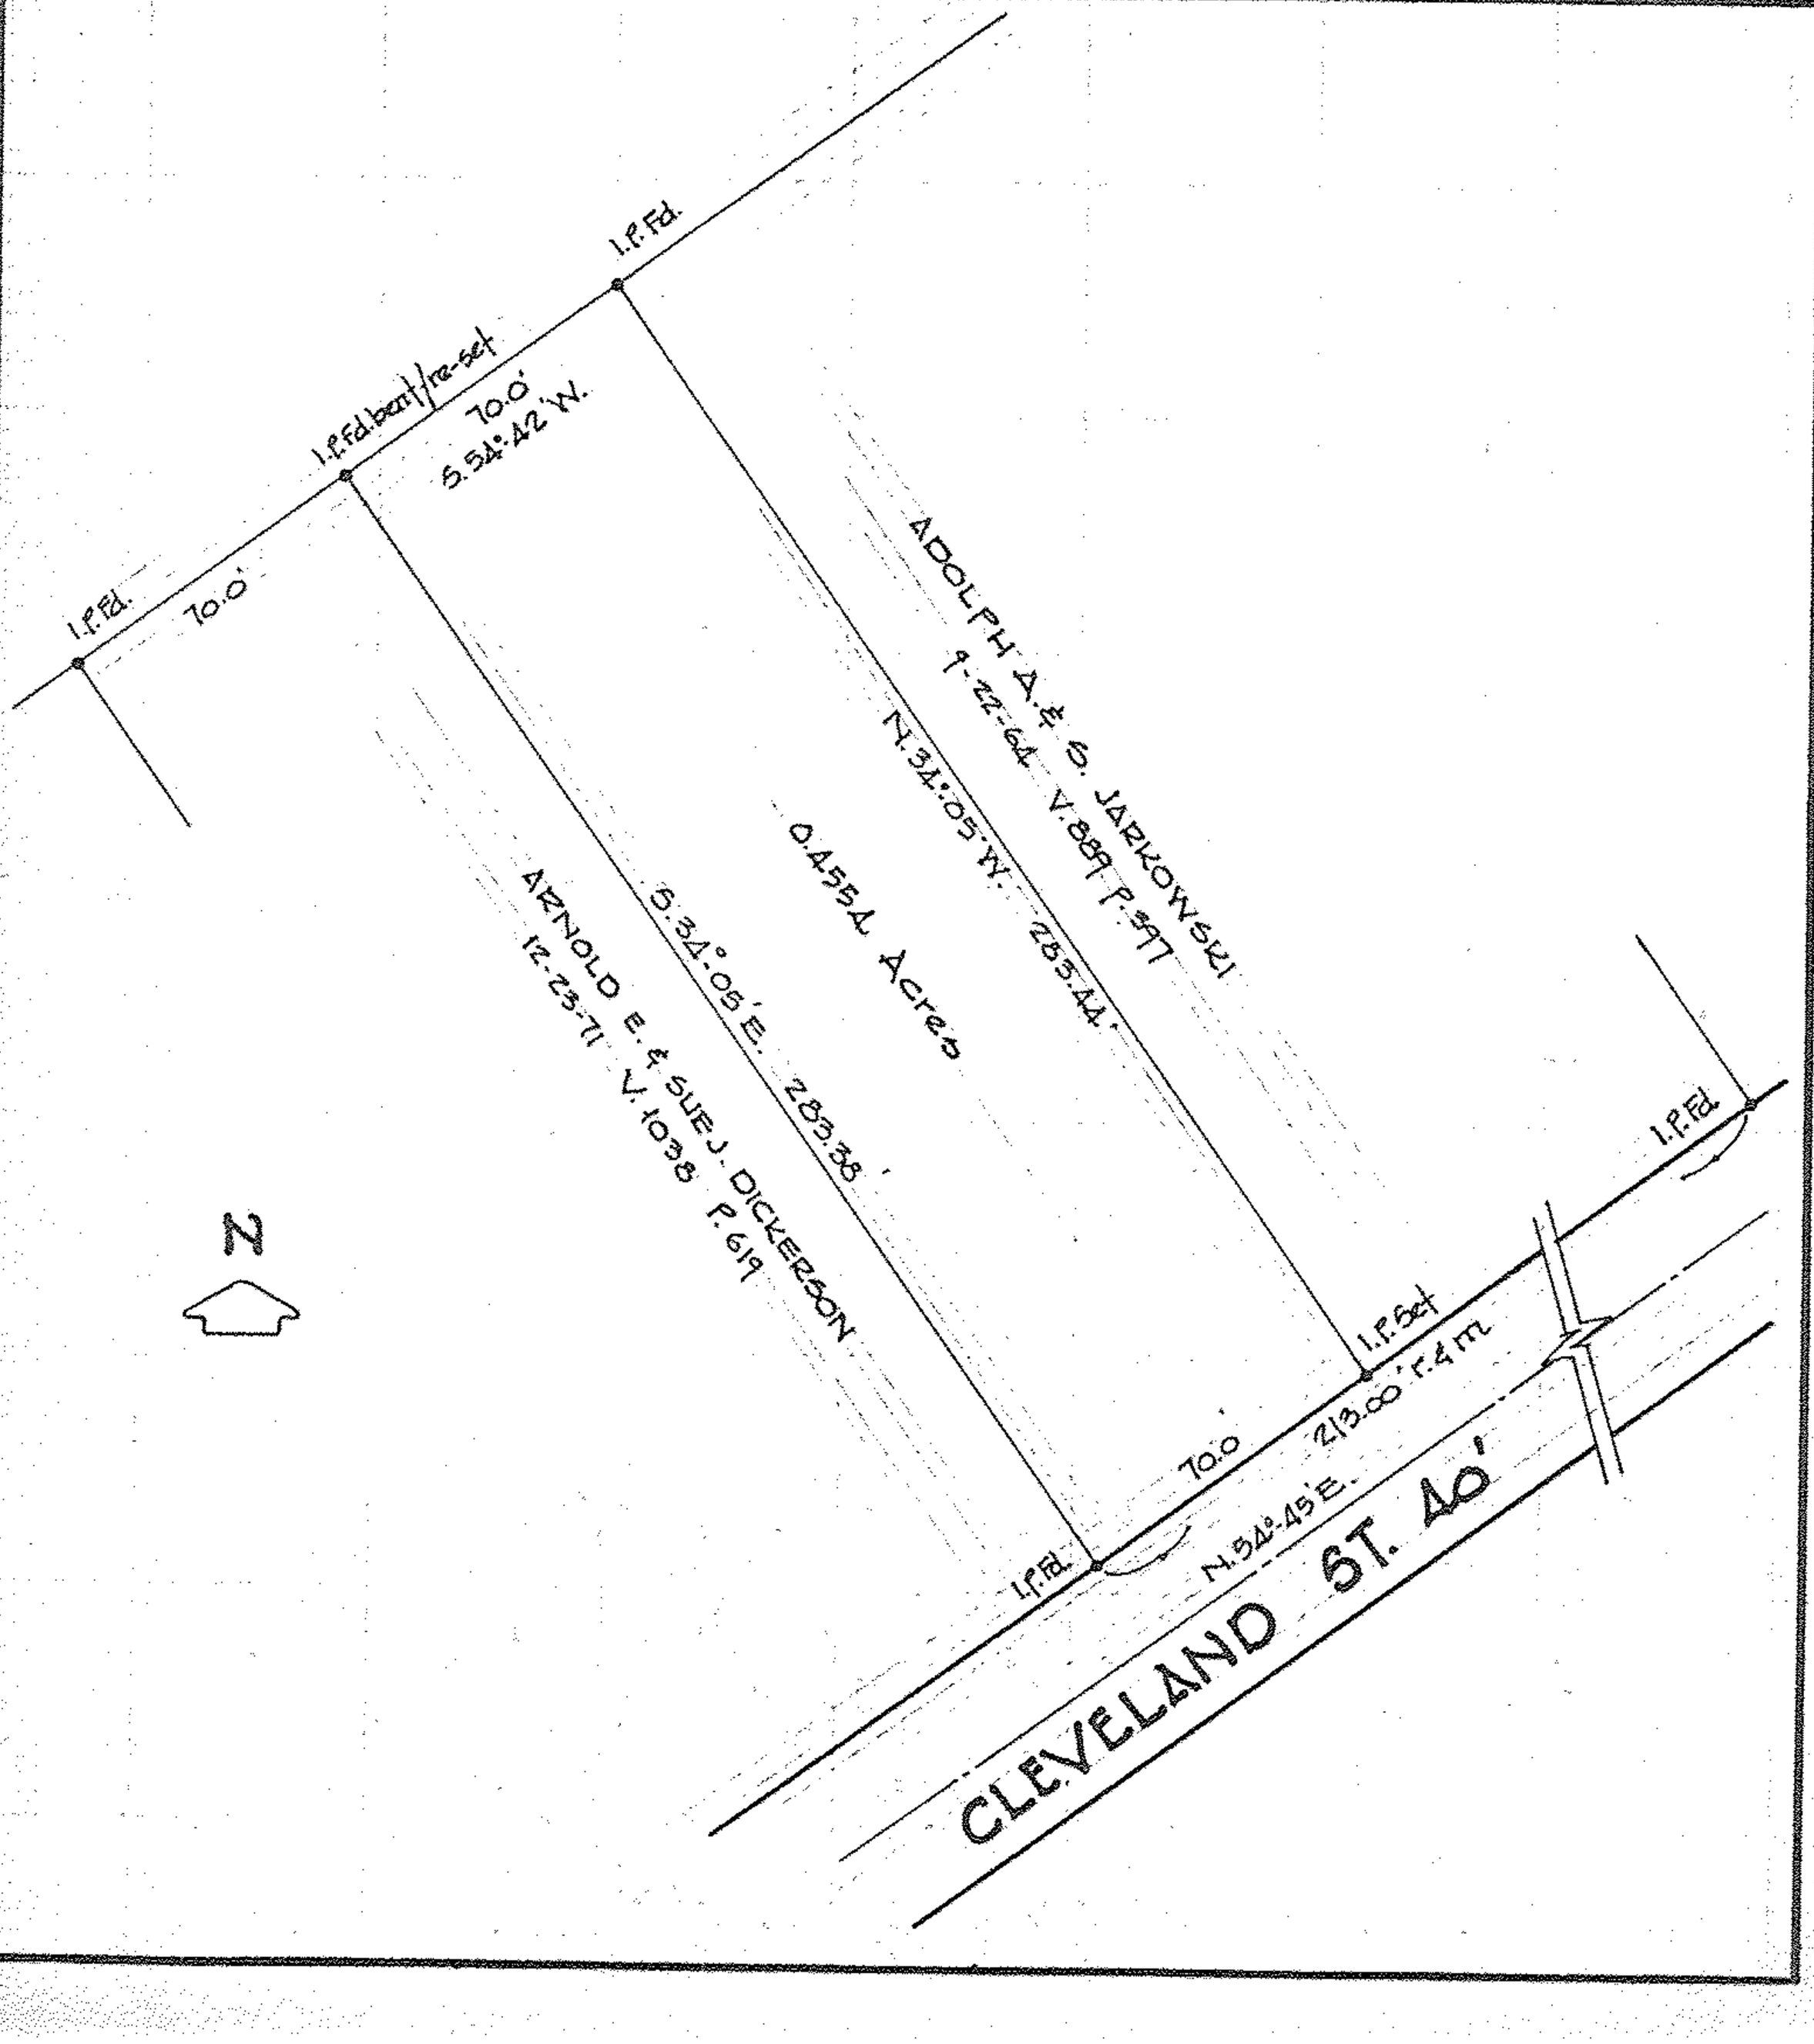
Orig. Lot 81	City of	Date AUG. 29, 1986 Scale 1"=50'
Orig. Sec	Village of GRAFTON	Dwn. by R.G.S. Chkd. by C.J.
Tract	County of LORAIN	Job No. 86-1511 F.B. No
Township of EATON	State of OHIO	Printed