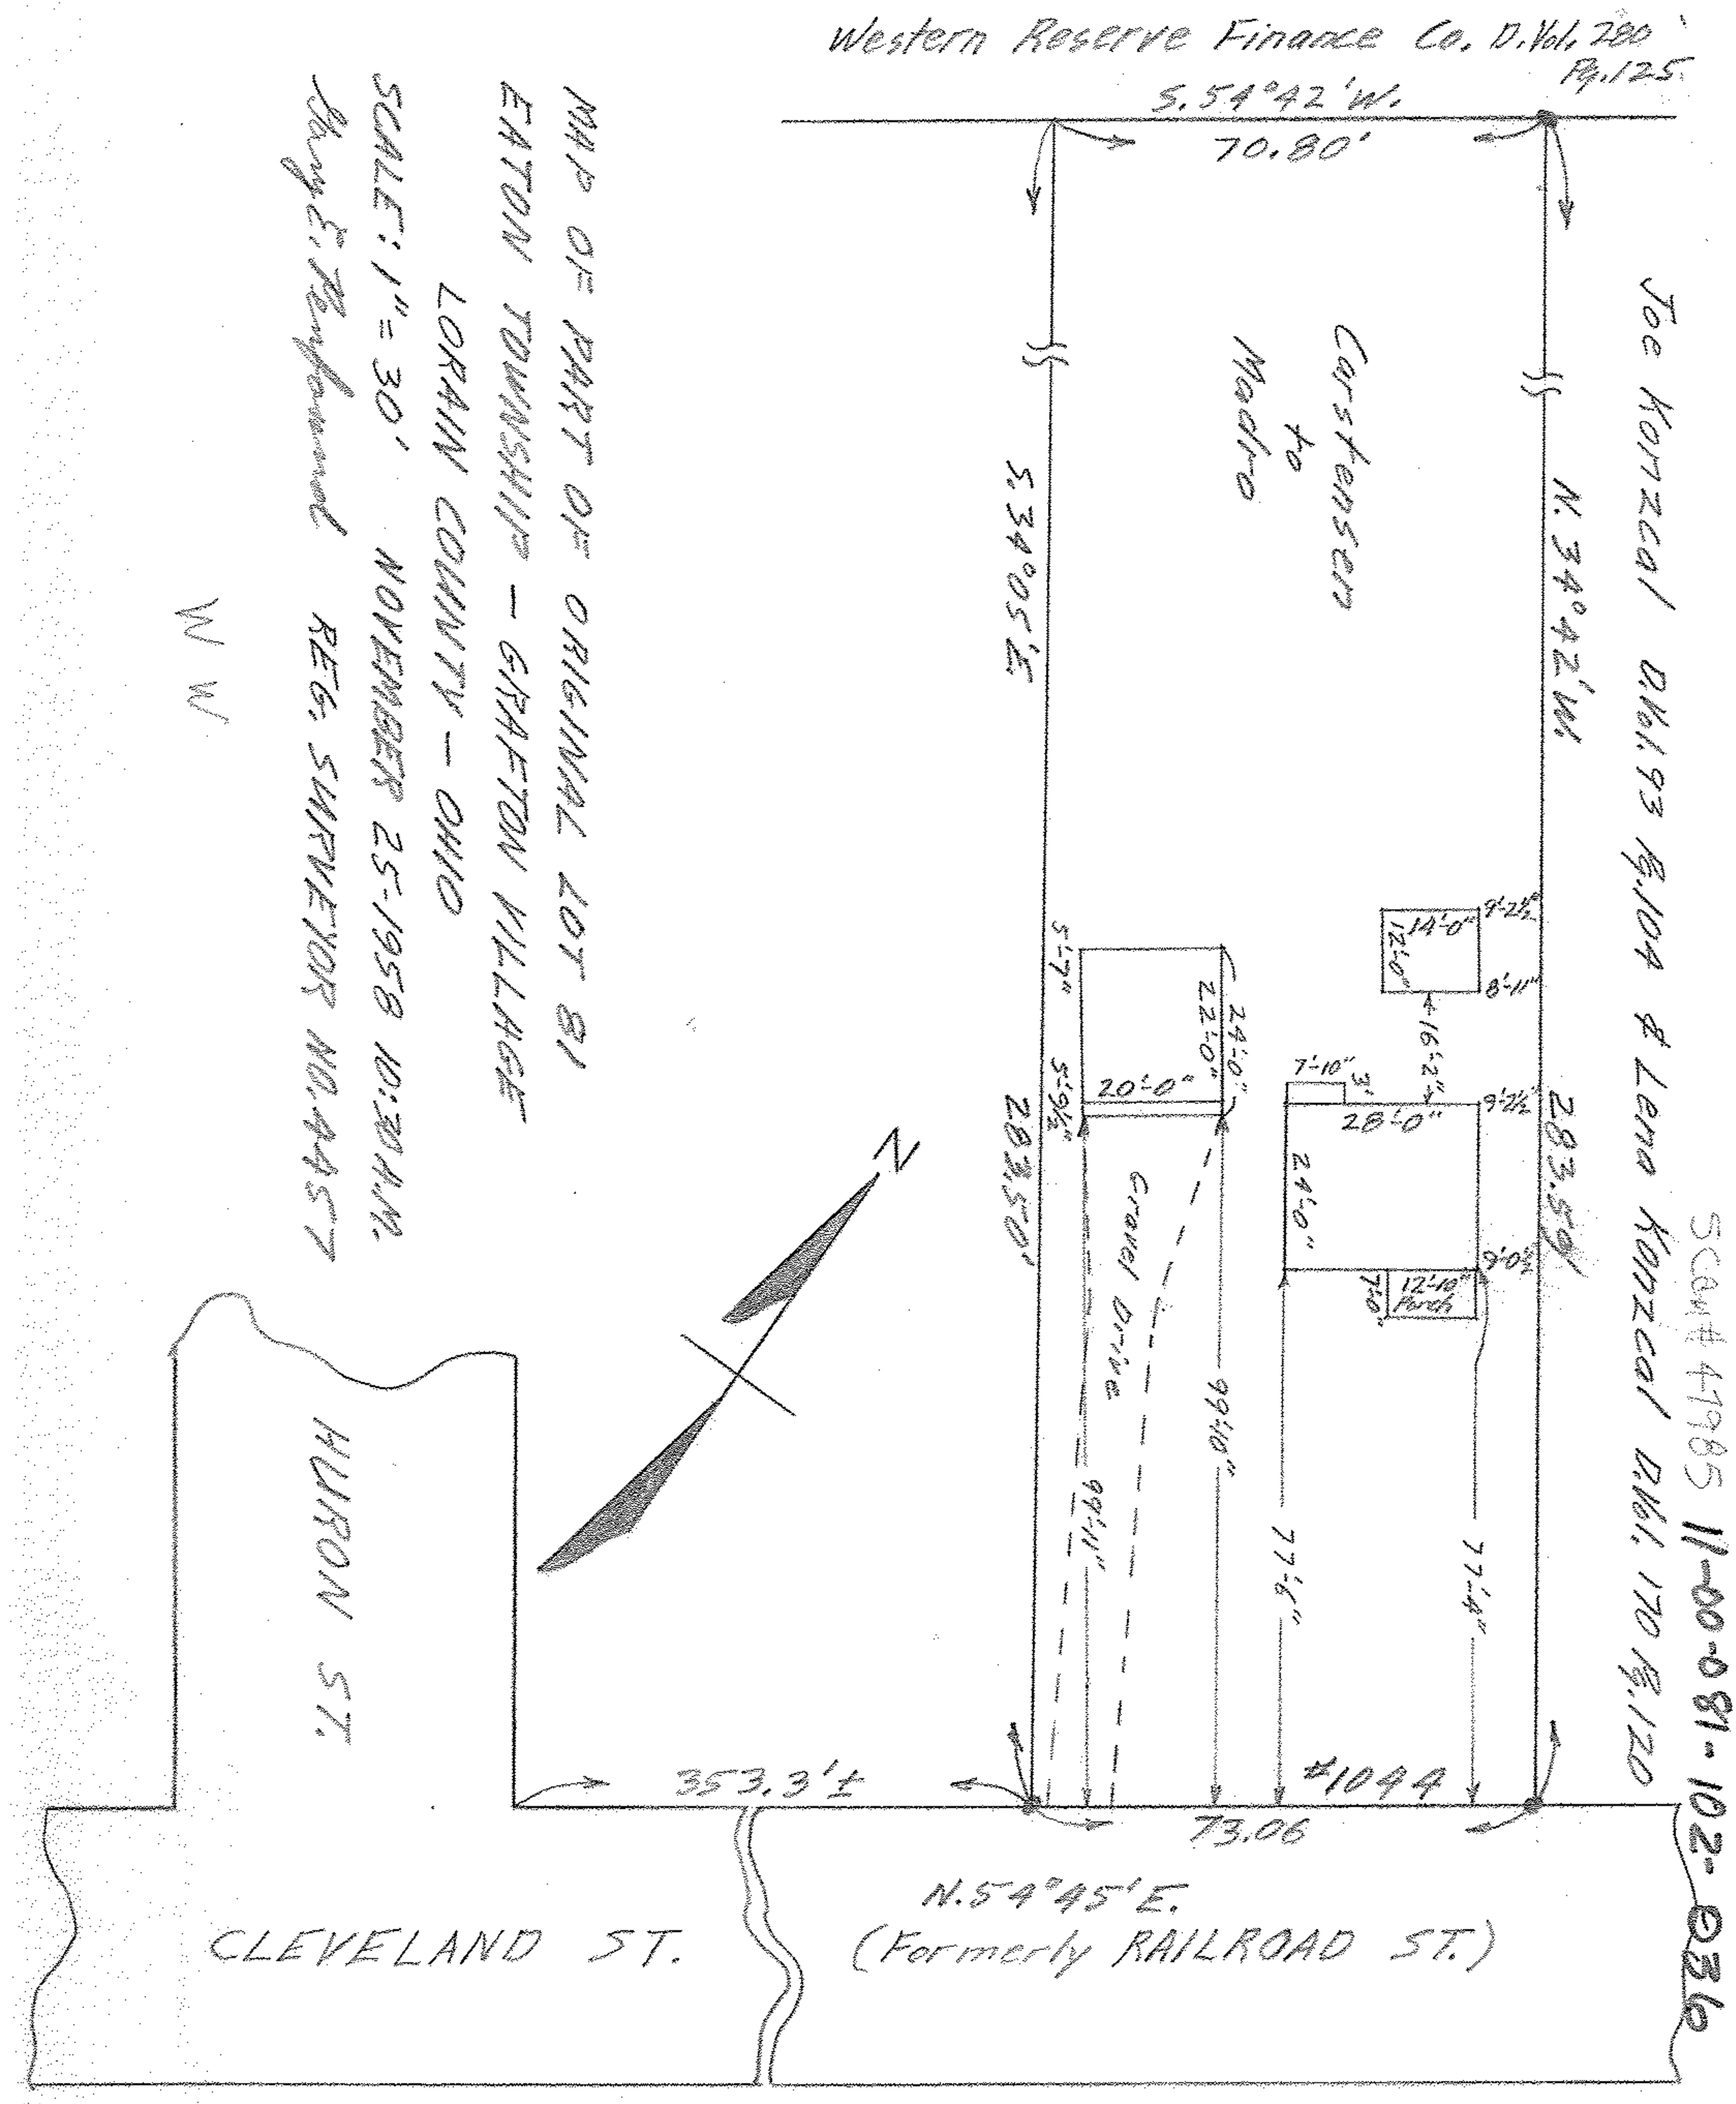
Western Reserve Finance Co. D.Vol. 280 Pg.125
S.54°42'W.
70.80'
Joe Konzcal D.Vol.93 Pg.104 & Lena Konzcal D.Vol. 170 Pg.120
Carstensen to Madro
S.34°05'E.
N.34°42'W.
283.50'
283.50'
Gravel Drive
99'-11"
99'-10"
77'-6"
77'-4"
20'-0"
22'-0"
24'-0"
28'-0"
24'-0"
14'-0"
12'-0"
12'-10" Porch
16'-2"
7'-10"
3'
9'-2½"
8'-11"
9'-2½"
9'-0½"
7'-0"
5'-7"
5'-9½"
#1044
353.3'±
73.06
N.54°45'E.
(Formerly RAILROAD ST.)
CLEVELAND ST.
HURON ST.
N
MAP OF PART OF ORIGINAL LOT 81
EATON TOWNSHIP - GRAFTON VILLAGE
LORAIN COUNTY - OHIO
SCALE: 1" = 30'
NOVEMBER 25-1958 10:30 A.M.
REG. SURVEYOR NO. 4457
W W
SCan# 47985 11-00-081-102-036