11·00·085·000·007,008,011,021,023,035
Scan# 47991

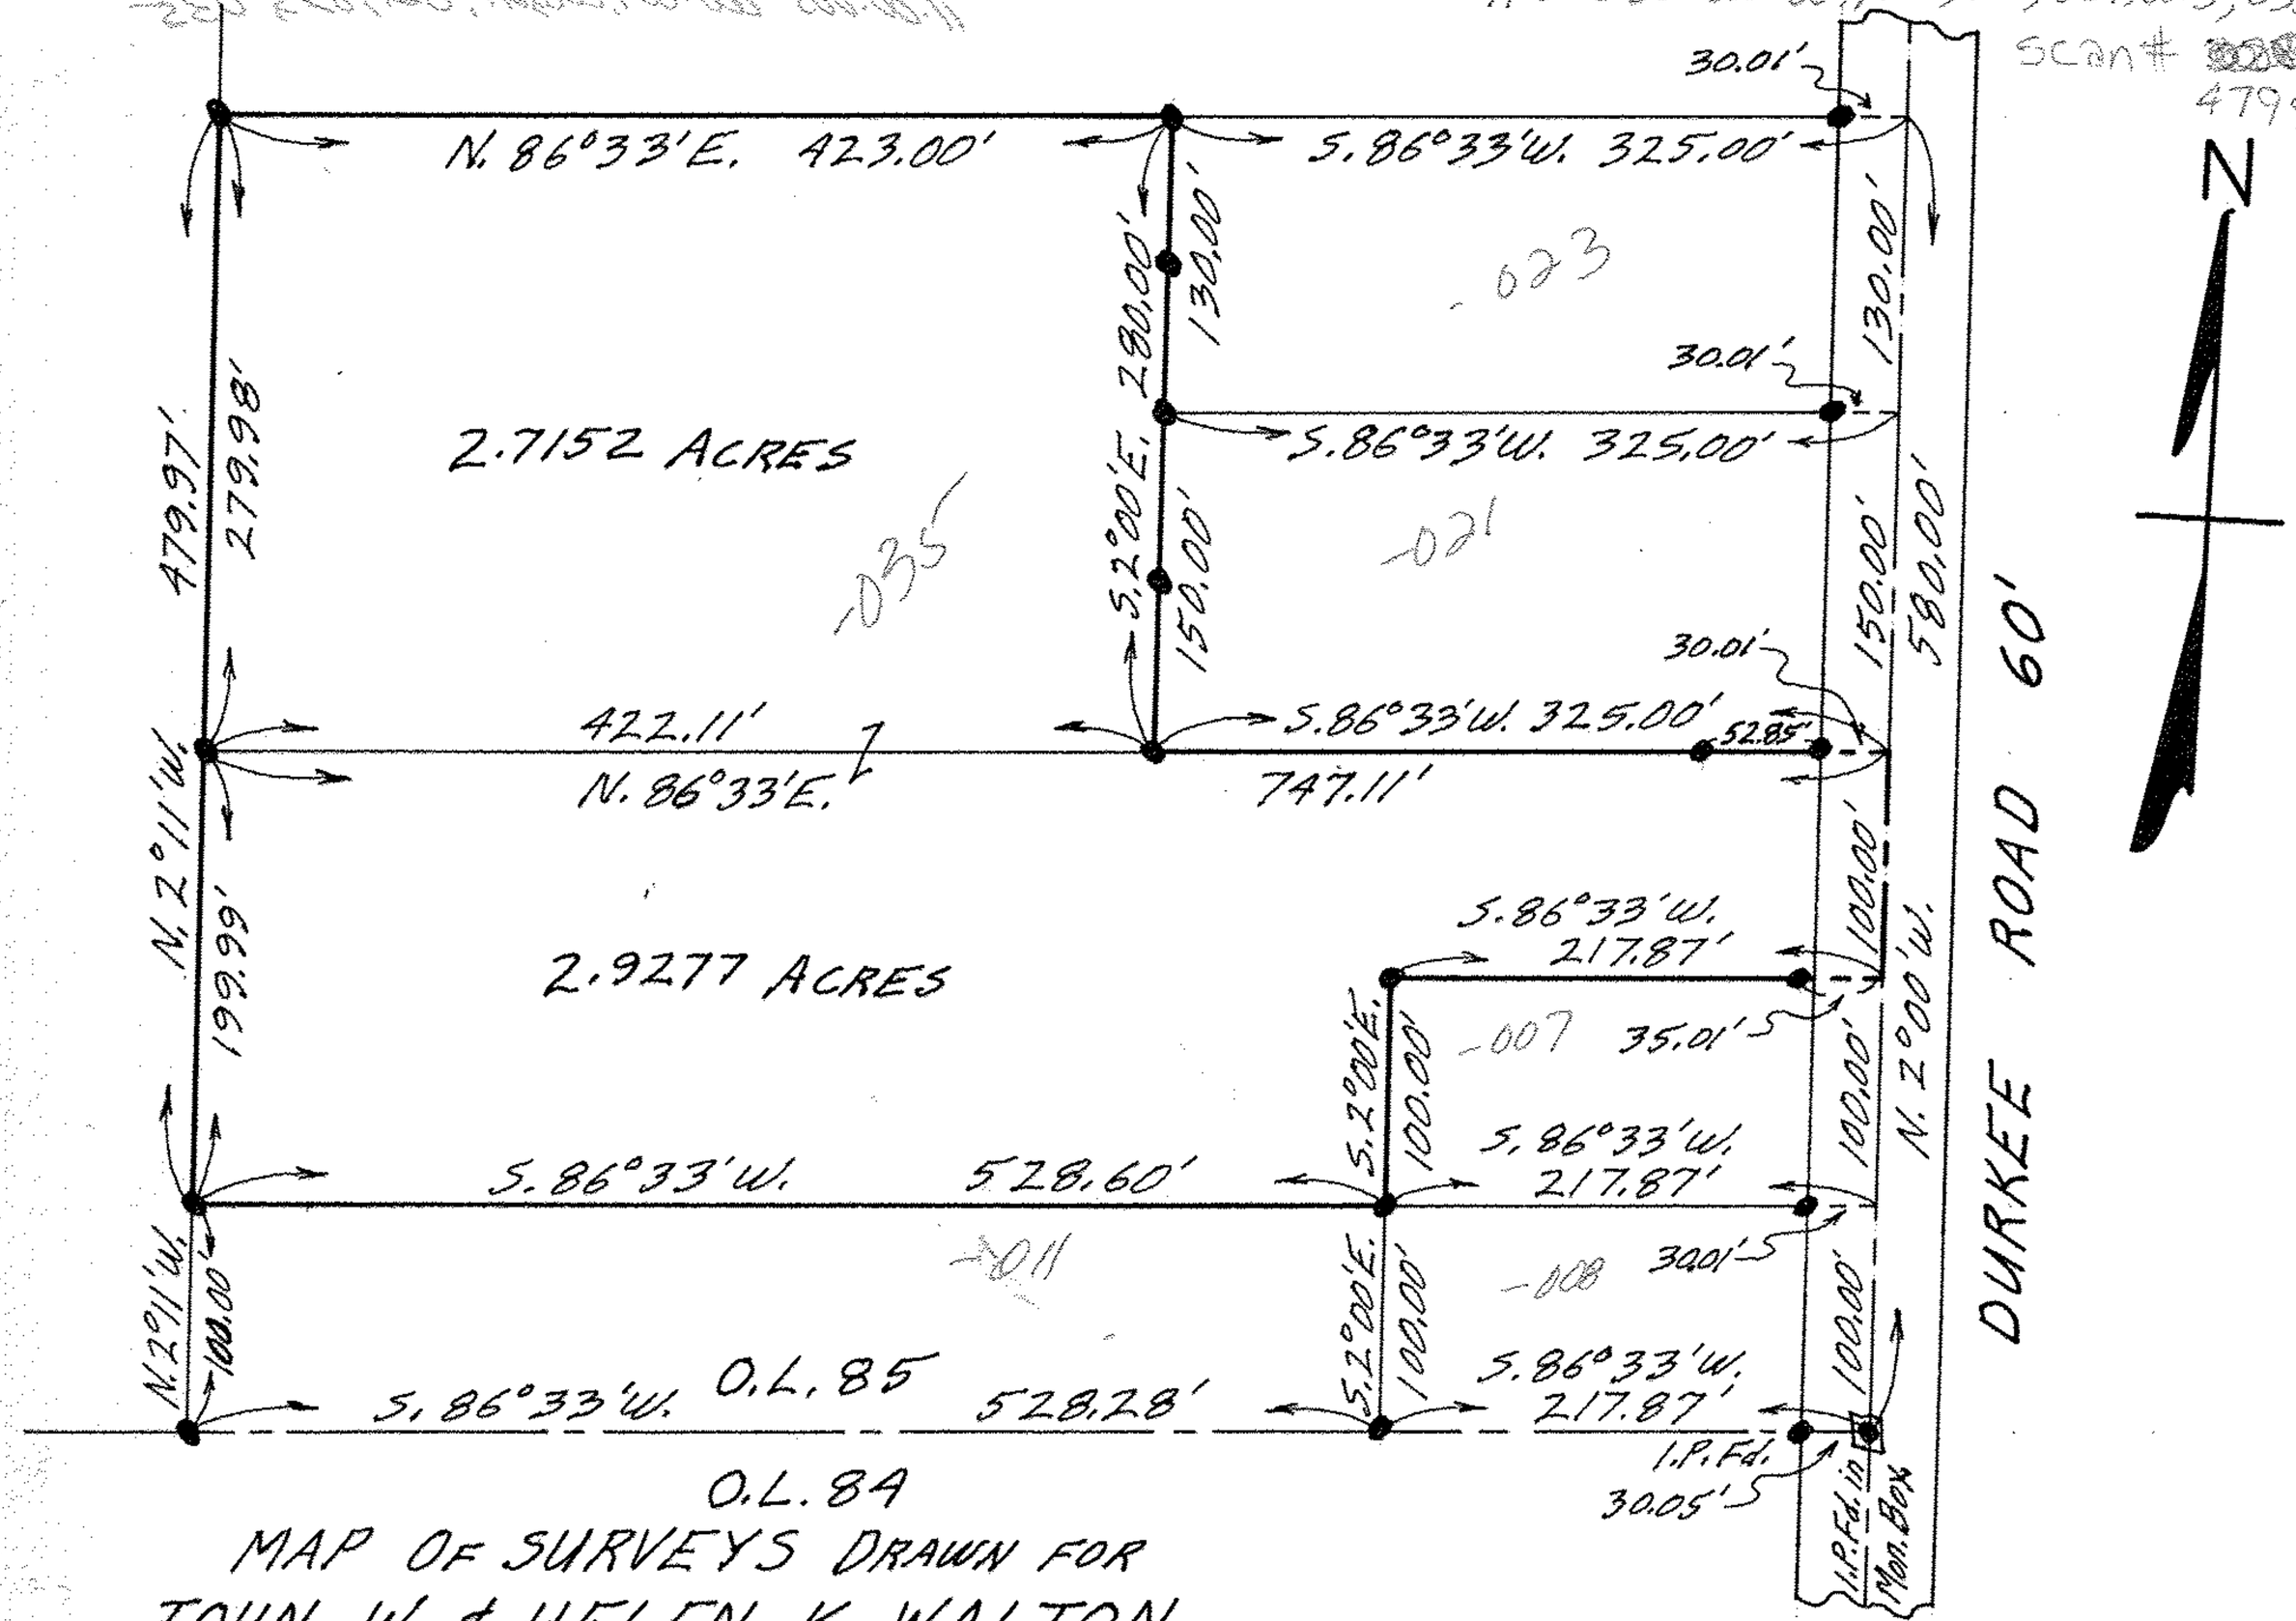

MAP OF SURVEYS DRAWN FOR
JOHN W. & HELEN K. WALTON
ORIGINAL LOT 85 EATON TOWNSHIP
LORAIN COUNTY OHIO
Gary E. Penfound Reg. Surveyor No. 4457

NOTE: ● indicates iron pin set unless otherwise designated.
SCALE: 1"=100'