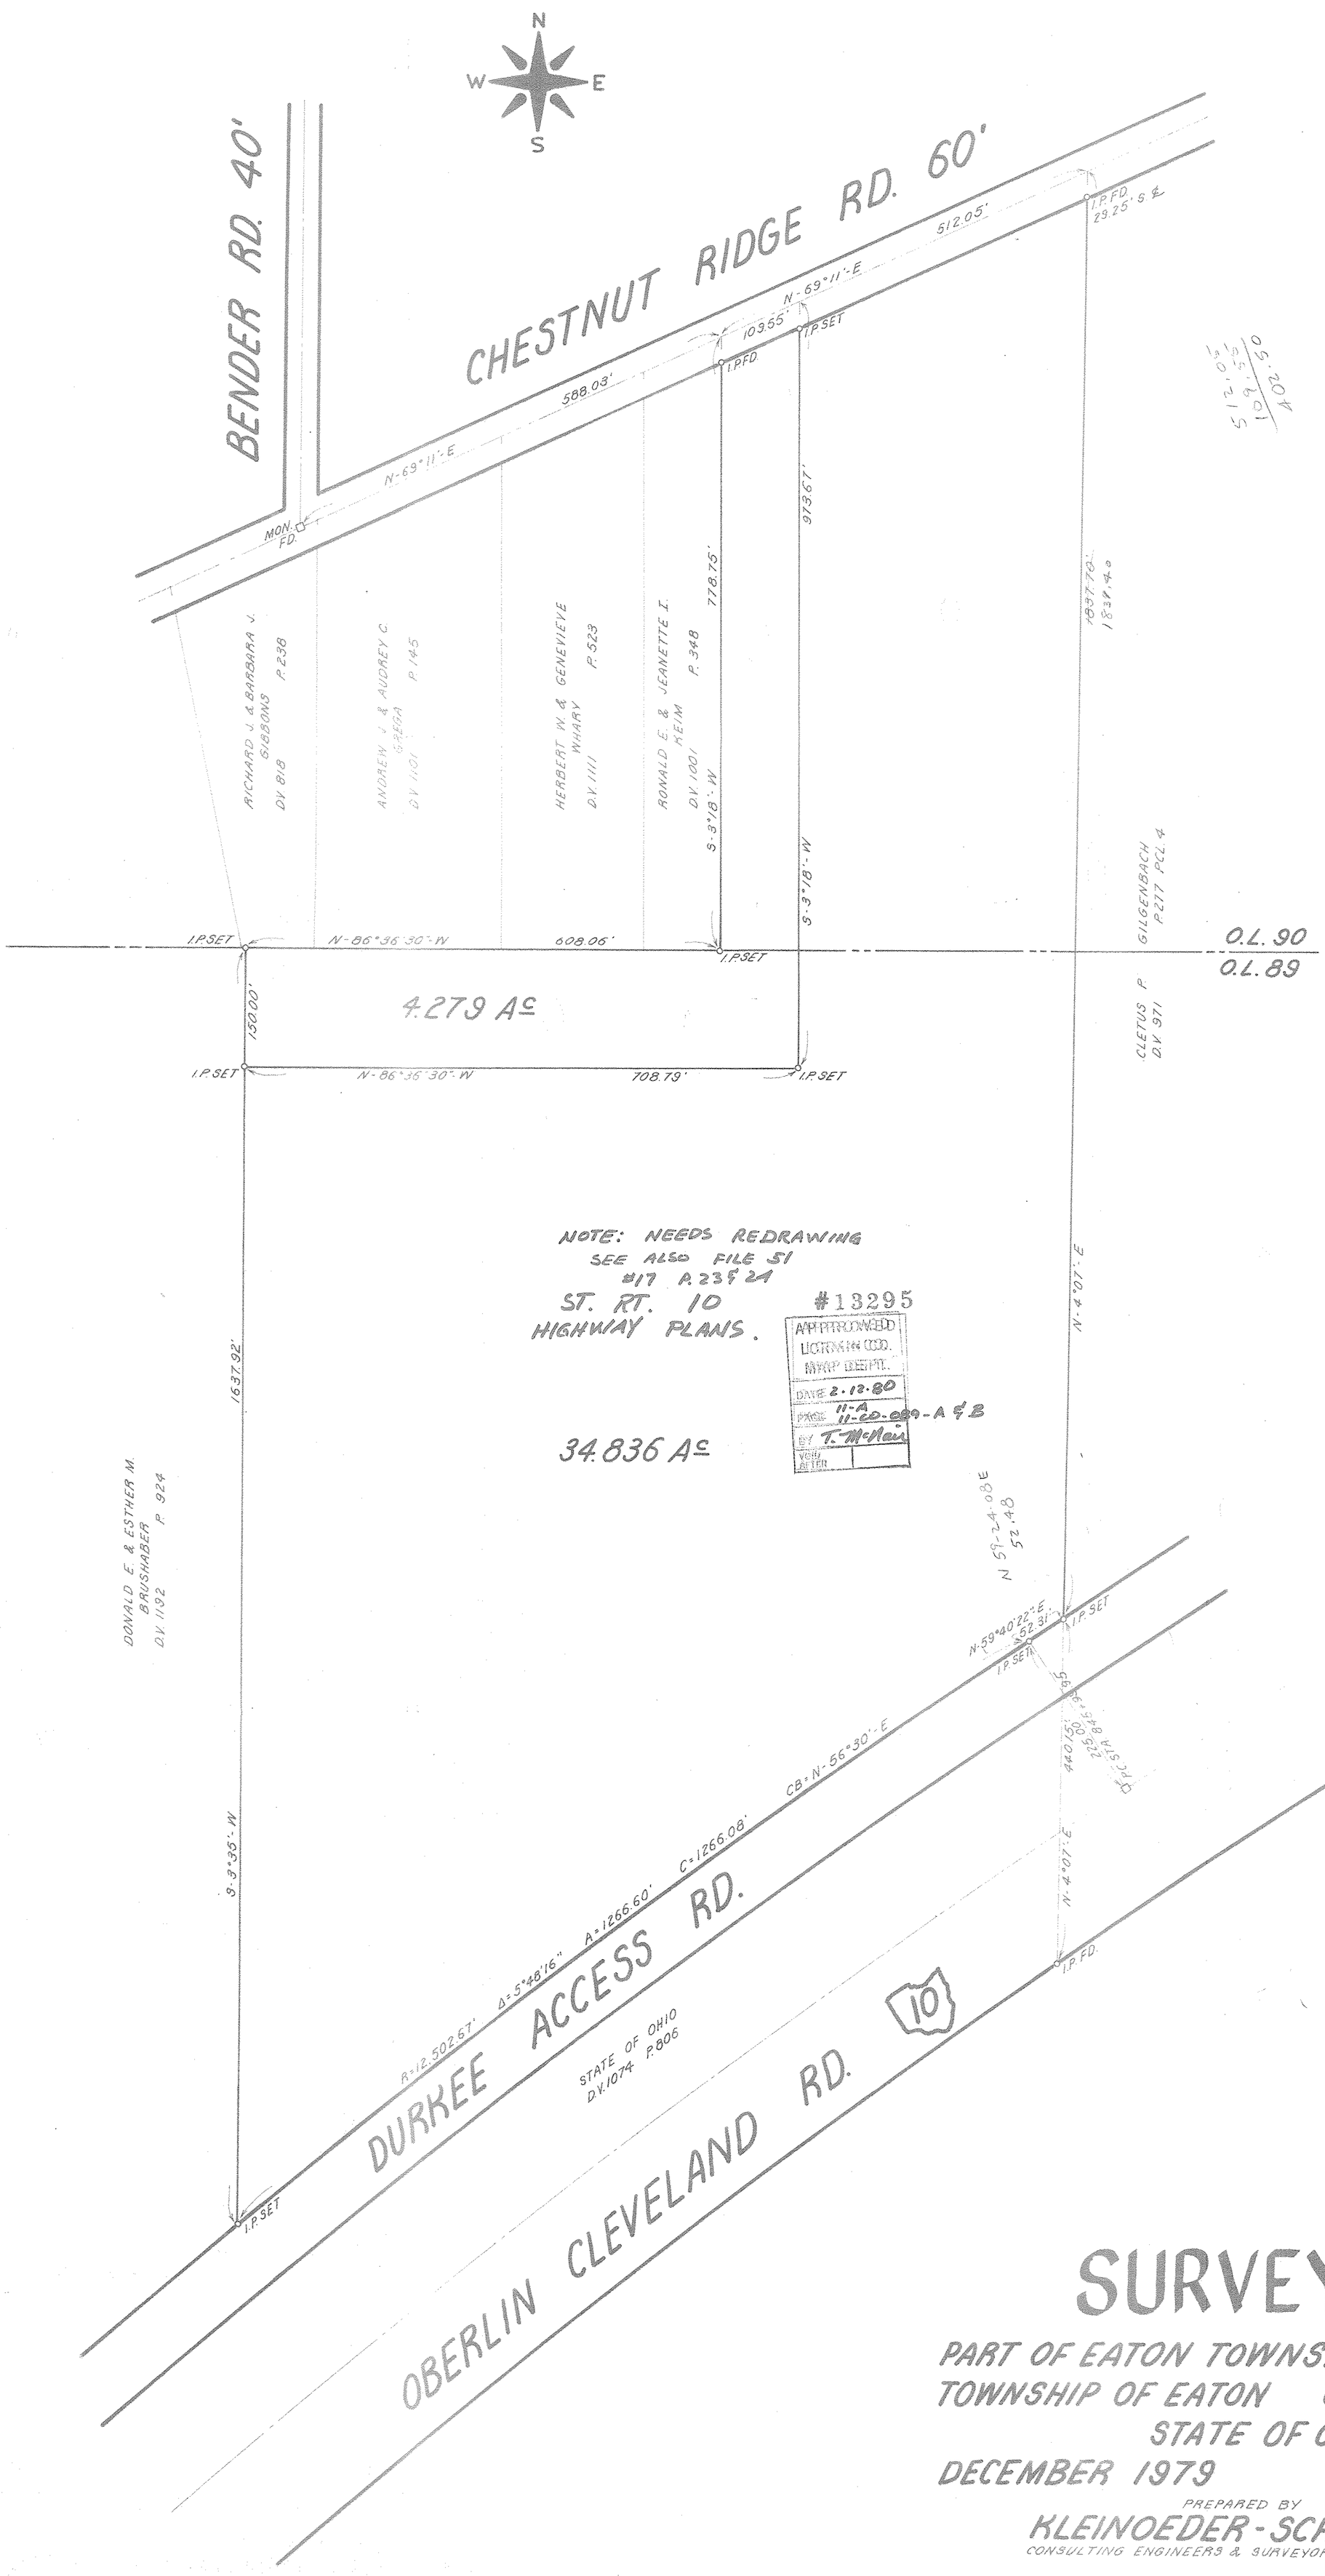

SURVEY

PART OF EATON TOWNSHIP O.L. NO. 89 & 90
TOWNSHIP OF EATON COUNTY OF LORAIN
STATE OF OHIO

DECEMBER 1979 SCALE: 1"=100'

PREPARED BY
KLEINOEDER-SCHMIDT & ASSOC.
CONSULTING ENGINEERS & SURVEYORS 424 MIDDLE AVE. ELYRIA, OH.

79-328

Scan # 47993

L.V.M. 12-18-79