11-00-092.000-032,033

Scan # 48000

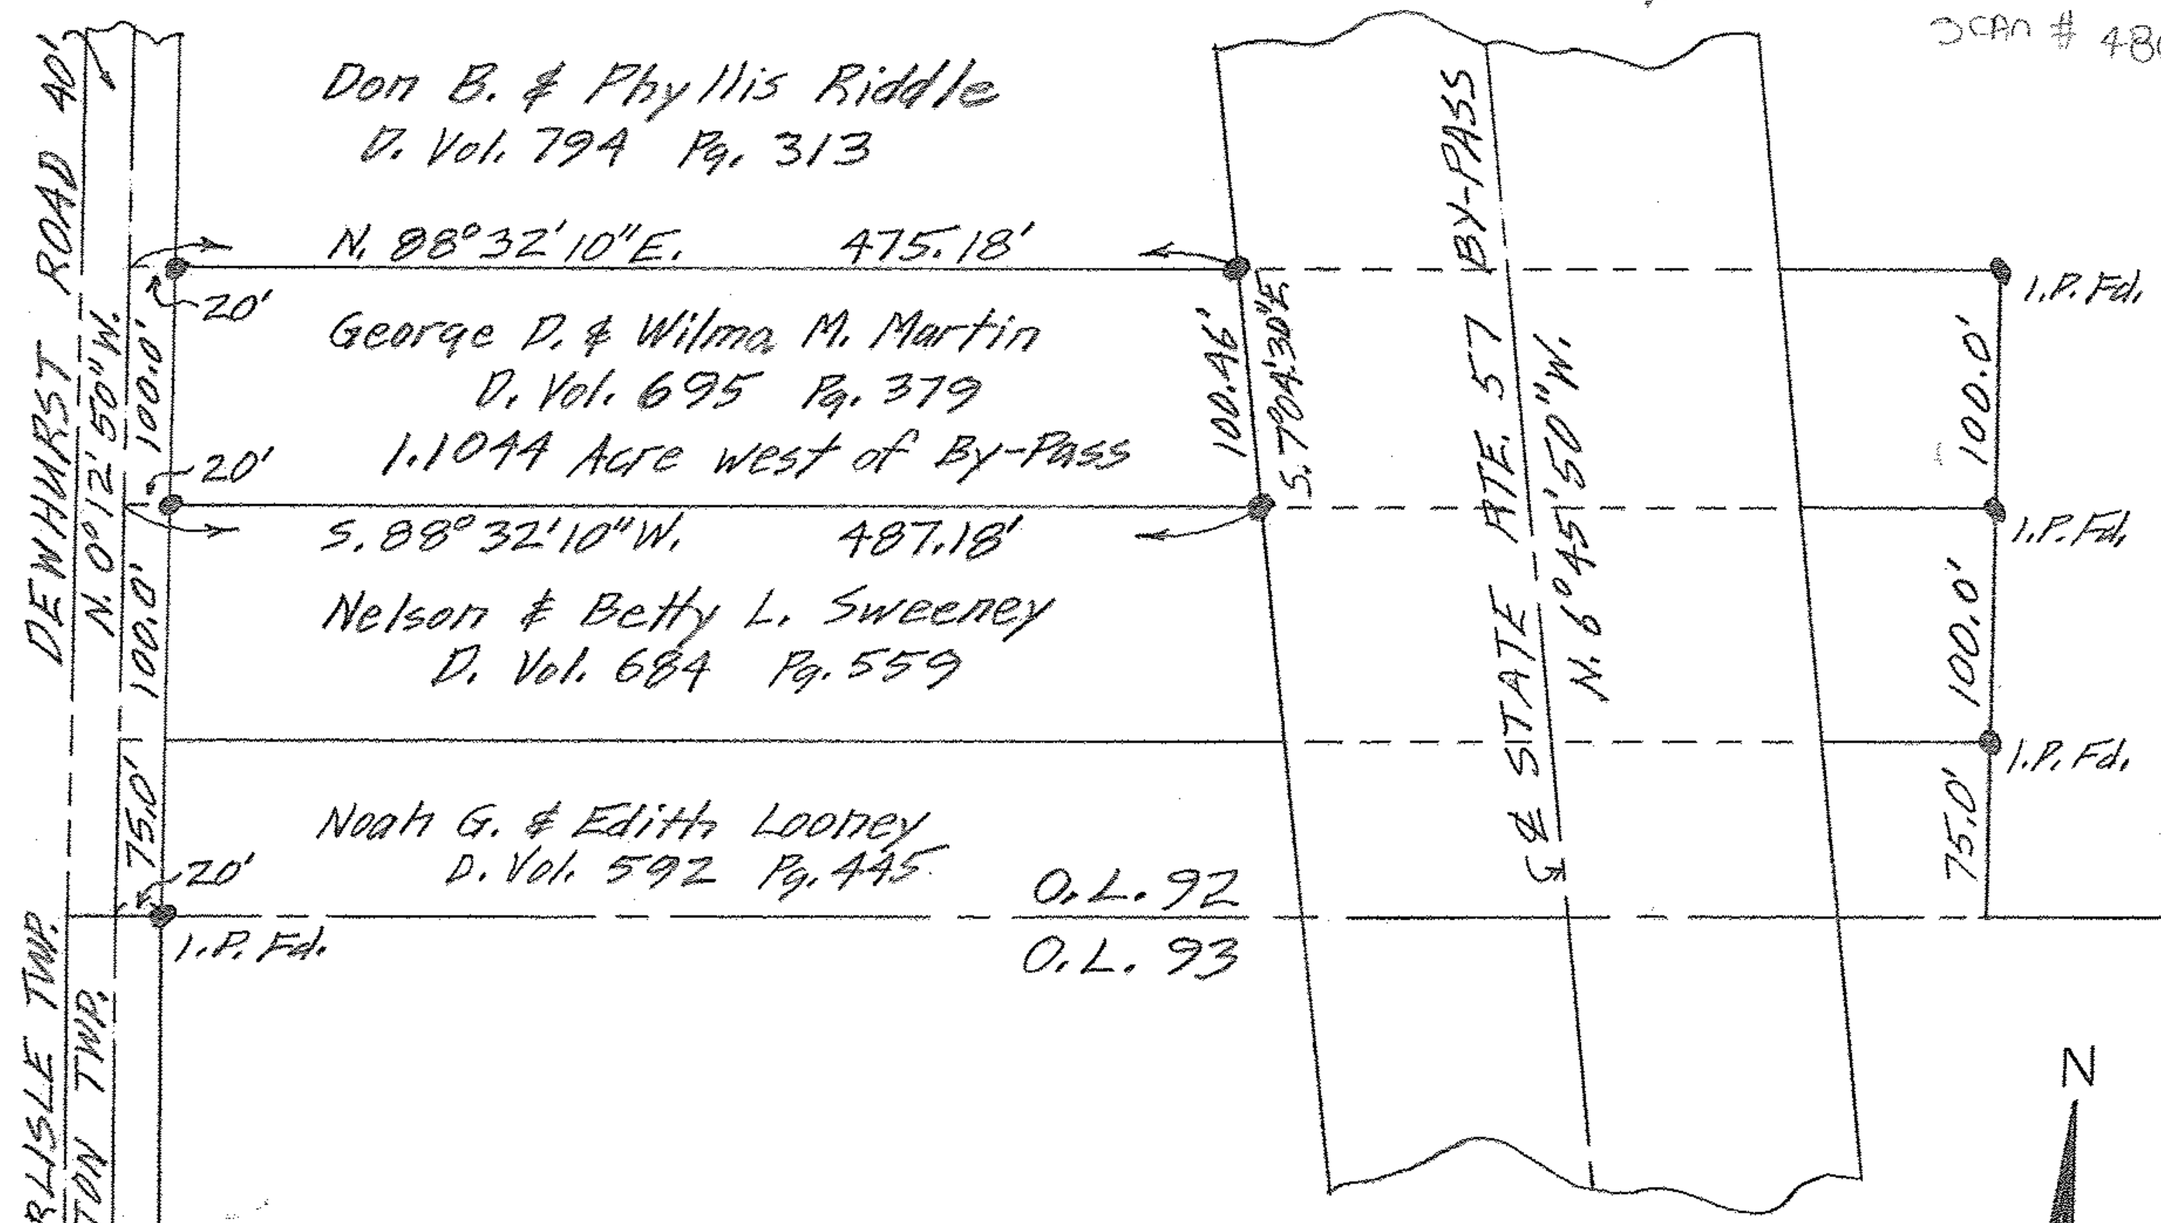

PLAT OF SURVEY FOR
GEORGE D. & WILMA M. MARTIN
PART OF ORIG. LOT 92 EATON TOWNSHIP
LORAIN COUNTY OHIO

SCALE: 1" = 100' MARCH 23-1962

Gary E. Penfound Reg. Surveyor No. 4457

NOTE: ● indicates iron pin set unless designated as iron pin found.