11-00-093-102-106
Scan # 48006

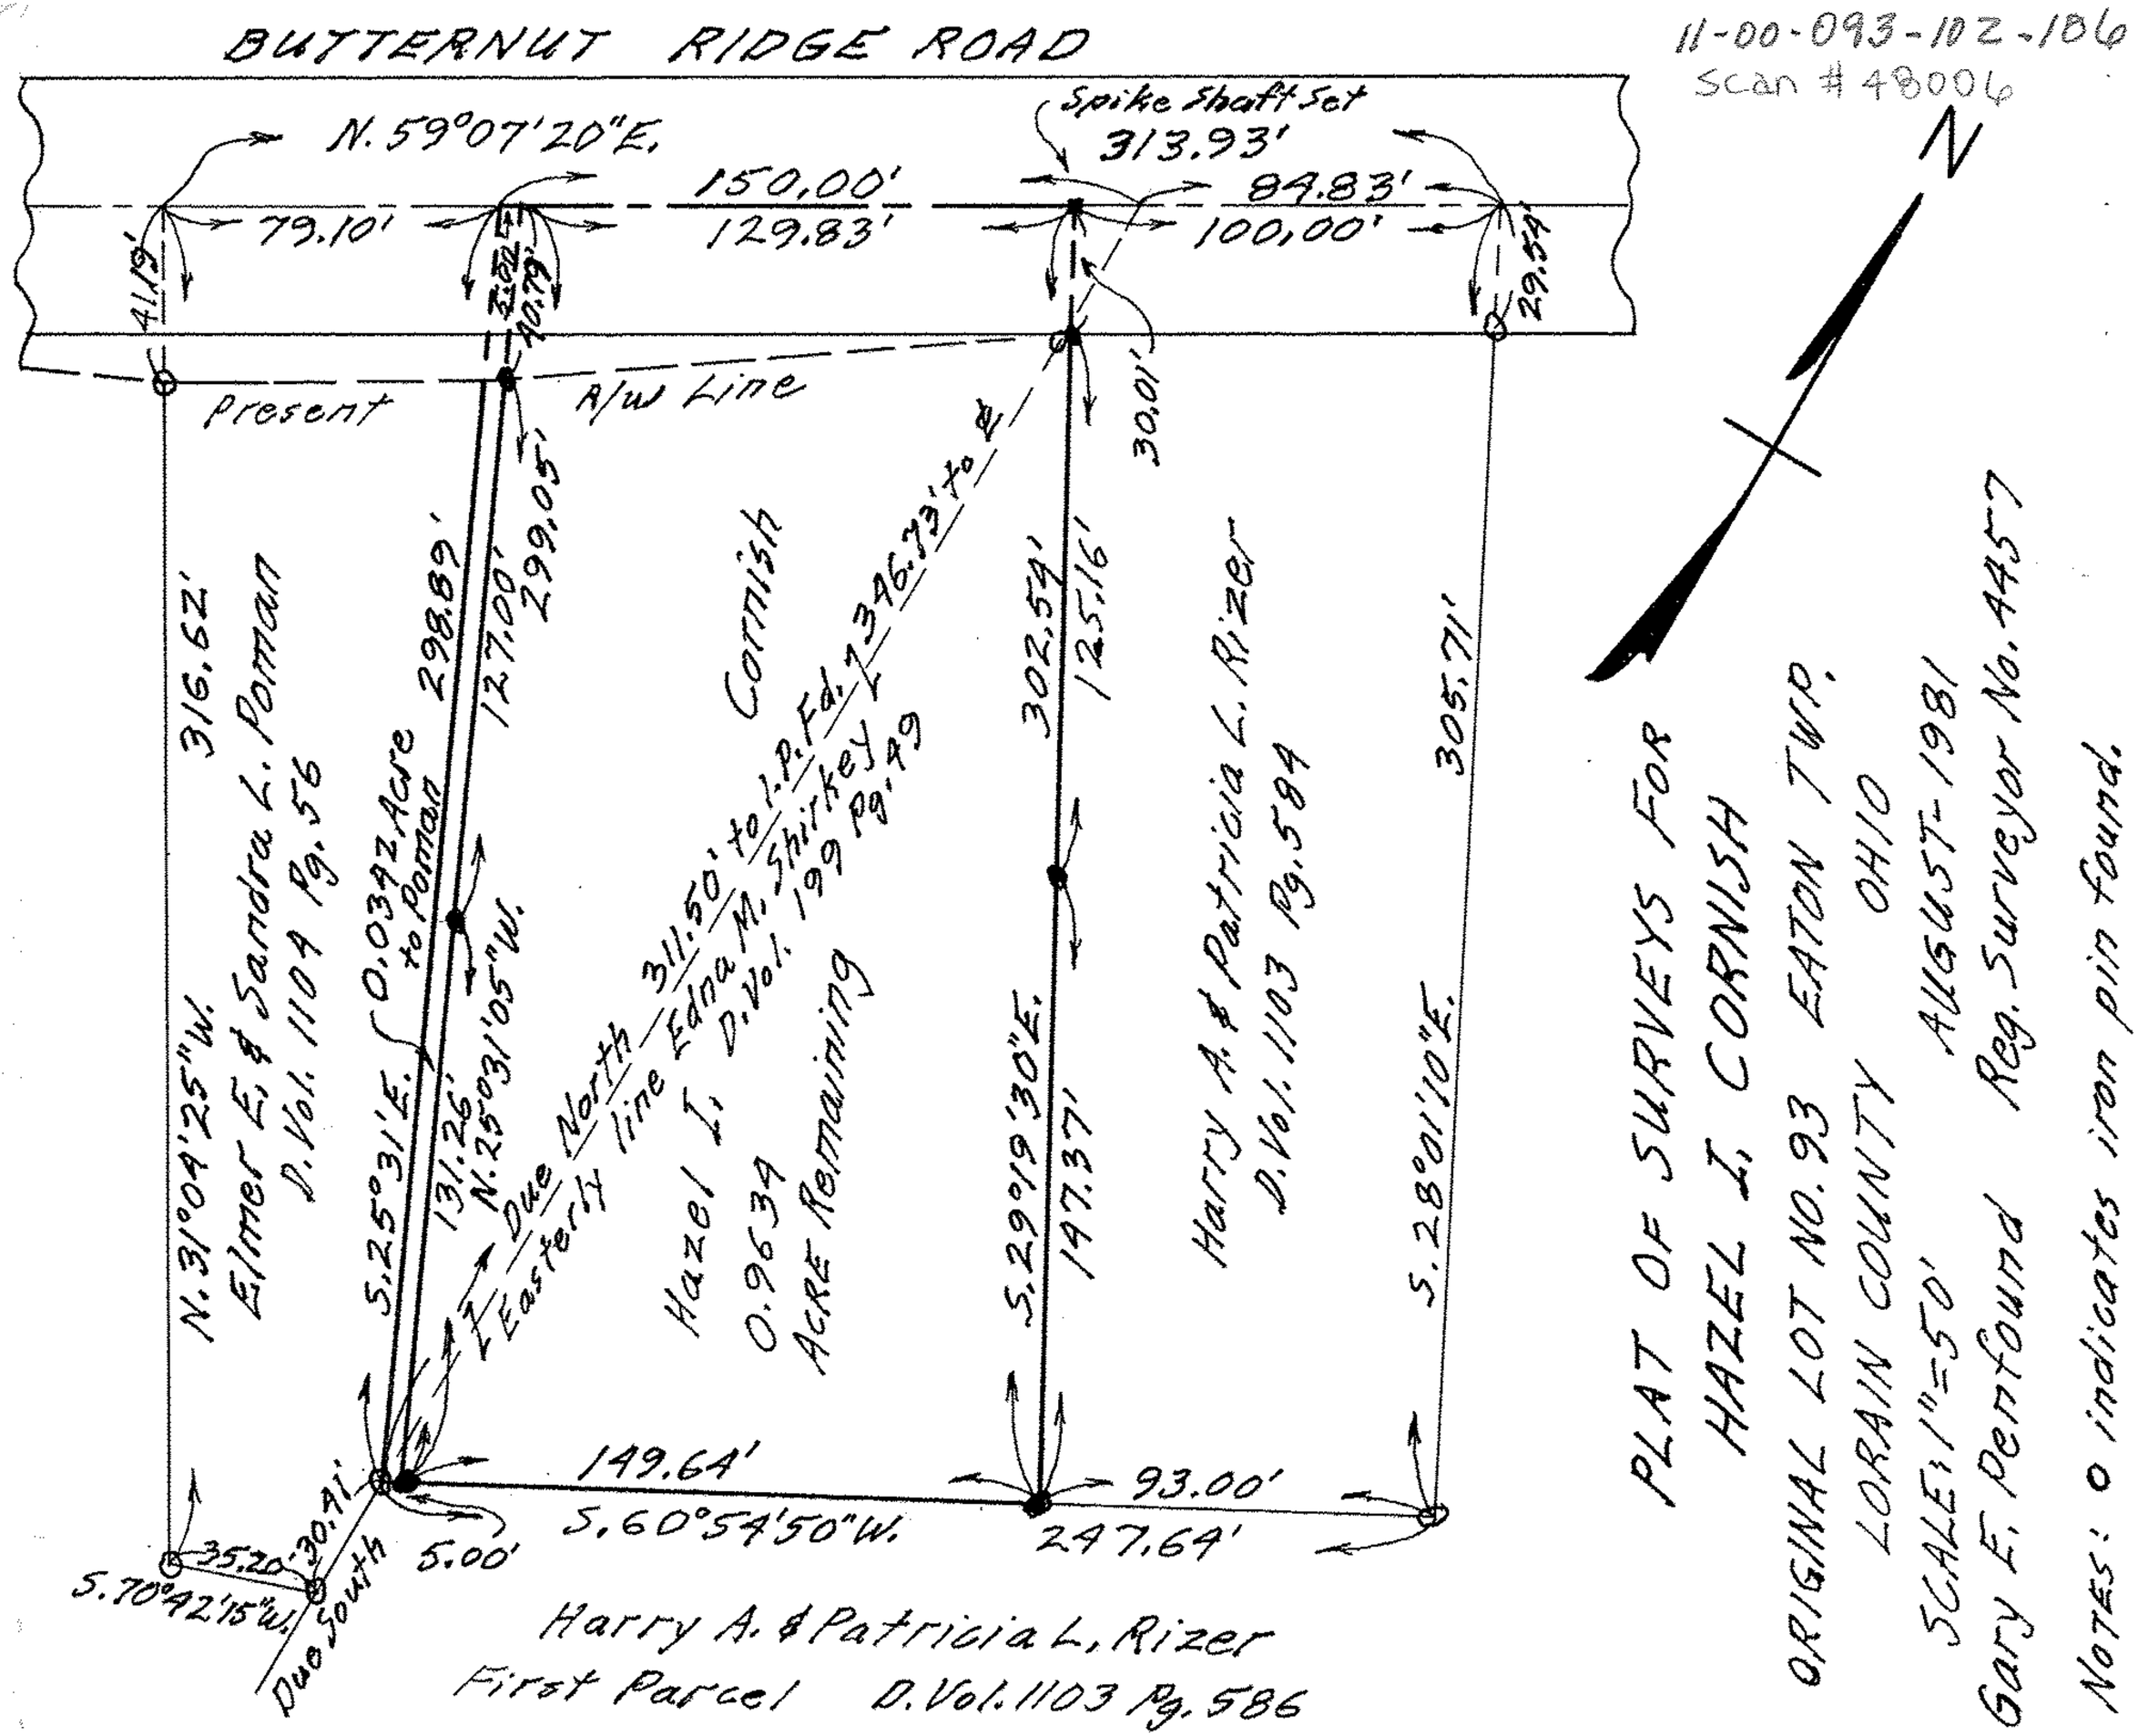

PLAT OF SURVEYS FOR
HAZEL I. CORNISH
ORIGINAL LOT NO. 93 EATON TWP.
LORAIN COUNTY OHIO
SCALE: 1"=50' AUGUST-1981
Gary E. Penfound Reg. Surveyor No. 4457

NOTES: o indicates iron pin found.
● indicates iron pin set.