


11-00-099-000-169

Scan# 48011

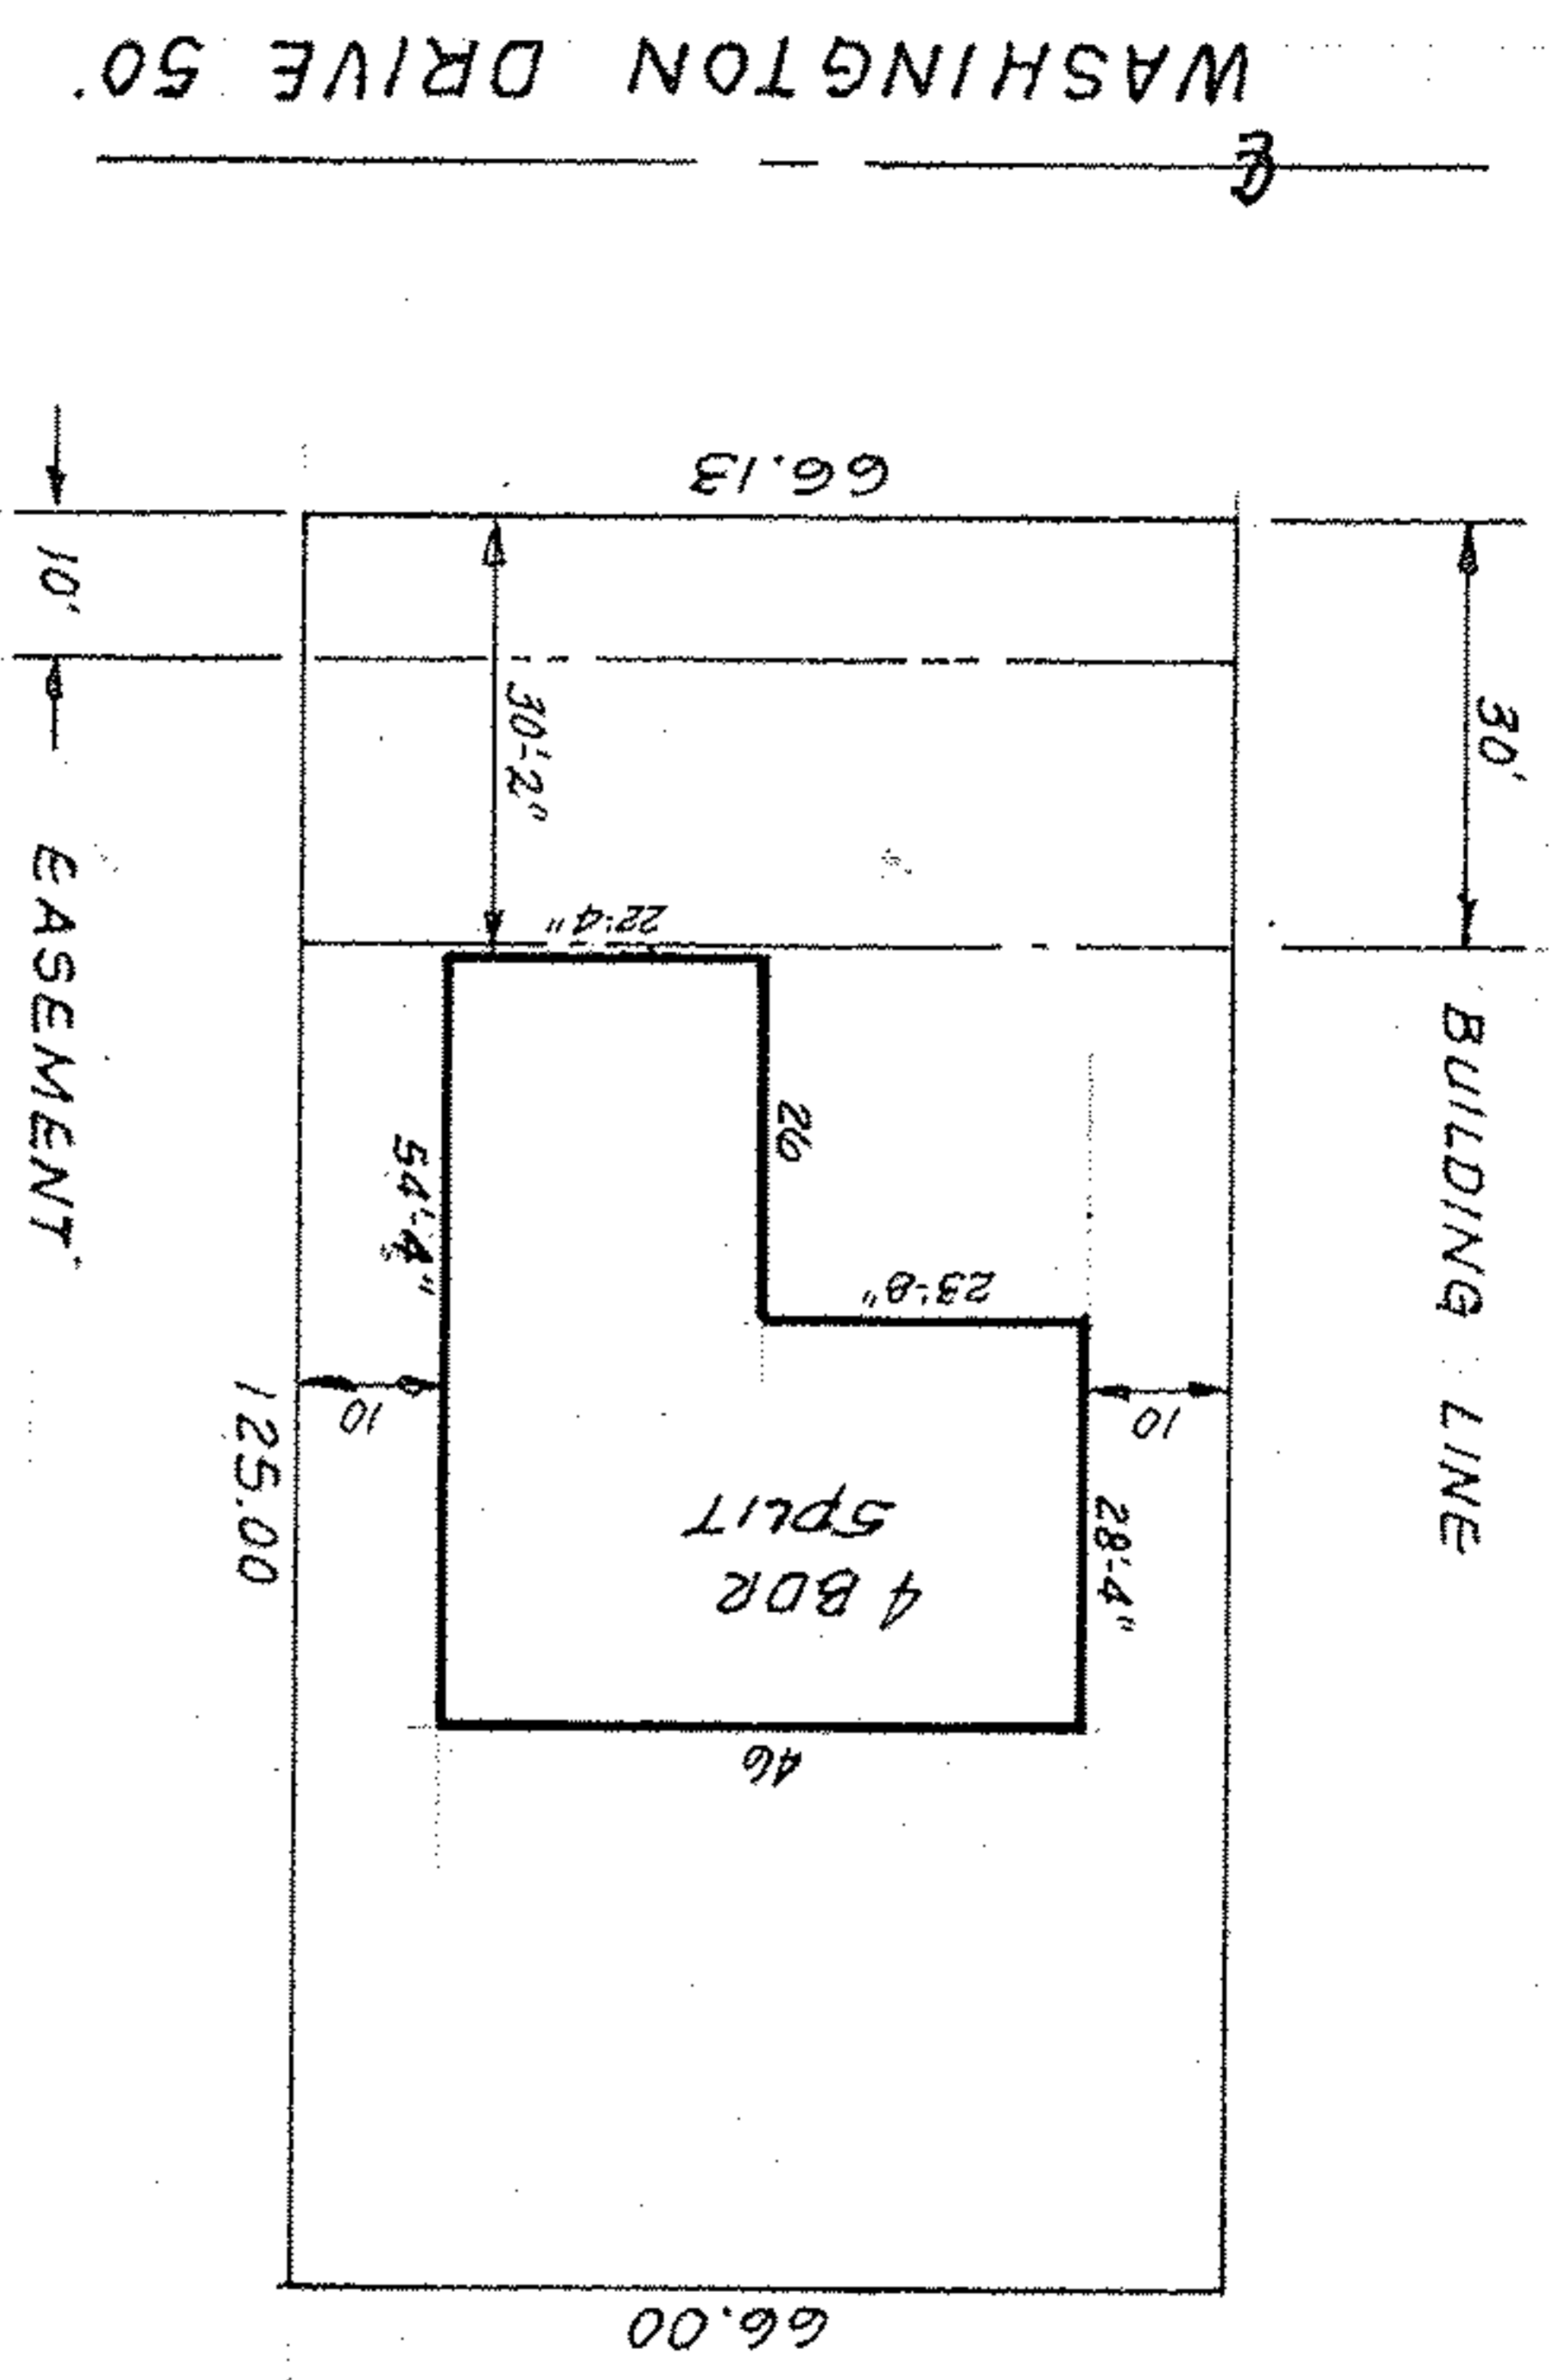

1" = 30'



P.P.# 11-00-099-000-169

SUBLOT #98 of NEW ENGLAND ESTATES NO.3

PLAT VOL. 30 PAGE 65
PART of ORIG. EATON TWP. LOT 99
NOW in VILLAGE of GRAFTON, OHIO

BUILDING LOCATION PLAN

FOR CHARLES E. SCHARFF

THIS IS NOT A PLAT OF SURVEY:
FOR MORTGAGE LOAN PURPOSES ONLY

MCGLINCHY & ASSOCIATES
JULY 27, 1978

MINN. T. E 20,296