


11-00-099-000-174 Scan # 48013

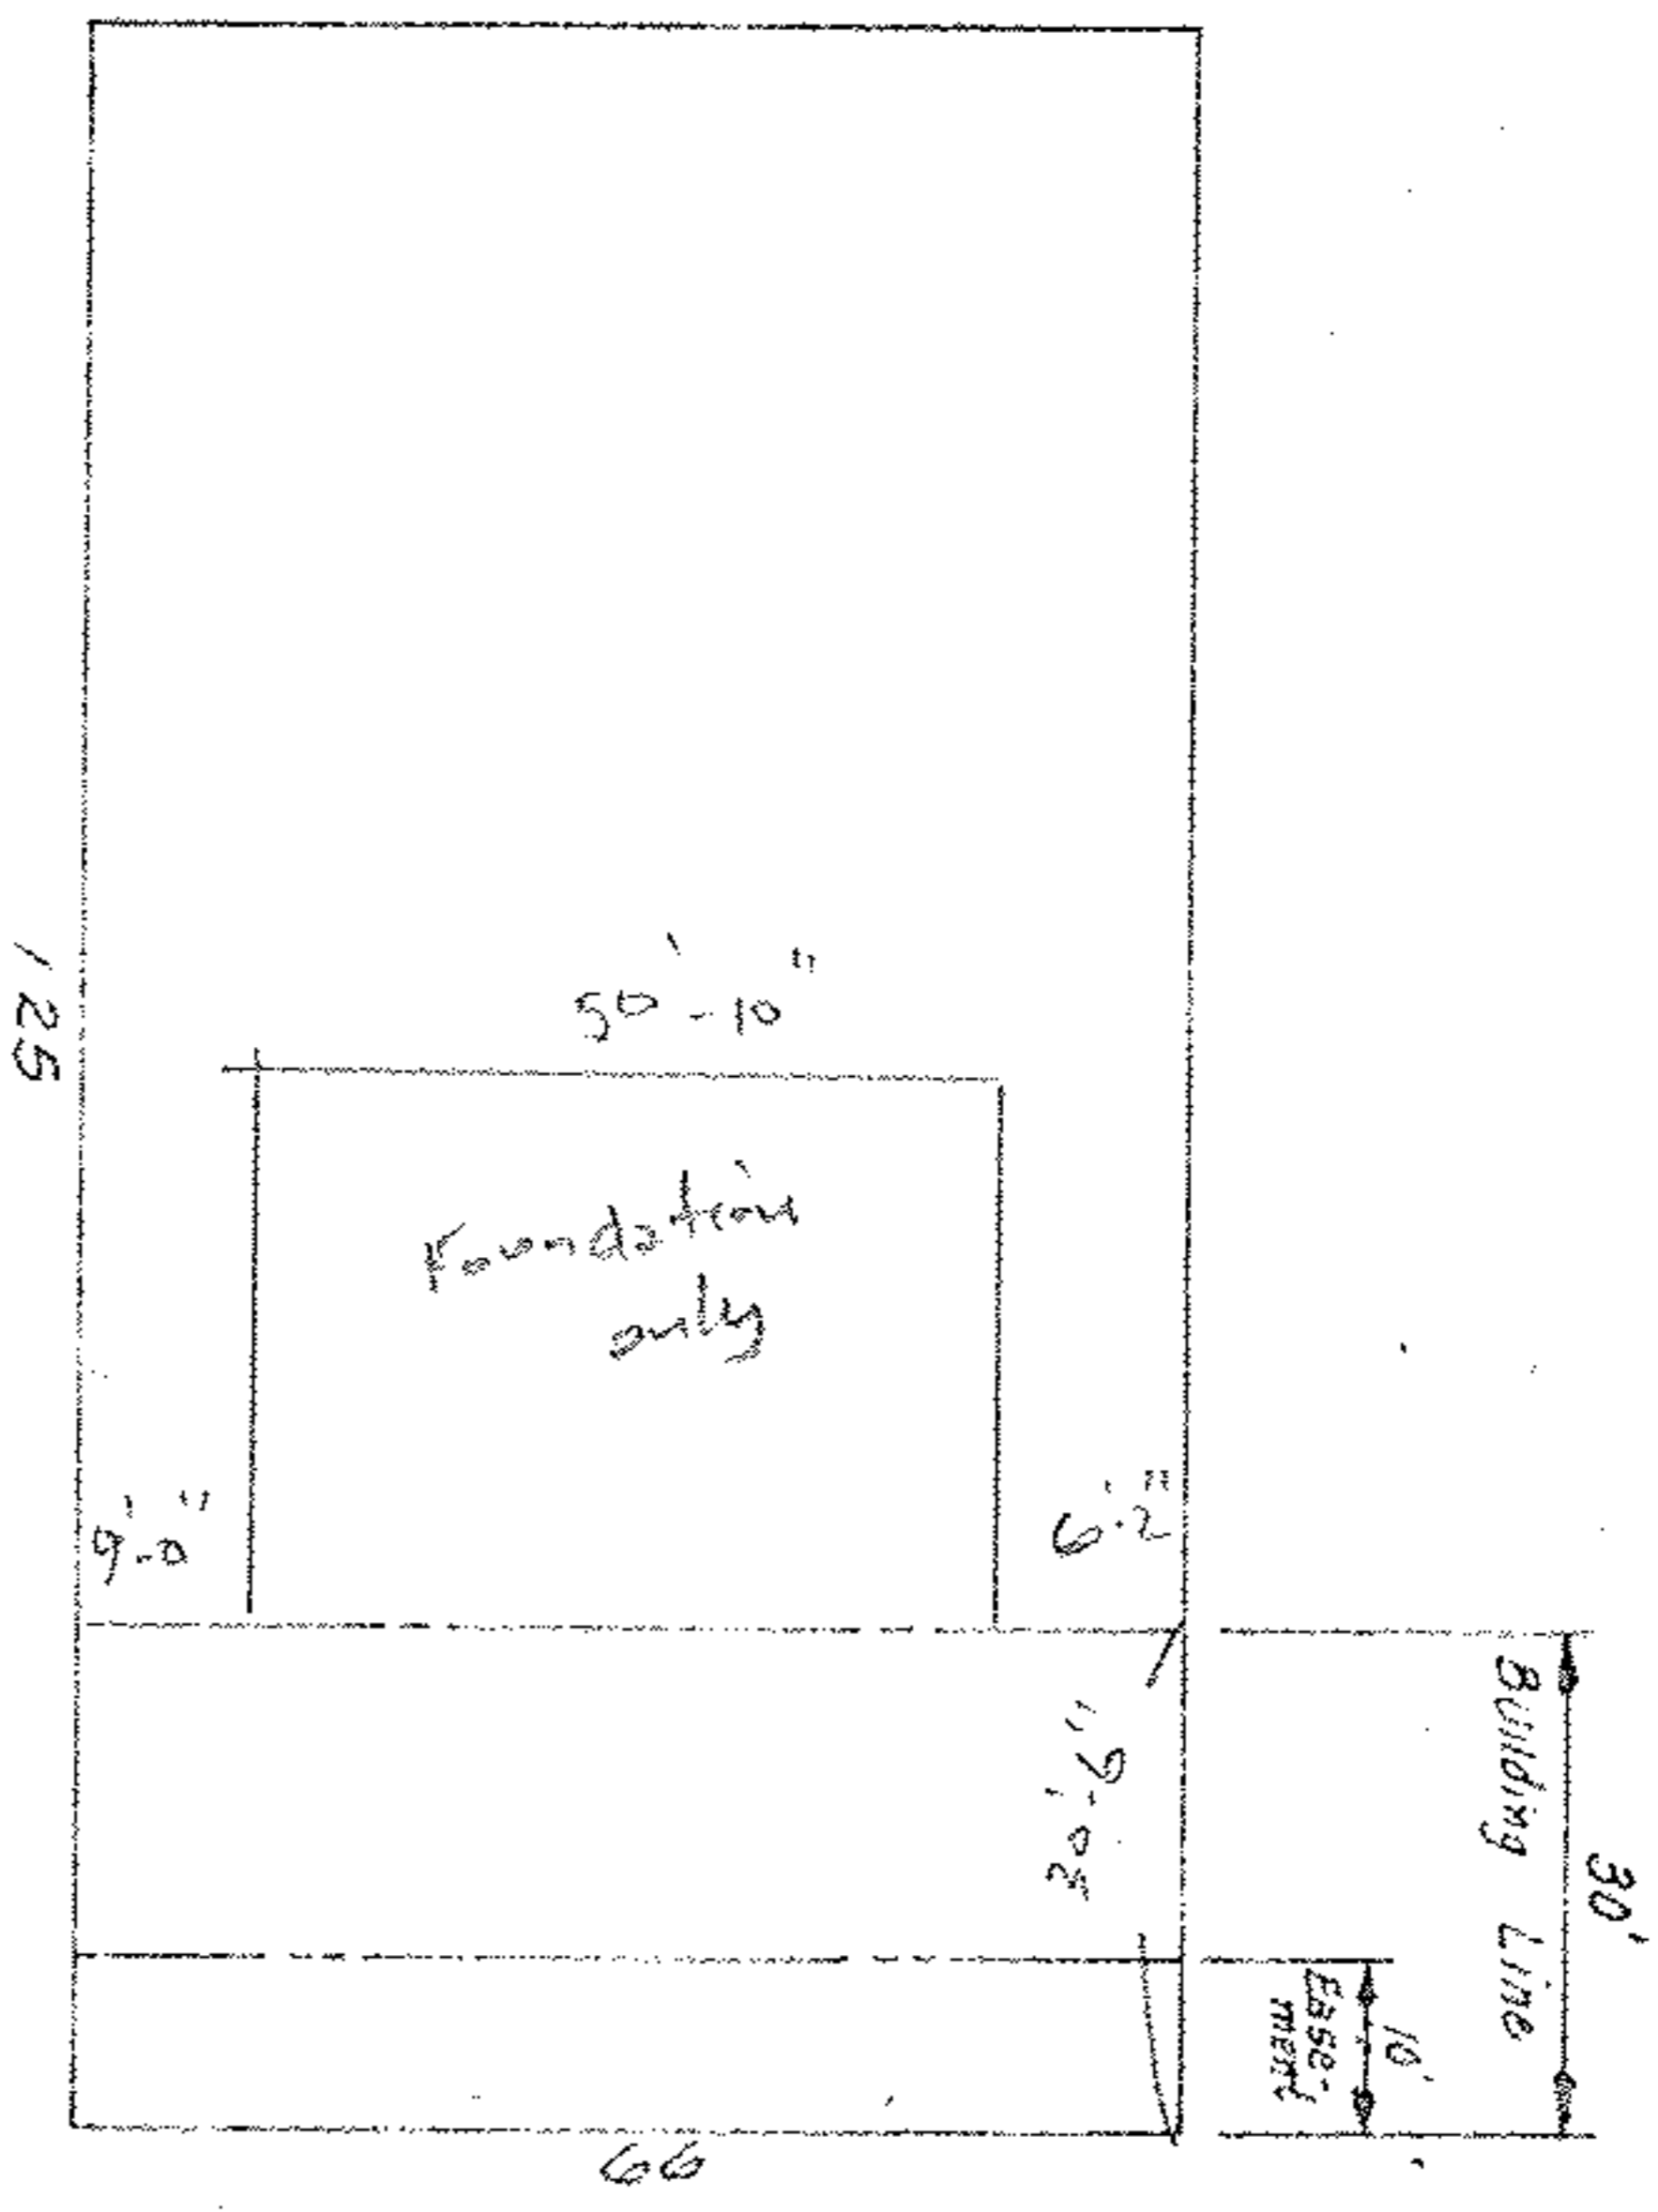

WASHINGTON DRIVE 50'



1" = 30'

SUBLOT #103 of NEW ENGLAND ESTATES SUBD'N NO. 3

PLAT VOL. 30 PAGE 65
PART of ORIG. EATON TWP. LOT 99
NOW IN VILLAGE of GRAFTON, OHIO

McGLINCHY & ASSOCIATES
NOV 1977 #772751