MAP OF SUB-LOTS NOS. 156, 157 & 158
WEST VIEW PARK PLAT VOL. 13 PG. 1
ORIG. LOT 20 COLUMBIA TWP.
LORAIN COUNTY OHIO
SCALE: 1" = 30' MAY 18 - 1966 8:15 P.M.

Gary E. Penfound
for C.E. Penfound
REG. SURVEYORS
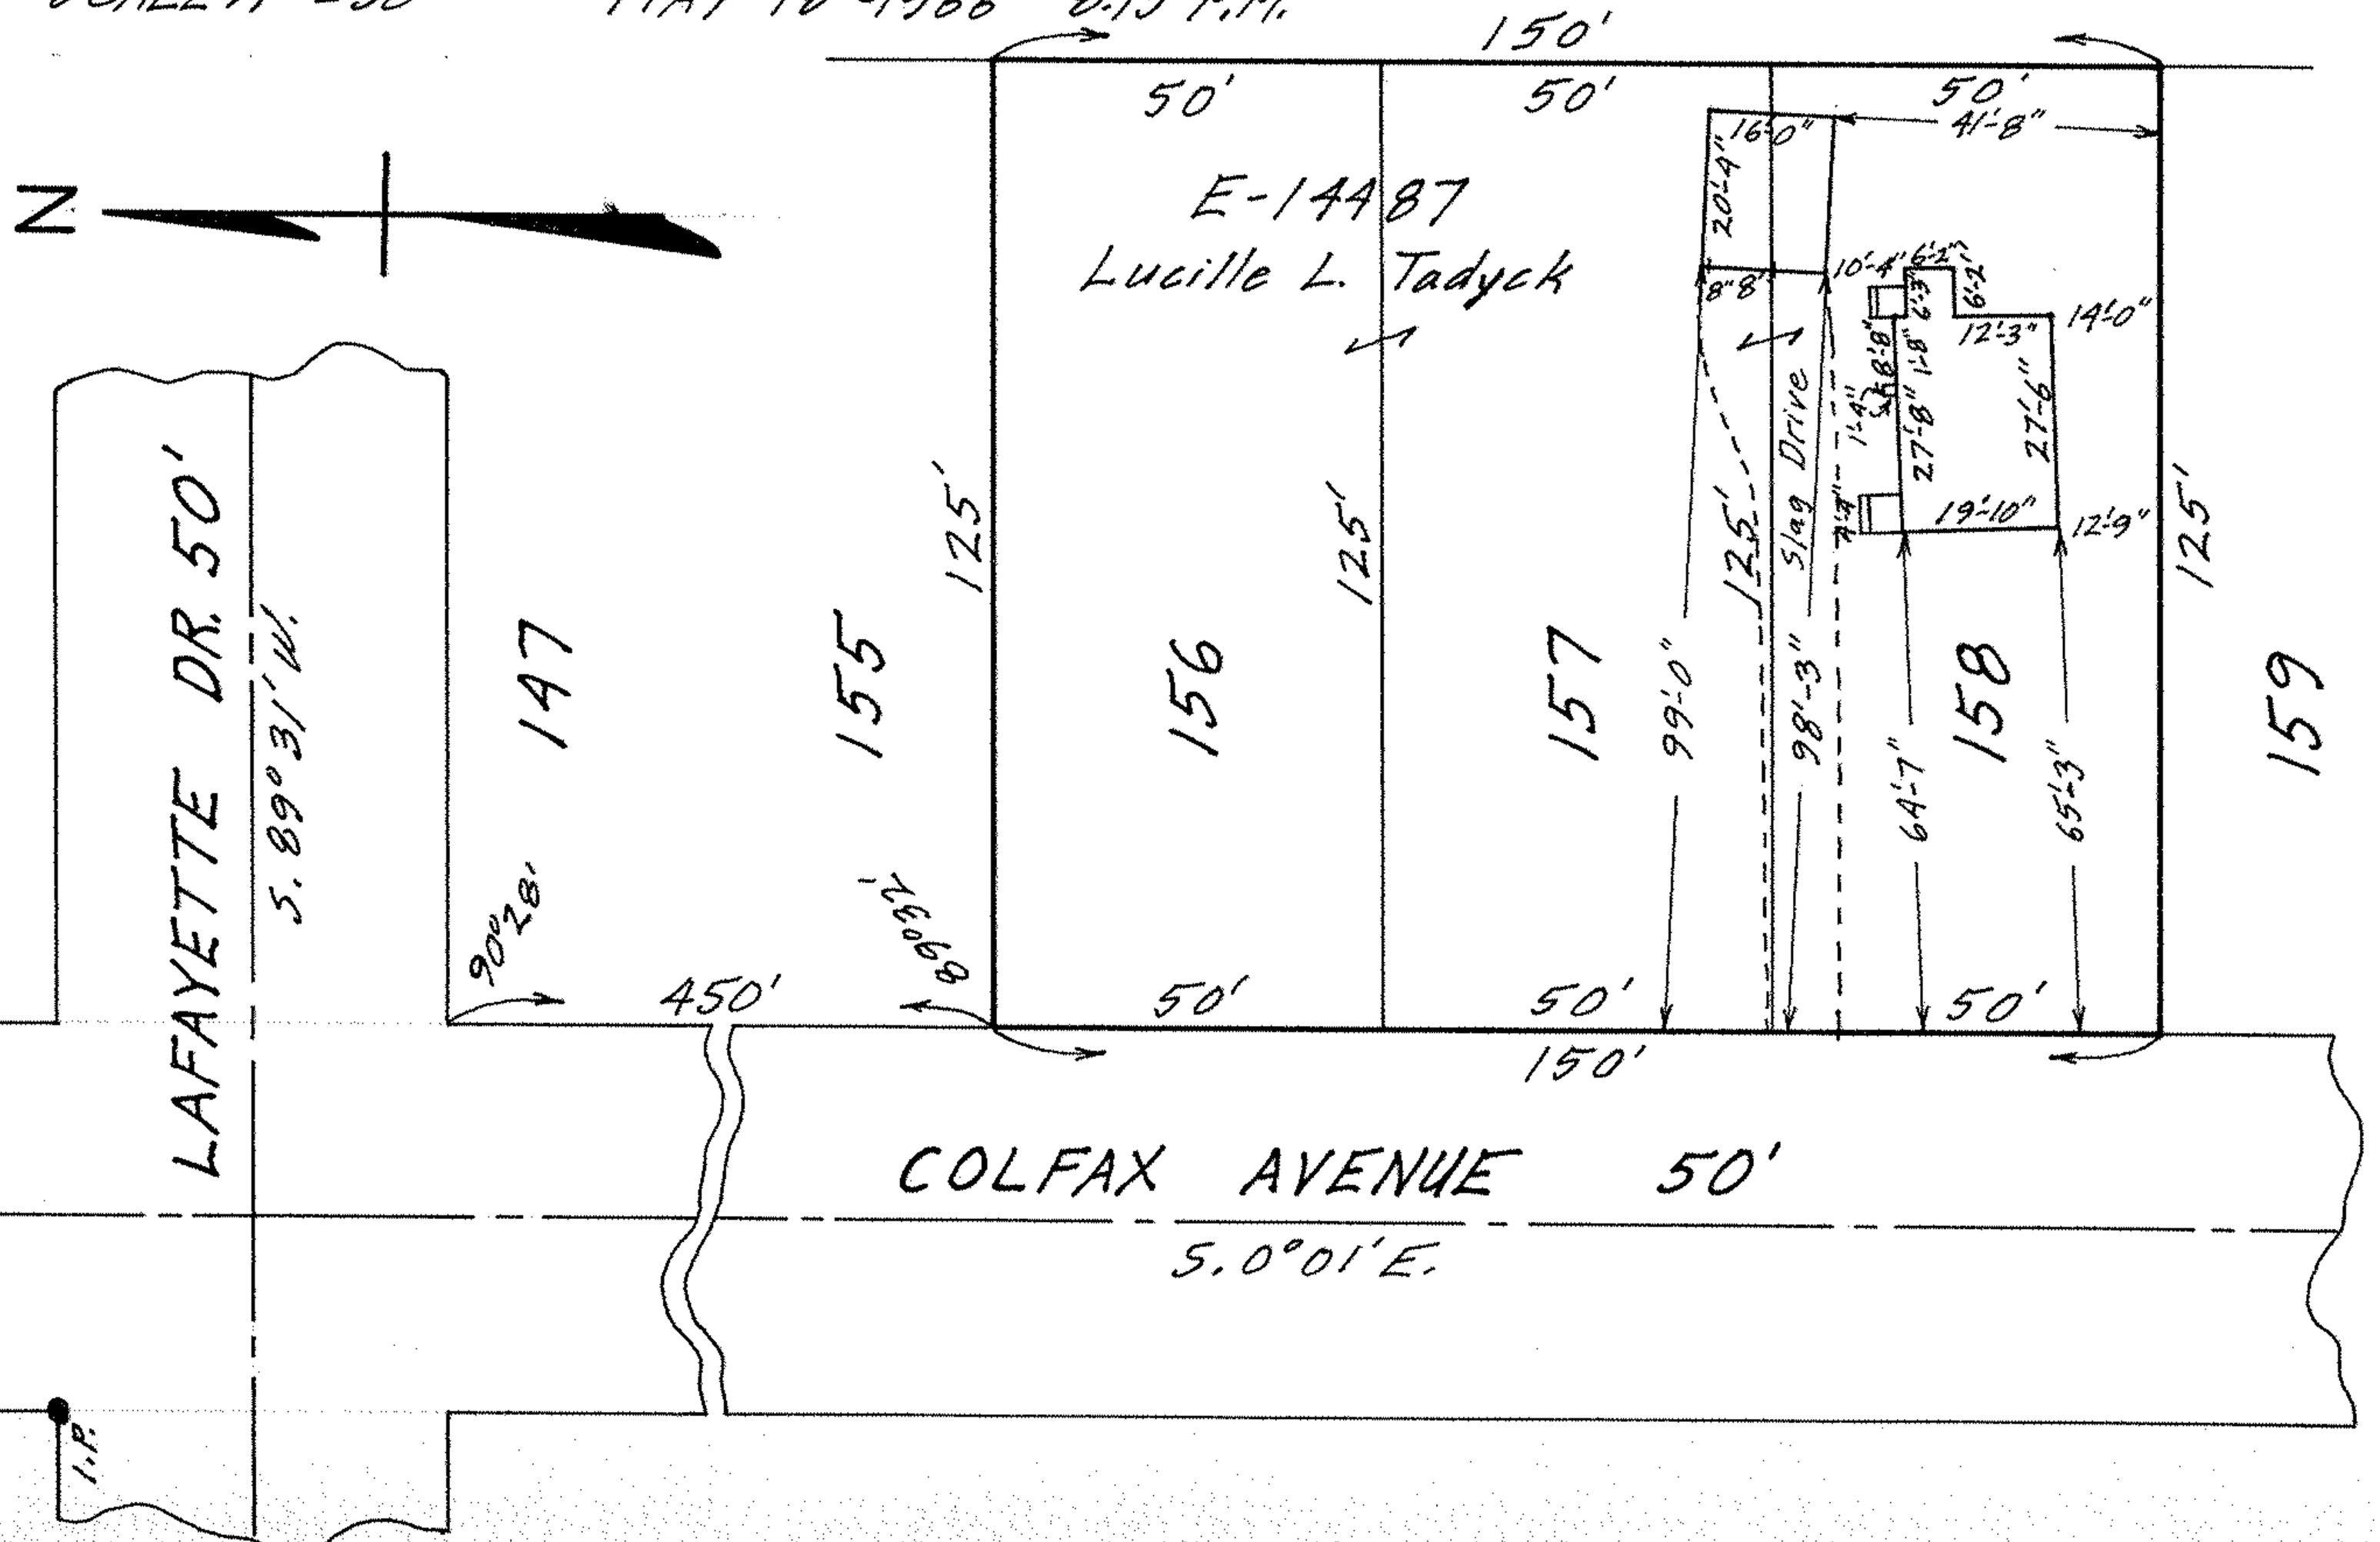
Scan # 48025