BOUNDARY & TOPOGRAPHIC SURVEY

COLUMBIA TOWNSHIP ~ LORAIN COUNTY ~ STATE OF OHIO
PART OF ORIGINAL COLUMBIA TOWNSHIP LOT NO. 21

PPN 12-00-021-105-005 ~ INSTRUMENT NO. 97-0485950

MARCH 2003

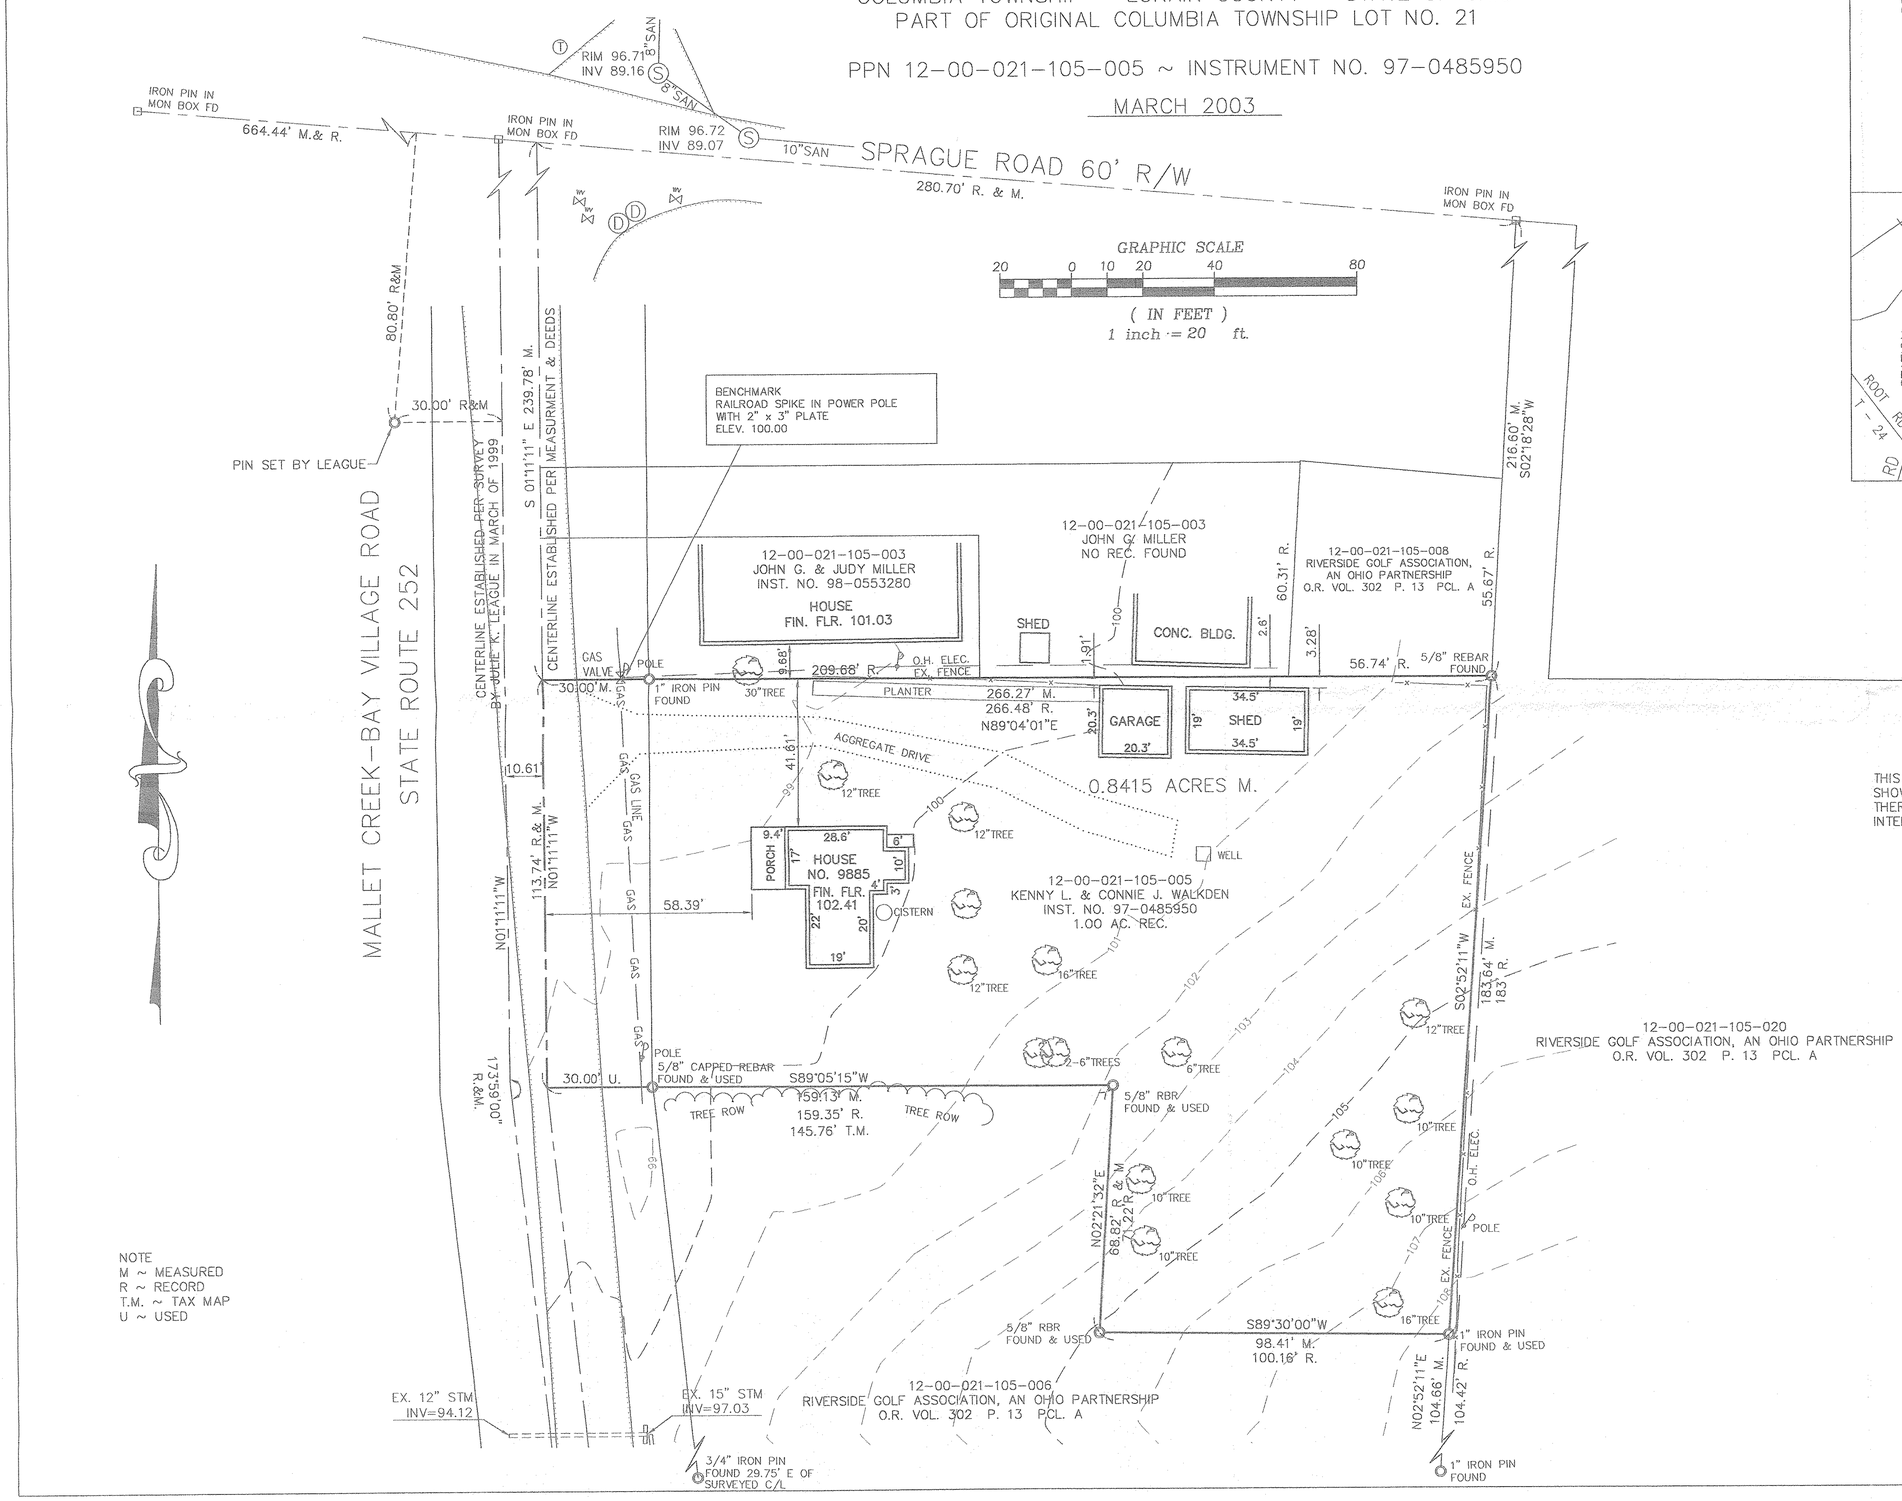

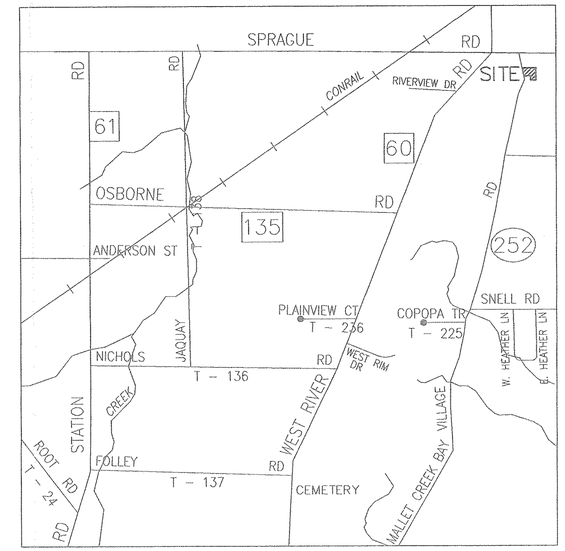

PREPARED FOR
BDC BUILDERS & DEVELOPERS
27201 ROYALTON ROAD
COLUMBIA STATION, OHIO 44028

THIS IS TO CERTIFY THAT I HAVE SURVEYED AND PLATTED THE LAND SHOWN HEREON. ALL DIMENSIONS ARE IN FEET AND DECIMAL PARTS THEREOF. ALL BEARINGS ARE TO AN ASSUMED MERIDIAN AND ARE INTENDED TO DESCRIBE ANGLES ONLY.

STATE OF OHIO
CARL R. ANDERSON
REGISTERED PROFESSIONAL SURVEYOR

3/28/03

APPROVED
LORAIN CO.
MAP DEPT
DATE 5-12-03
PAGE 12-00-021A
BY D. Holland
No 00580-A

NOTE
M ~ MEASURED
R ~ RECORD
T.M. ~ TAX MAP
U ~ USED

HAYWOOD
Civil Engineering & Land Surveying
"Committed to Service and Quality"

630 Cleveland Street
Elyria, Ohio 44035
Office: (440) 365-9831
Fax: (440) 365-3426
www.haywoodcivilengineering.com