


12 05 00 25 000 021
SCAN # 48031

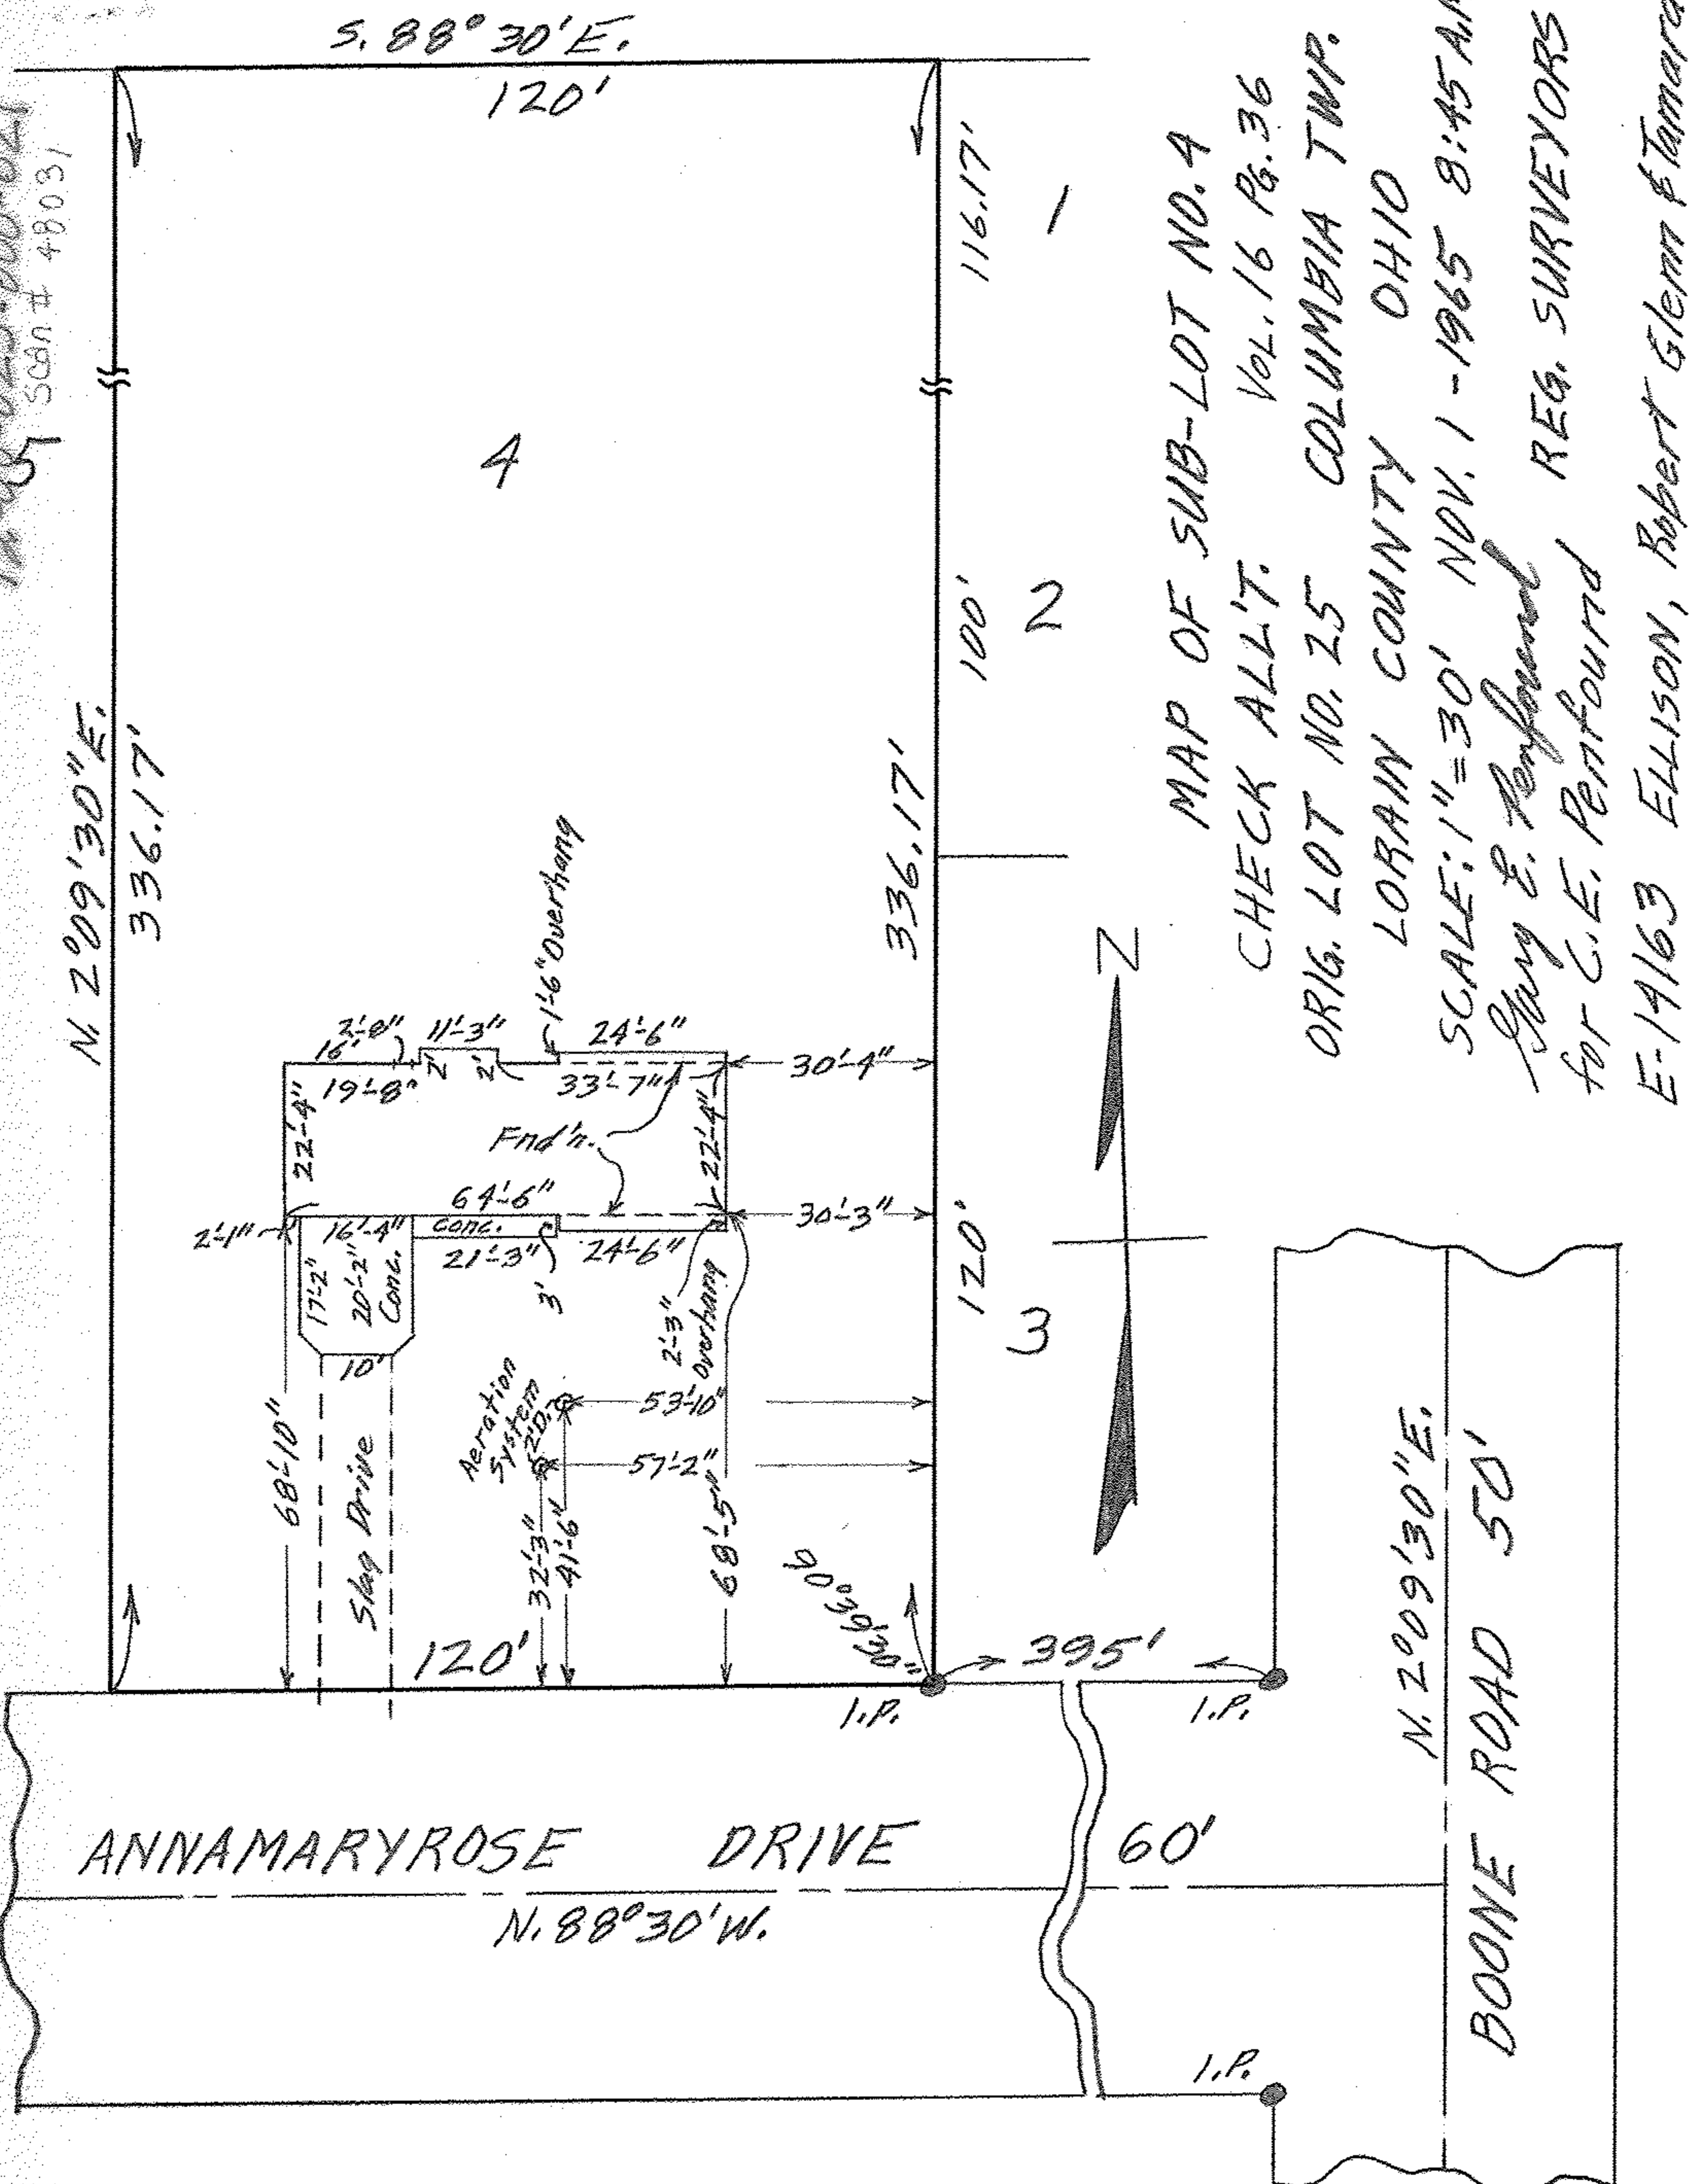

S. 88° 30' E.
120'

N. 209° 30' E.
336.17'

4

336.17'

100'

N

120'

3



MAP OF SUB-LOT NO. 4

CHECK ALL'T. Vol. 16 Pg. 36

ORIG. LOT NO. 25 COLUMBIA TWP.

LORAIN COUNTY OHIO

SCALE: 1" = 30' NOV. 1 - 1965 8:45 A.M.

Gary E. Penfound
for G. E. Penfound REG. SURVEYORS

E-19163 ELLISON, Robert Glenn & Tamara

ANNAMARYROSE DRIVE

N. 88° 30' W.

60'

N. 209° 30' E.

BOONE ROAD 50'

1.P.

1.P.

1.P.