12-00-037-000018
027
Scan # 48053

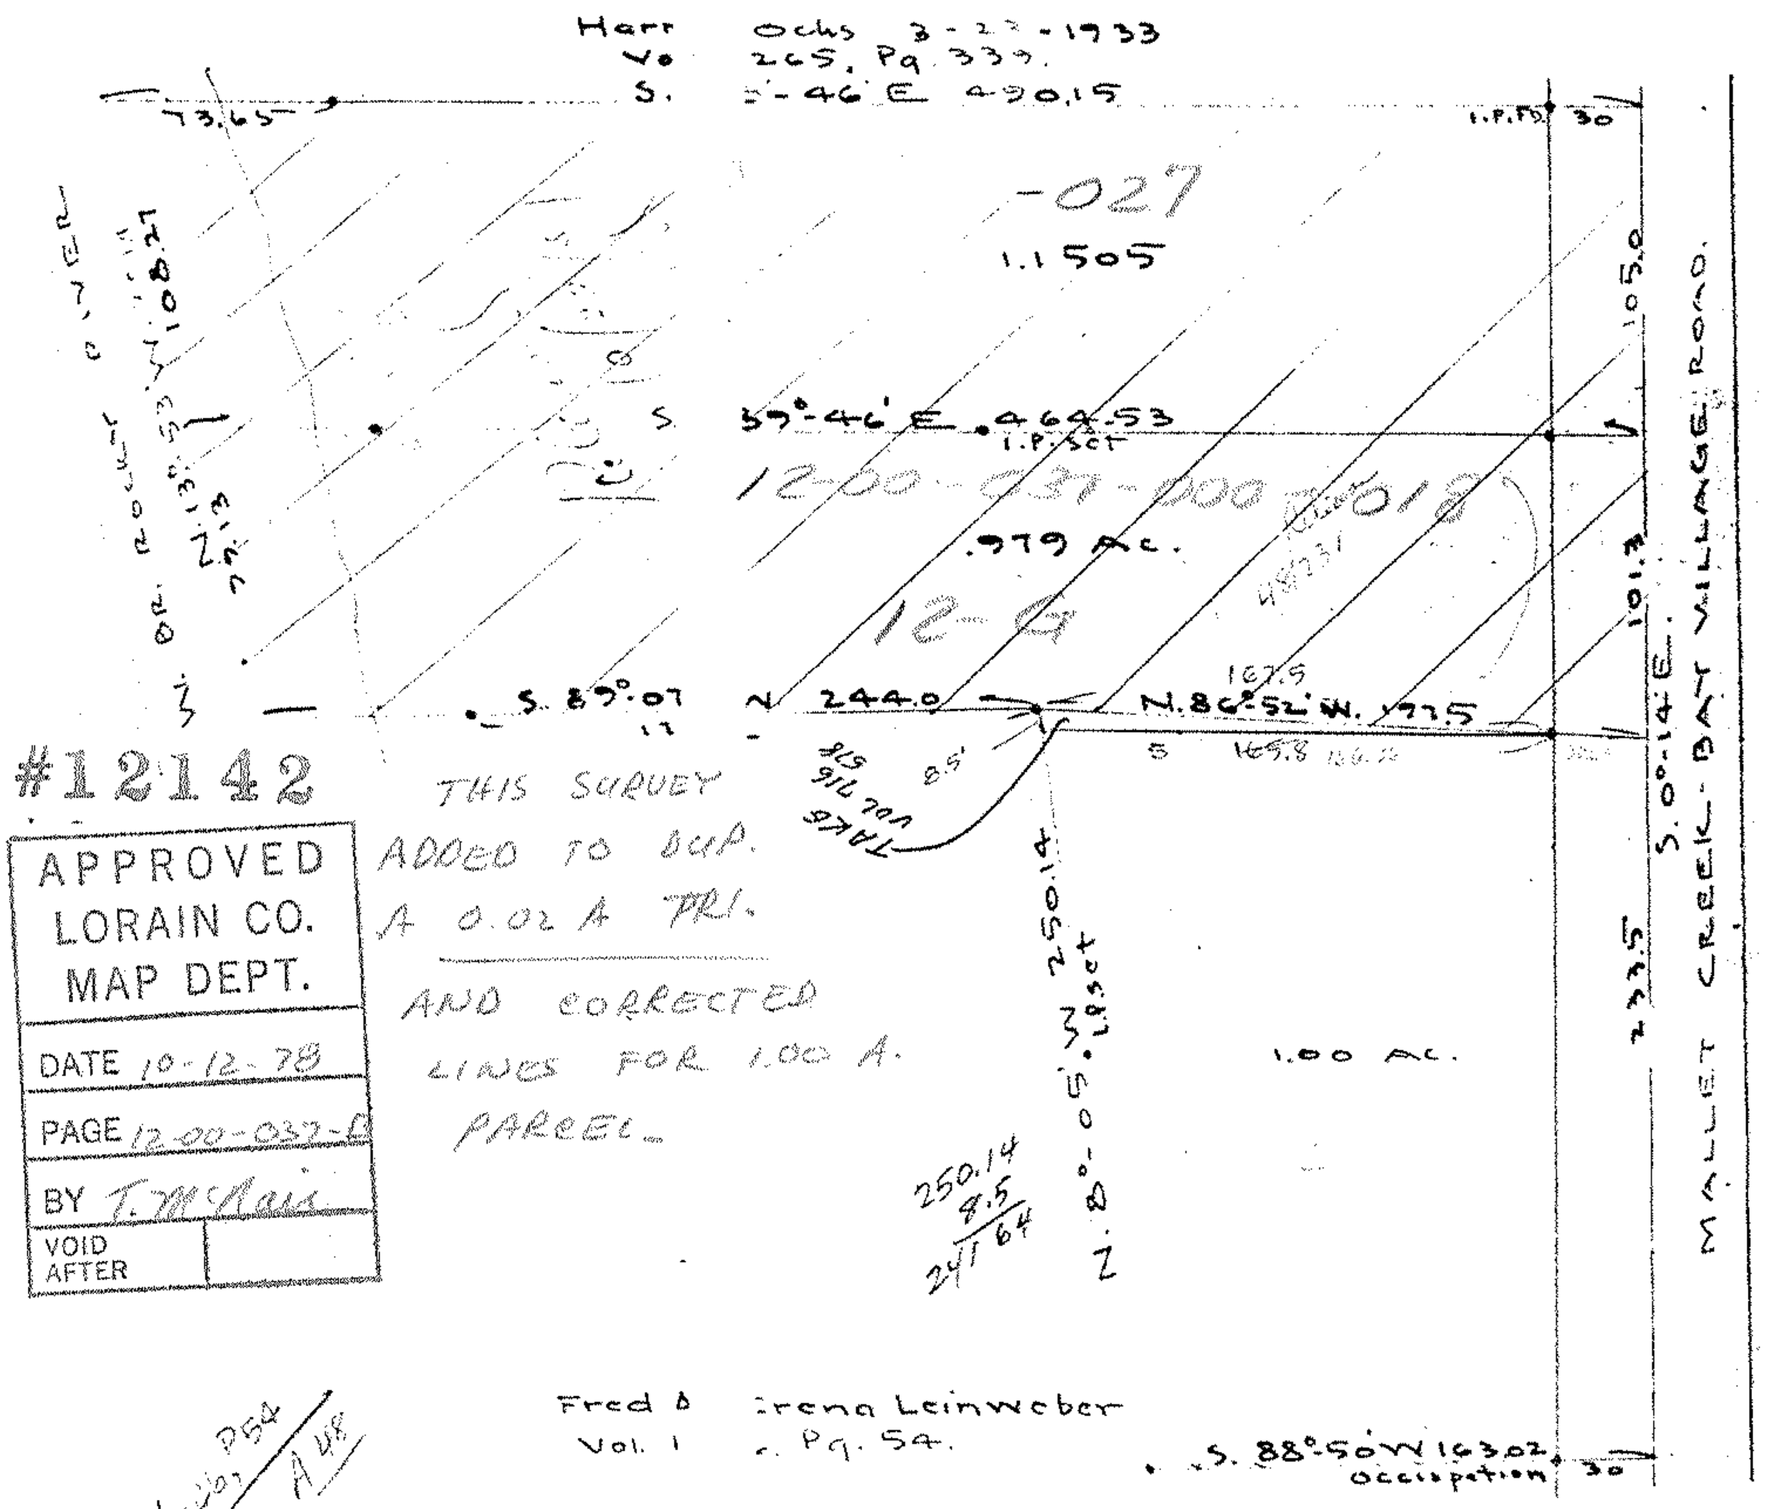

#12142

APPROVED
LORAIN CO.
MAP DEPT.

DATE 10-12-78

PAGE 12-00-037-B

BY T. McNair

VOID AFTER

THIS SURVEY ADDED TO DUP. A 0.02 A PRI. AND CORRECTED LINES FOR 1.00 A. PARCEL.

V 1-40, P54 / A48

12-00-037-000-021
LEINWEBER, FRED & IRENE

8/5/65 { 019 - -020
SEVERS, G.L.
912/188

MAP OF SURVEY FOR
CLYDE & BERTHA SNELL
L. NO. 37, COLUMBIA TOWNSHIP
LORAIN COUNTY, OHIO.
C.T. BIGGS REG. SURVEYOR
OCTOBER 7, 1957 SCALE 1" = 50'

12-00-037-B