12-00-039-A
#12451 Scan # 48065 12-00-039-000-~~004~~

2.17
4.46
6.63

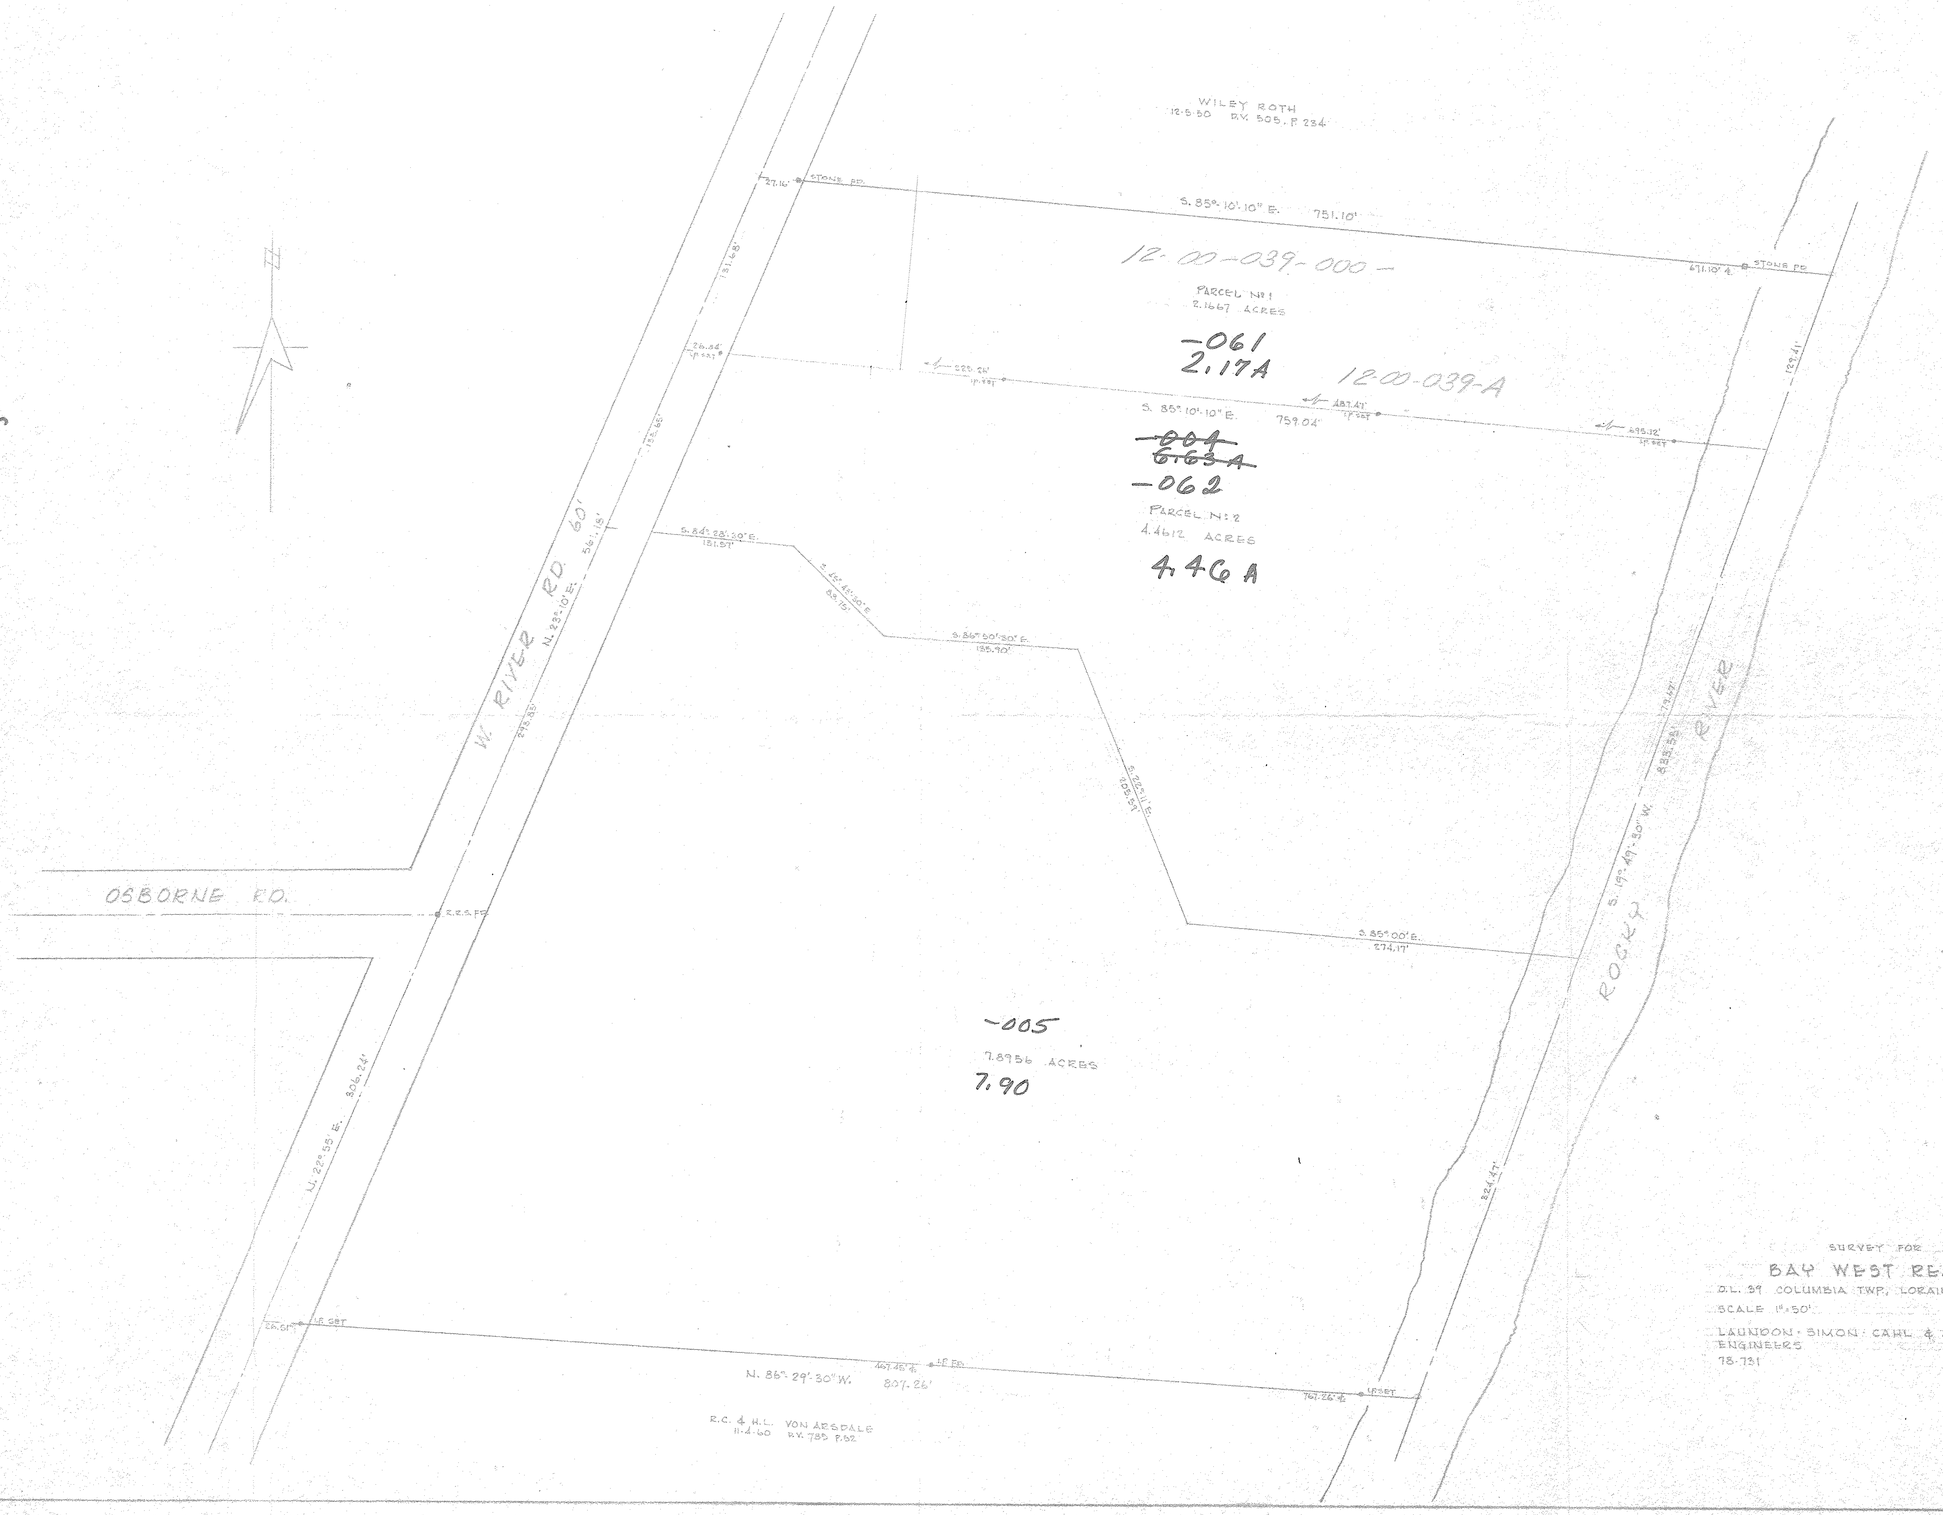

12-00-039-A
12-00-039-000
#12451

JAN 3 1979