12-00-044-000

# KLEINOEDER · SCHMIDT and ASSOCIATES

ENGINEERS — SURVEYORS — CONSULTANTS in LAND PLANNING

ELYRIA · NORWALK · MEDINA OHIO

SUR...

Sublot(s) _____

Subd'n _____

Township COLUMBIA Tract _____

Orig. Lot(s) 44 Sec. _____

County of LORAIN State of Ohio

Corporation _____

COPY

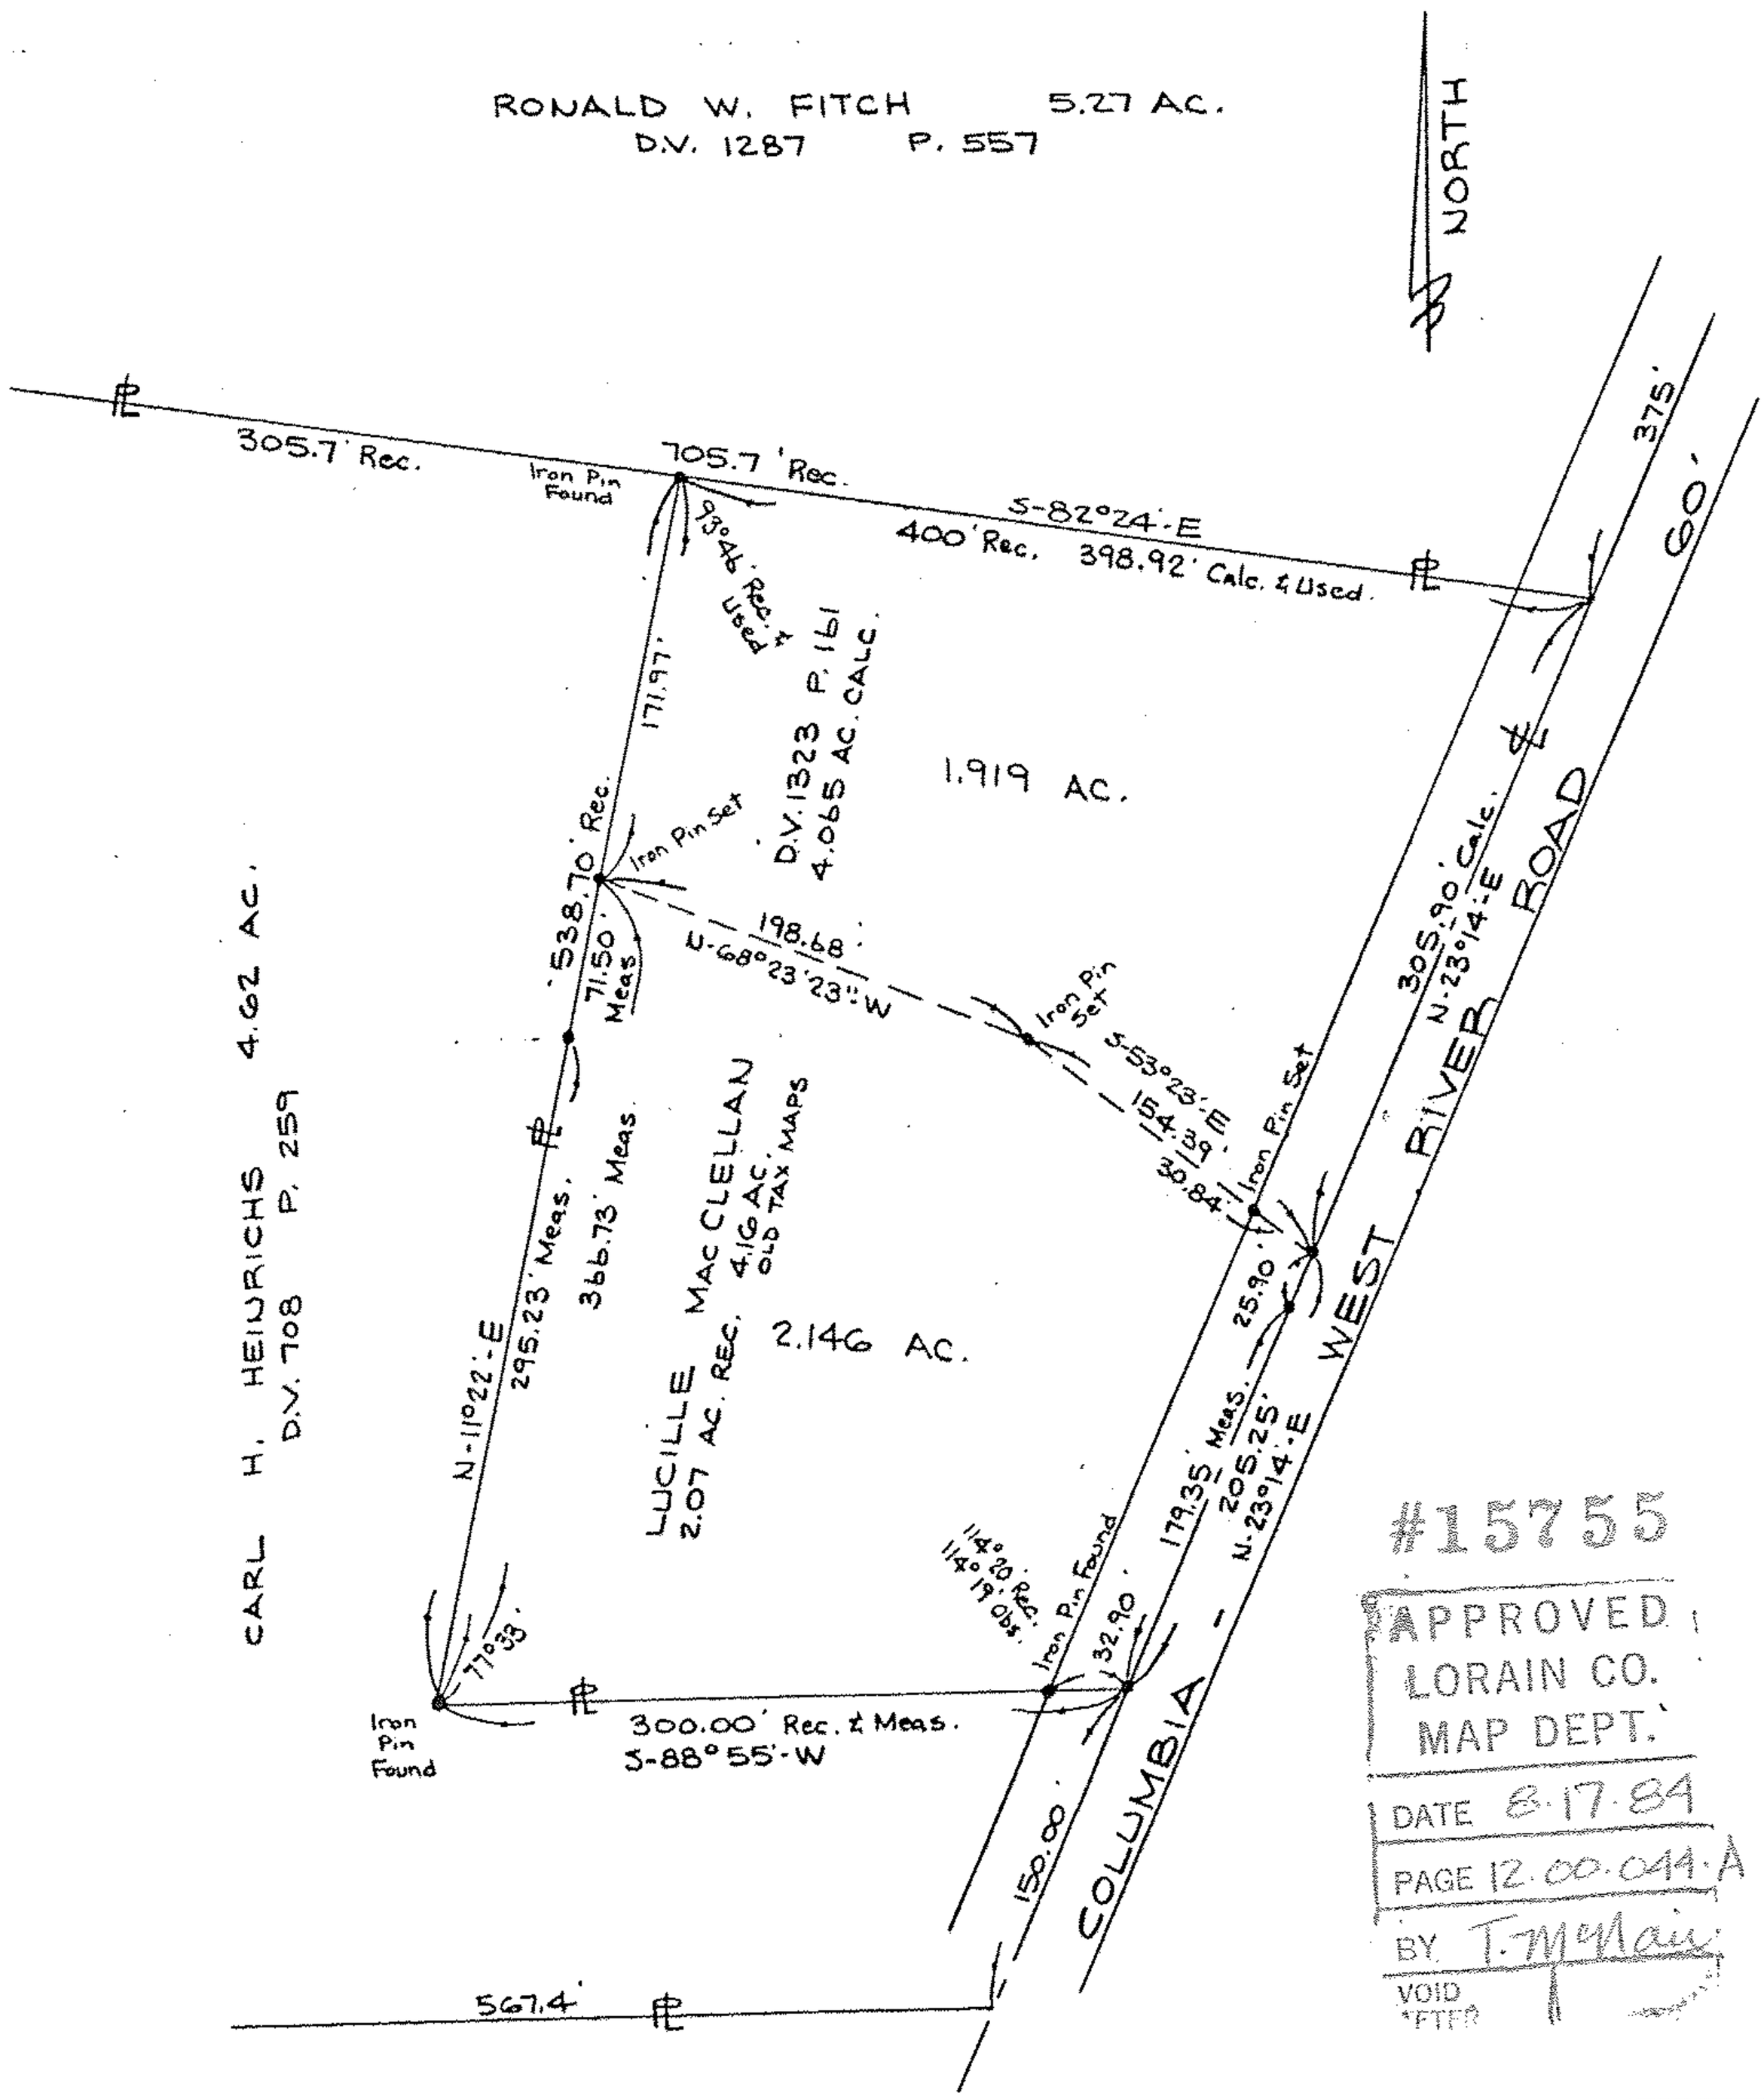


#15755

APPROVED
LORAIN CO.
MAP DEPT.
DATE 8-17-84
PAGE 12-00-044-A
BY T. McMain
VOID AFTER

**Prepared for:** LUCILLE MAC CLELLAN
12576 WEST RIVER RD. COLUMBIA STA., OHIO

| Scale: 1" = 100' | Date: 6-27-84 | Dr. by: DE. | Job No 84-75 |
|---|---|---|---|

12-00-044-A