SURVEY
OF PART OF
ORIGINAL COLUMBIA TWP. LOT Nº 44
TWP. OF COLUMBIA COUNTY OF LORAIN
STATE OF OHIO

PREPARED FOR:
GORDON H. HUGHES
12655 WEST RIVER RD.
COLUMBIA STA.

PREPARED BY:
FOOR & ASSOC. INC.
LAND SURVEYORS
N. RIDGEVILLE, O

DATE: SEPT. 1979
SCALE: 1"=100'

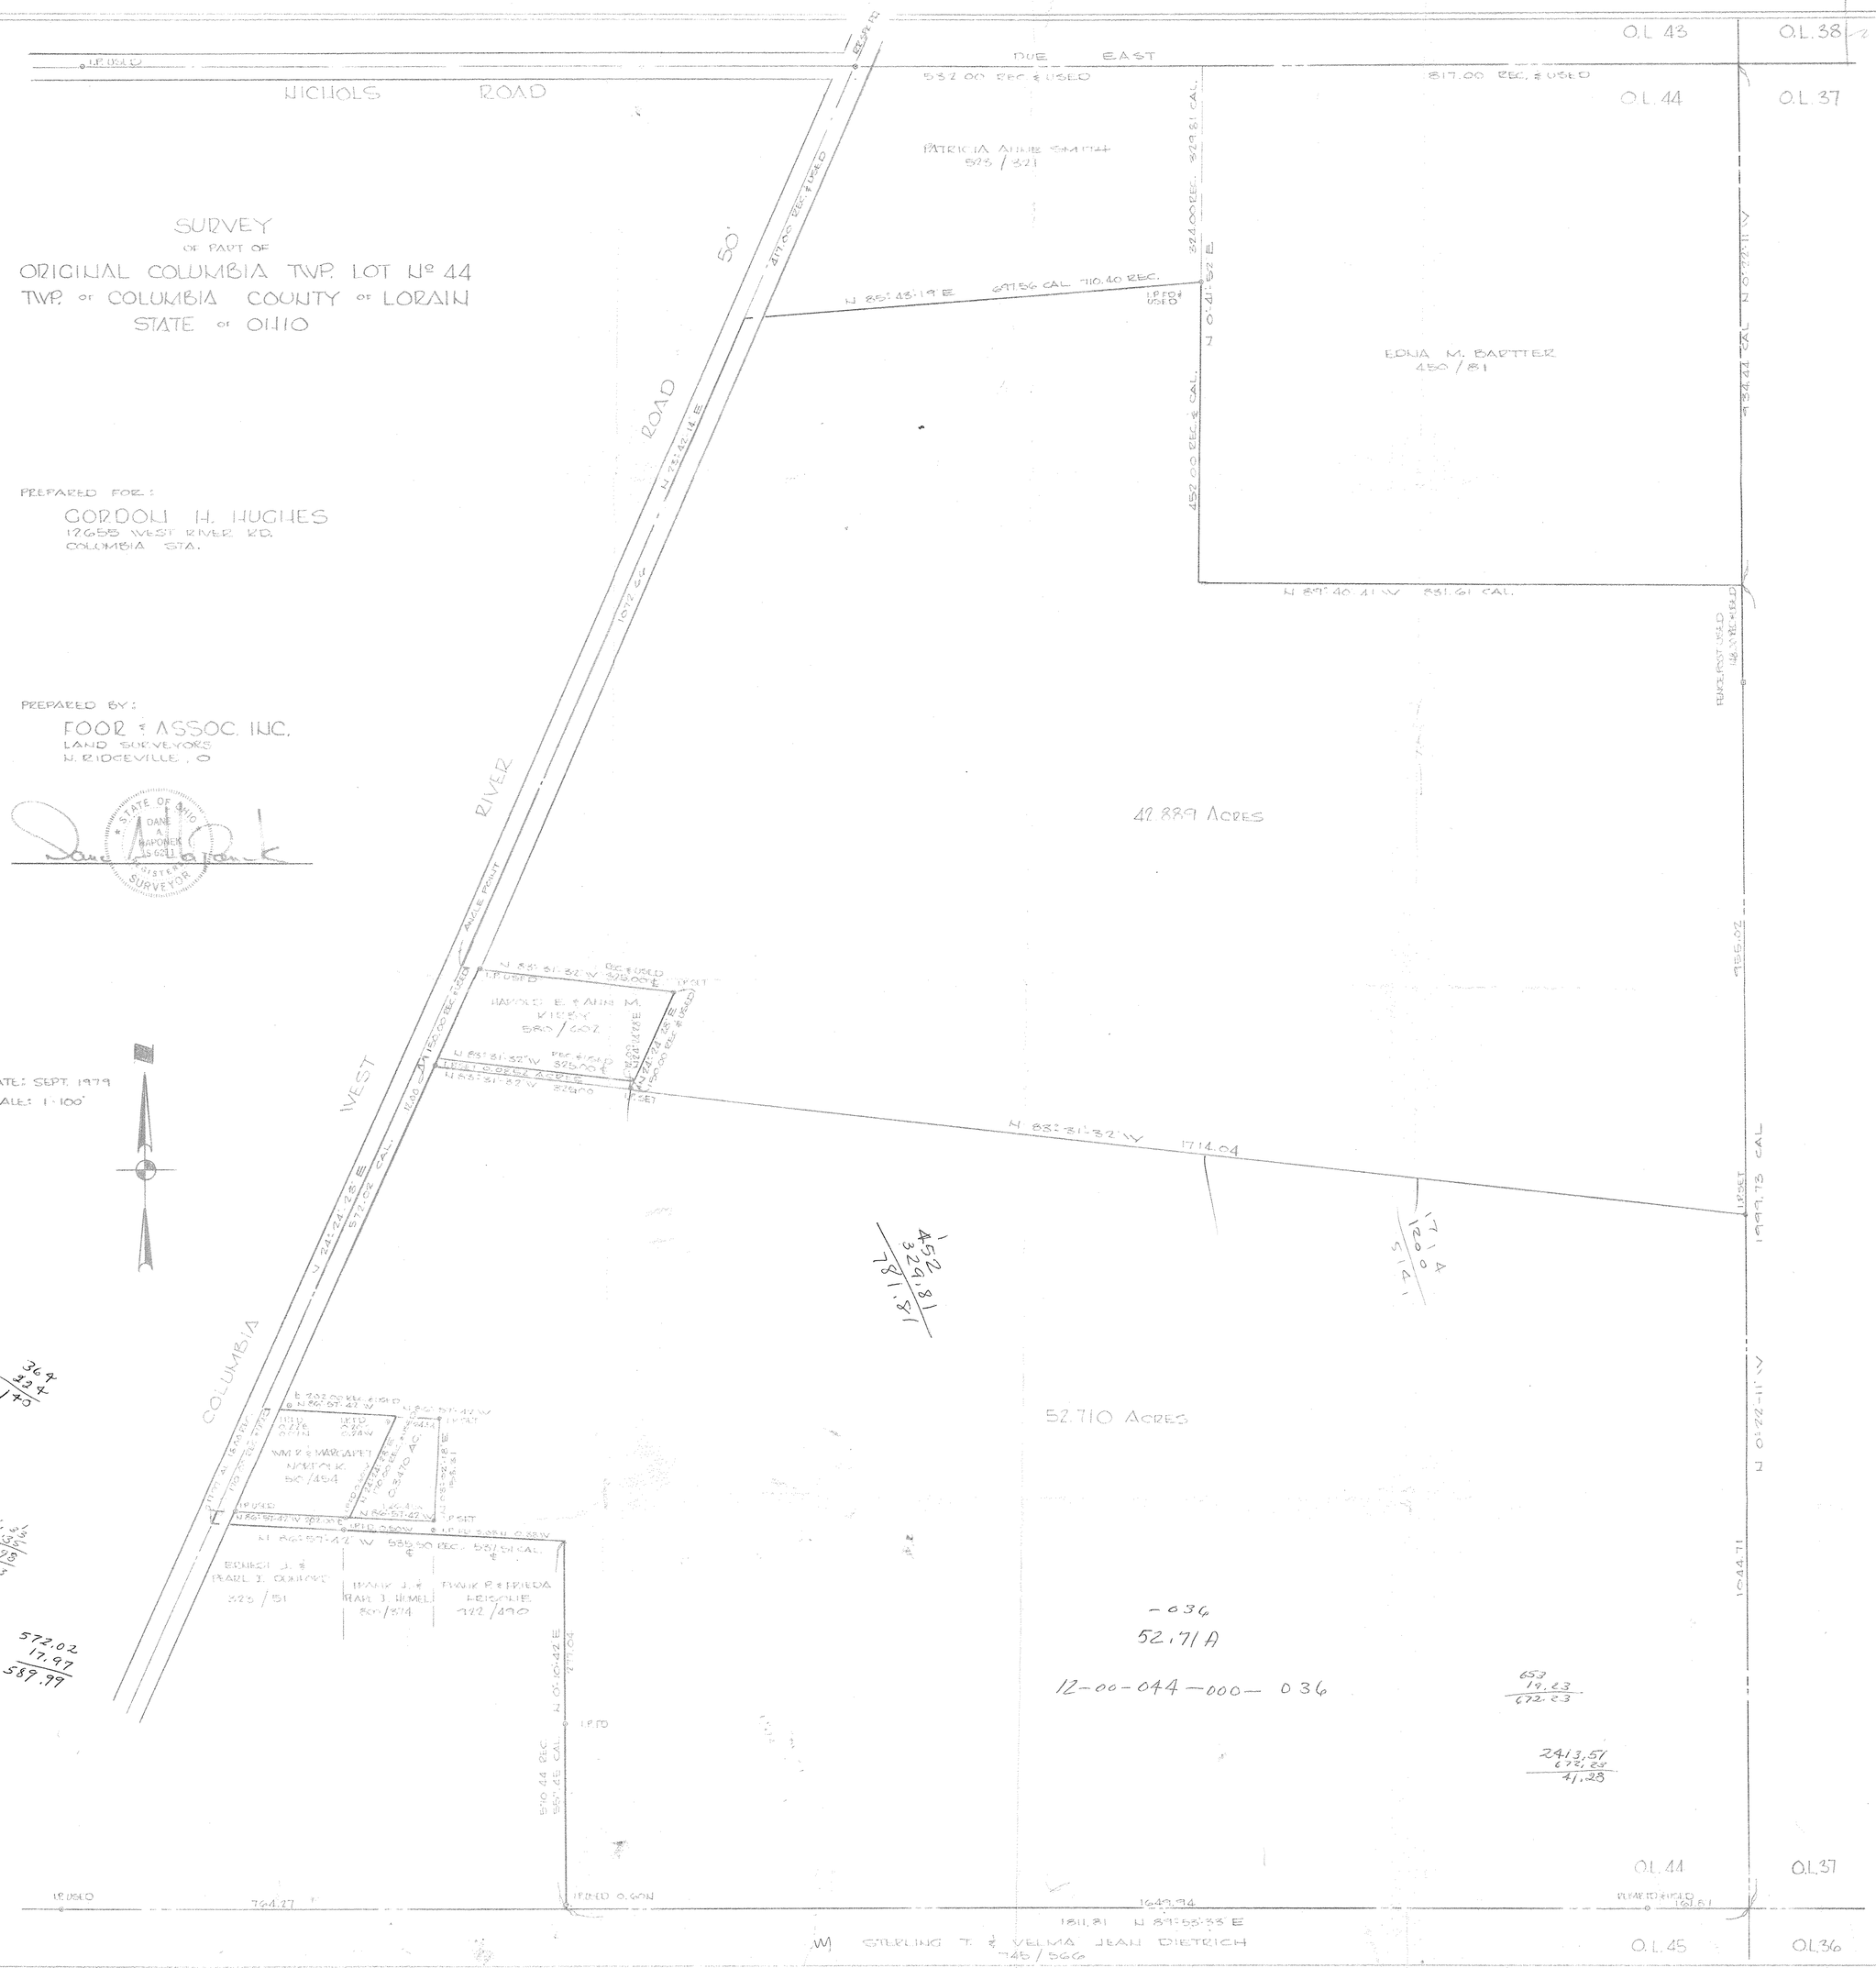

#13282
APPROVED
LORAIN CO.
MAP DEPT.
DATE 12-19-79
PAGE 12-00-044 A & B
BY
VOID AFTER 13282

#79-112