Scan # 48088

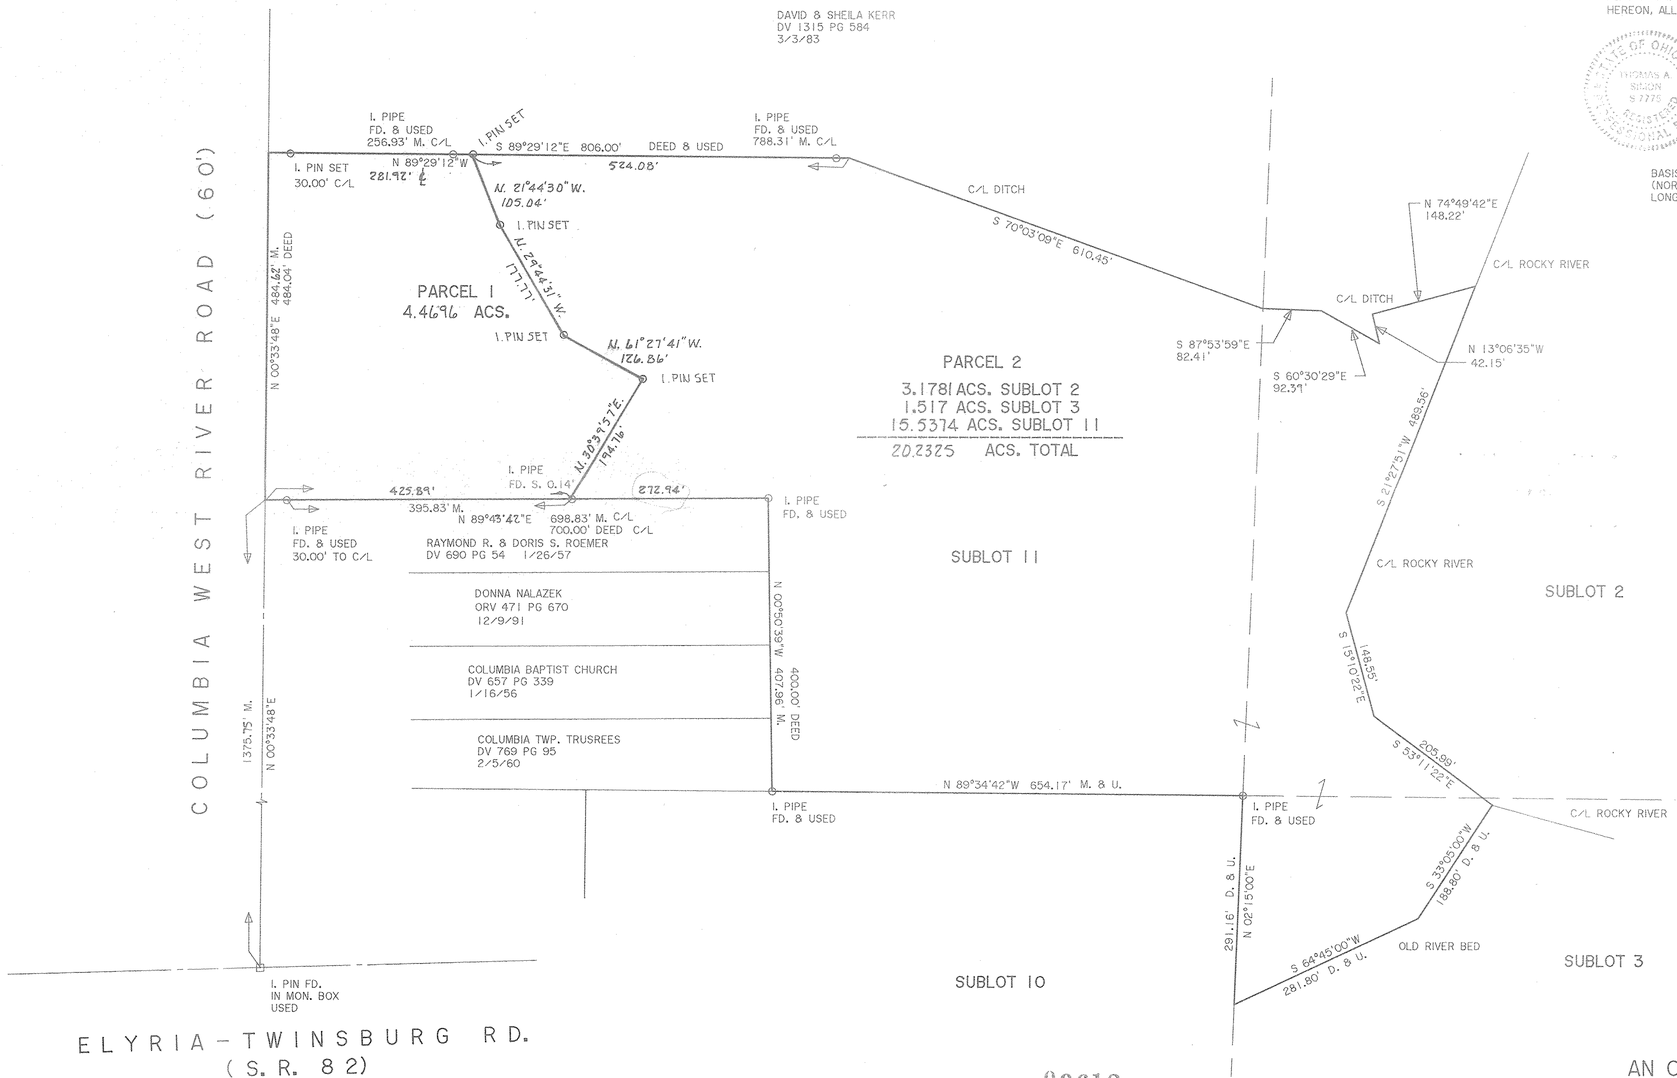

100 0 100 200 300
GRAPHIC SCALE - FEET

N

DIMENSIONS SHOWN ON THIS PLAT ARE EXPRESSED IN FEET AND DECIMAL PARTS THEREOF, ALL BEARINGS ARE TO AN ASSUMED MERIDIAN AND ARE USED TO INDICATE ANGLES ONLY. PERMANENT MONUMENTS WERE FOUND OR SET AT ALL POINTS INDICATED HEREON, ALL OF WHICH I CERTIFY TO BE CORRECT.

STATE OF OHIO THOMAS A. SIMON S 7775 REGISTERED PROFESSIONAL SURVEYOR

THOMAS A. SIMON
REG. PROFESSIONAL SURVEYOR
NO. S-7775

BASIS OF BEARINGS IS THE CENTERLINE OF COLUMBIA WEST RIVER ROAD (NORTH 00°33'48" EAST). IRON PINS SET ARE 5/8" DIAMETER, 30" LONG WITH PLASTIC CAPS "T. SIMON, S-7775".

00618
APPROVED
LORAIN CO.
MAPPING
DATE 12-6-00
PAGE 12-00-045-AB
BY JHatfield
00-00618

METRO PARK BOARD
DOC. #20000665962
1/28/2000

PLAT OF SURVEY AND SPLIT
FOR
HOSANNA LUTHERAN CHURCH
AN OHIO CORPORATION, NOT FOR PROFIT
LORAIN COUNTY METRO PARKS

BEING KNOWN AS PART OF ORIGINAL COLUMBIA TOWNSHIP LOT NO. 45 AND PARTS OF SUBLOTS 2, 3, AND 11 OF SAID ORIGINAL LOT NO. 45

TOWNSHIP OF COLUMBIA COUNTY OF LORAIN
STATE OF OHIO

AUGUST 2000 SCALE: 1" = 100'

THOMAS SIMON & ASSOCIATES, INC.
PROFESSIONAL LAND SURVEYORS

COBBLESTONE CORNER PROFESSIONAL CENTER
39049 CENTER RIDGE ROAD
NORTH RIDGEVILLE, OHIO 44039
(440) 327-2925
FAX 327-2964