DEED BOOK / PAGE	PARCEL NO.	PROPERTY OWNER	DATE	ACREAGE
V-1088, P-882	12-00-049-000-004	WALLACE E. & SUSAN M. WENDT	10-03-73	23.4/79
V-670, P-440	12-00-050-000-001	HENRIETTA P. BRYANT	08-01-56	1.3/9.6
DR-692, P-462	12-00-050-000-003	JAMES E. LOUELL	04-22-93	6/13
V-1043, P-178	12-00-050-000-011	DAVID L. & RITA M. SIMPSON	03-03-72	31.7
V-1018, P-455	12-00-050-000-012	DANIEL J. & RUTH A. TERLAAK	02-10-71	5.0
V-1079, P-667	12-00-050-000-013	ADIA V. POLIVCHAK, PARCEL # 3	06-07-73	36.247
DR-605, P-075	12-00-050-000-029	DARLENE A. OTIS, F.K.a. DARLENE VITAS	10-06-92	7.82
V-1114, P-739	12-00-051-000-007	STEPHAN P. & ELIZABETH L. VASAS	11-19-74	5.317
V-1107, P-312	12-00-051-000-008	CHARLES J. & SARA J. WEBER	07-22-74	4.91
V-1072, P-066	12-00-051-000-009	MARJORIE G. SLANSKY	03-23-70	1.88/10

LOT SPLIT – P.P. # 12-00-050-000-011

STATE OF OHIO
COUNTY OF LORAIN
TOWNSHIP OF COLUMBIA
ORIGINAL LOTS NO. 50, AND NO. 31

LEGEND

- IRON PIPE FOUND
- IRON PIN FOUND
- IRON PIN SET
- CONCRETE MONUMENT FOUND
- POWER POLE
- POWER LINE
- FENCE
- (D) ORIGINAL DEED
- (M) FIELD MEASURE

N

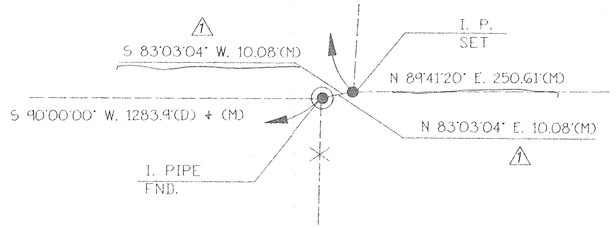

DETAIL A

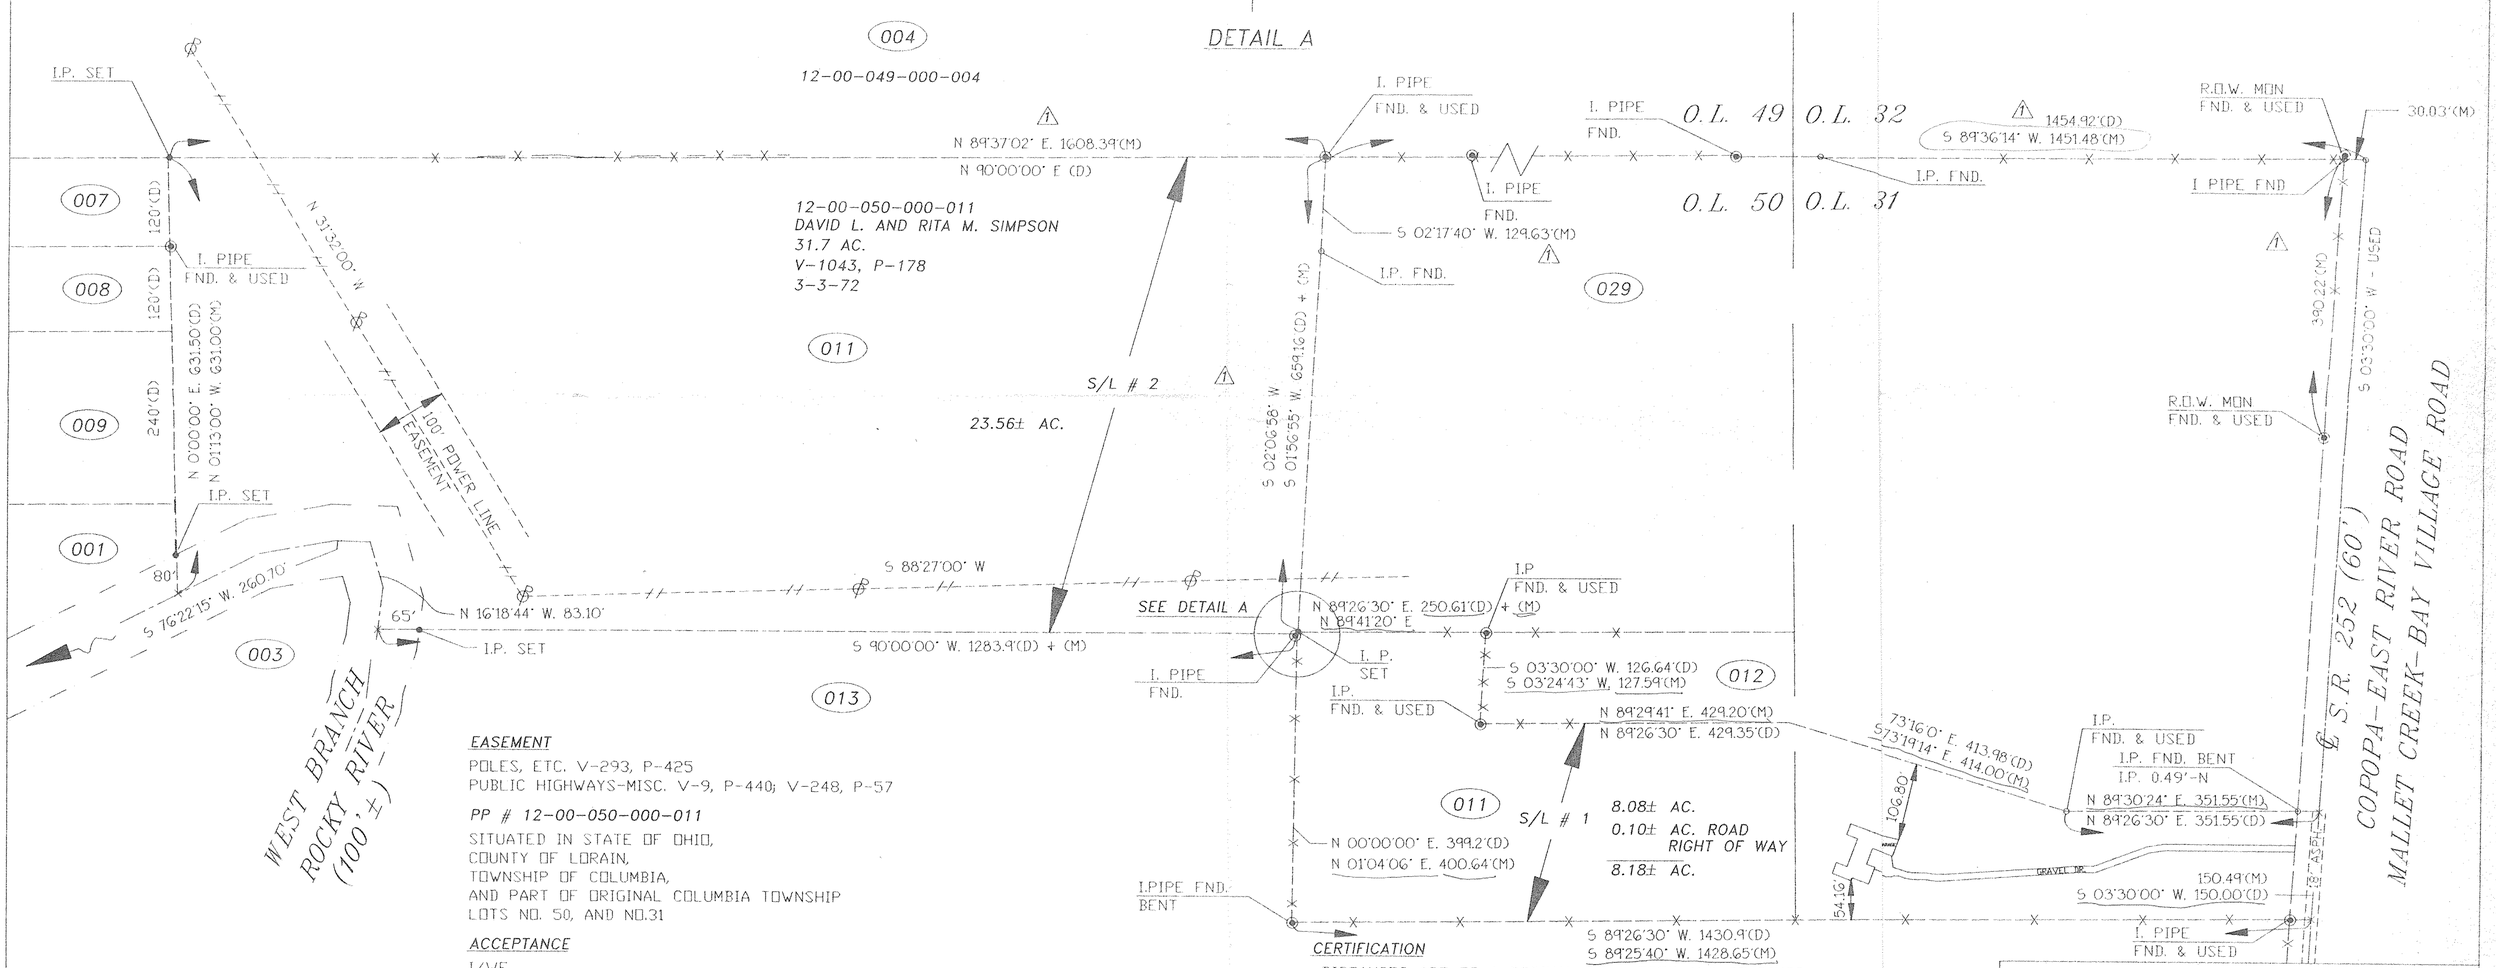

EASEMENT

POLES, ETC. V-293, P-425
PUBLIC HIGHWAYS-MISC. V-9, P-440; V-248, P-57

PP # 12-00-050-000-011

SITUATED IN STATE OF OHIO,
COUNTY OF LORAIN,
TOWNSHIP OF COLUMBIA,
AND PART OF ORIGINAL COLUMBIA TOWNSHIP
LOTS NO. 50, AND NO.31

ACCEPTANCE

I/WE _____
THE UNDERSIGNED OWNERS, DO HEREBY RECOGNIZE AND ATTEST THIS PLAT TO BE AN ACCURATE REPRESENTATION OF THE LANDS OWNED BY US AND HEREBY GRANT SAME TO BE SPLIT

DAVID L. SIMPSON _____ WITNESS _____

RITA M. SIMPSON _____ WITNESS _____

CERTIFICATION

DISTANCES ARE TO A DECIMAL OF A FOOT AND BEARINGS ARE TO AN ASSUMED MERIDIAN AND ARE FOR ANGLES ONLY, ALL OF WHICH I CERTIFY TO BE CORRECT TO THE BEST OF MY ABILITY.

Ronald D. Robison P.S. #5687

RONALD D. ROBISON, P.S. #5687

MR. DAVID L. SIMPSON
19322 EAST RIVER ROAD
COLUMBIA STATION, OHIO 44028

SCALE: 1"=100'	APPROVED BY:	DRAWN BY: DCP
DATE: JAN.12,1995		REV.: 1 FEB.16,1995

SURVEYED BY: R.D. ROBISON, P.S.
25967 REDWOOD DR.
OLMSTED FALLS, OHIO 44138

LOT SPLIT: 12-00-050-000-011 | DRAWING NO.

SIMPSON