ACCEPTANCE:

I (WE) OWNERS OF THE LAND PLATTED HEREON DO HEREBY ACCEPT THE SPLIT OF PARCEL Nº 12-00-055-101-037 AND ITS CONSOLIDATION TO PARCELS 12-00-055-101-032 & 12-00-055-101-035 AS SHOWN HEREON.

Rev Allan C. Alexander Bishop required

Arthur L. Rundle

COUNTY OF Lorain } STATE OF OHIO } S.S. BEFORE ME A NOTARY PUBLIC IN AND FOR SAID COUNTY, AND STATE PERSONALLY APPEARED THE ABOVE MENTIONED Rev Allan C. Alexander Bishop required Arthur Rundle WHO ACKNOWLEDGE THAT THEY DID SIGN THE FOREGOING INSTRUMENT AND THAT THE SAME IS THEIR FREE ACT AND DEED, IN TESTIMONY WHEREOF I HAVE HERE UNTO SET MY HAND AND OFFICIAL SEAL IN Columbia Sta. OHIO, THIS 12th DAY OF October 1992.

Elizabeth C. Wagner
NOTARY PUBLIC
My Comm. Exp. 3-1-97

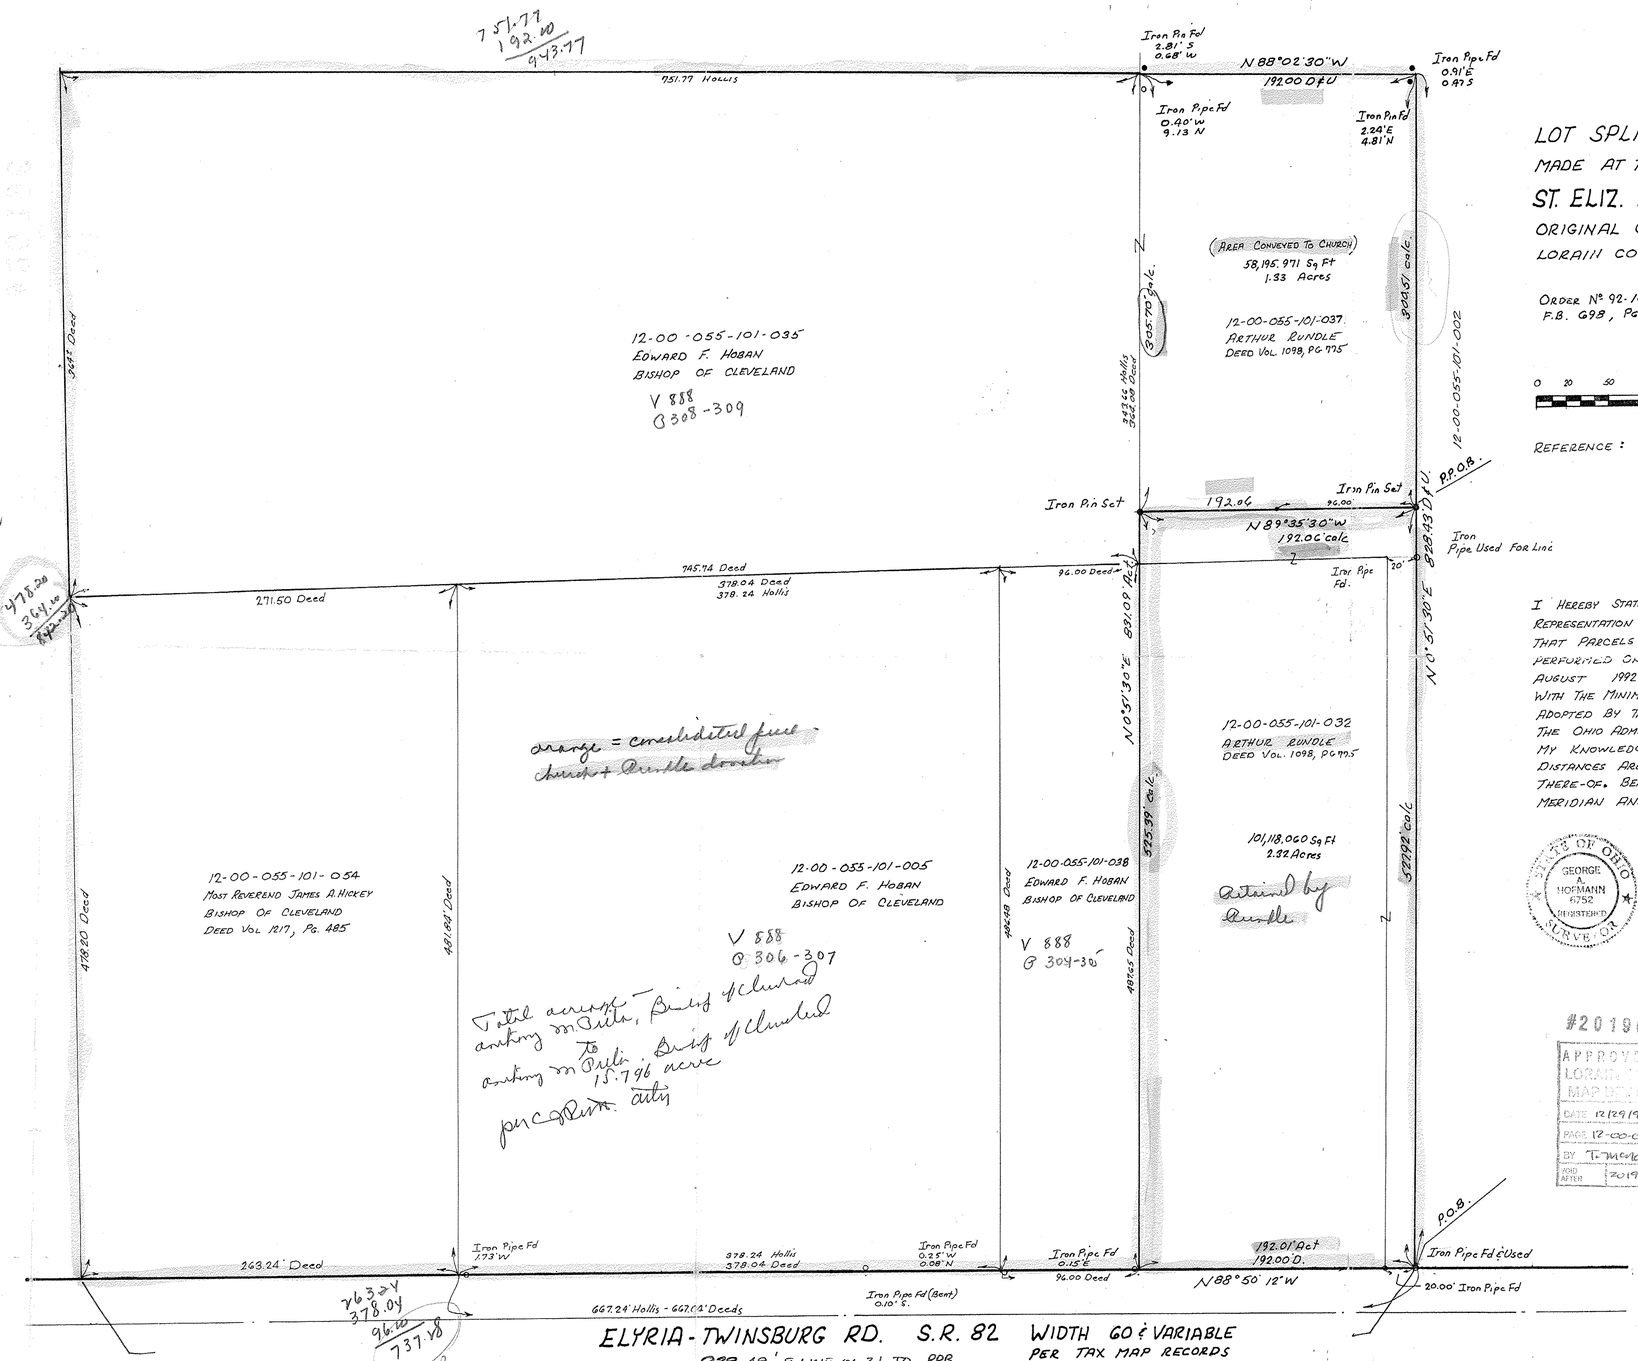

LOT SPLIT & CONSOLIDATION

MADE AT THE INSTANCE OF

ST. ELIZ. ANN SETON CHURCH

ORIGINAL COLUMBIA TOWNSHIP LOT Nº 55

LORAIN COUNTY, OHIO

ORDER Nº 92-164 SEPT. 21, 1992
F.B. 698, PG. 83

0 20 50 100

REFERENCE: SURVEY BY RAY E. HOLLIS, DEC. 1958

I HEREBY STATE THAT THIS PLAT IS A TRUE AND ACCURATE REPRESENTATION OF THE PREMISES SHOWN HEREON, AND THAT PARCELS -032 & -037 WERE BASED ON A SURVEY PERFORMED ON THE GROUND UNDER MY SUPERVISION ON AUGUST 1992. SURVEY WAS PERFORM IN COMPLIANCE WITH THE MINIMUM STANDARDS FOR BOUNDARY SURVEYS AS ADOPTED BY THE STATE OF OHIO, CHAPTER 4733-37 OF THE OHIO ADMINISTATIVE CODE. ALL TO THE BEST OF MY KNOWLEDGE, INFORMATION, AND PERSONAL BELIEFS. DISTANCES ARE GIVEN IN FEET AND DECIMAL PARTS THERE-OF. BEARINGS ARE GIVEN TO AN ASSUMED MERIDIAN AND ARE USED TO INDICATE ANGLES ONLY.

BY: George A. Hofmann
GEORGE A. HOFMANN
REGISTERED SURVEYOR Nº 6752

STATE OF OHIO GEORGE A. HOFMANN 6752 REGISTERED SURVEYOR

JAMES B. ROOT & ASSOCIATES
CONSULTING CIVIL ENGINEERS & SURVEYORS
24 BEECH ST.
BEREA, OHIO 44017
(216) - 234-5594

#20196

APPROVED LORAIN CO. MAP DEPT.
DATE 12/29/92
PAGE 12-00-055 A
BY T. McClain
VOID AFTER 20196

Scan # 48111