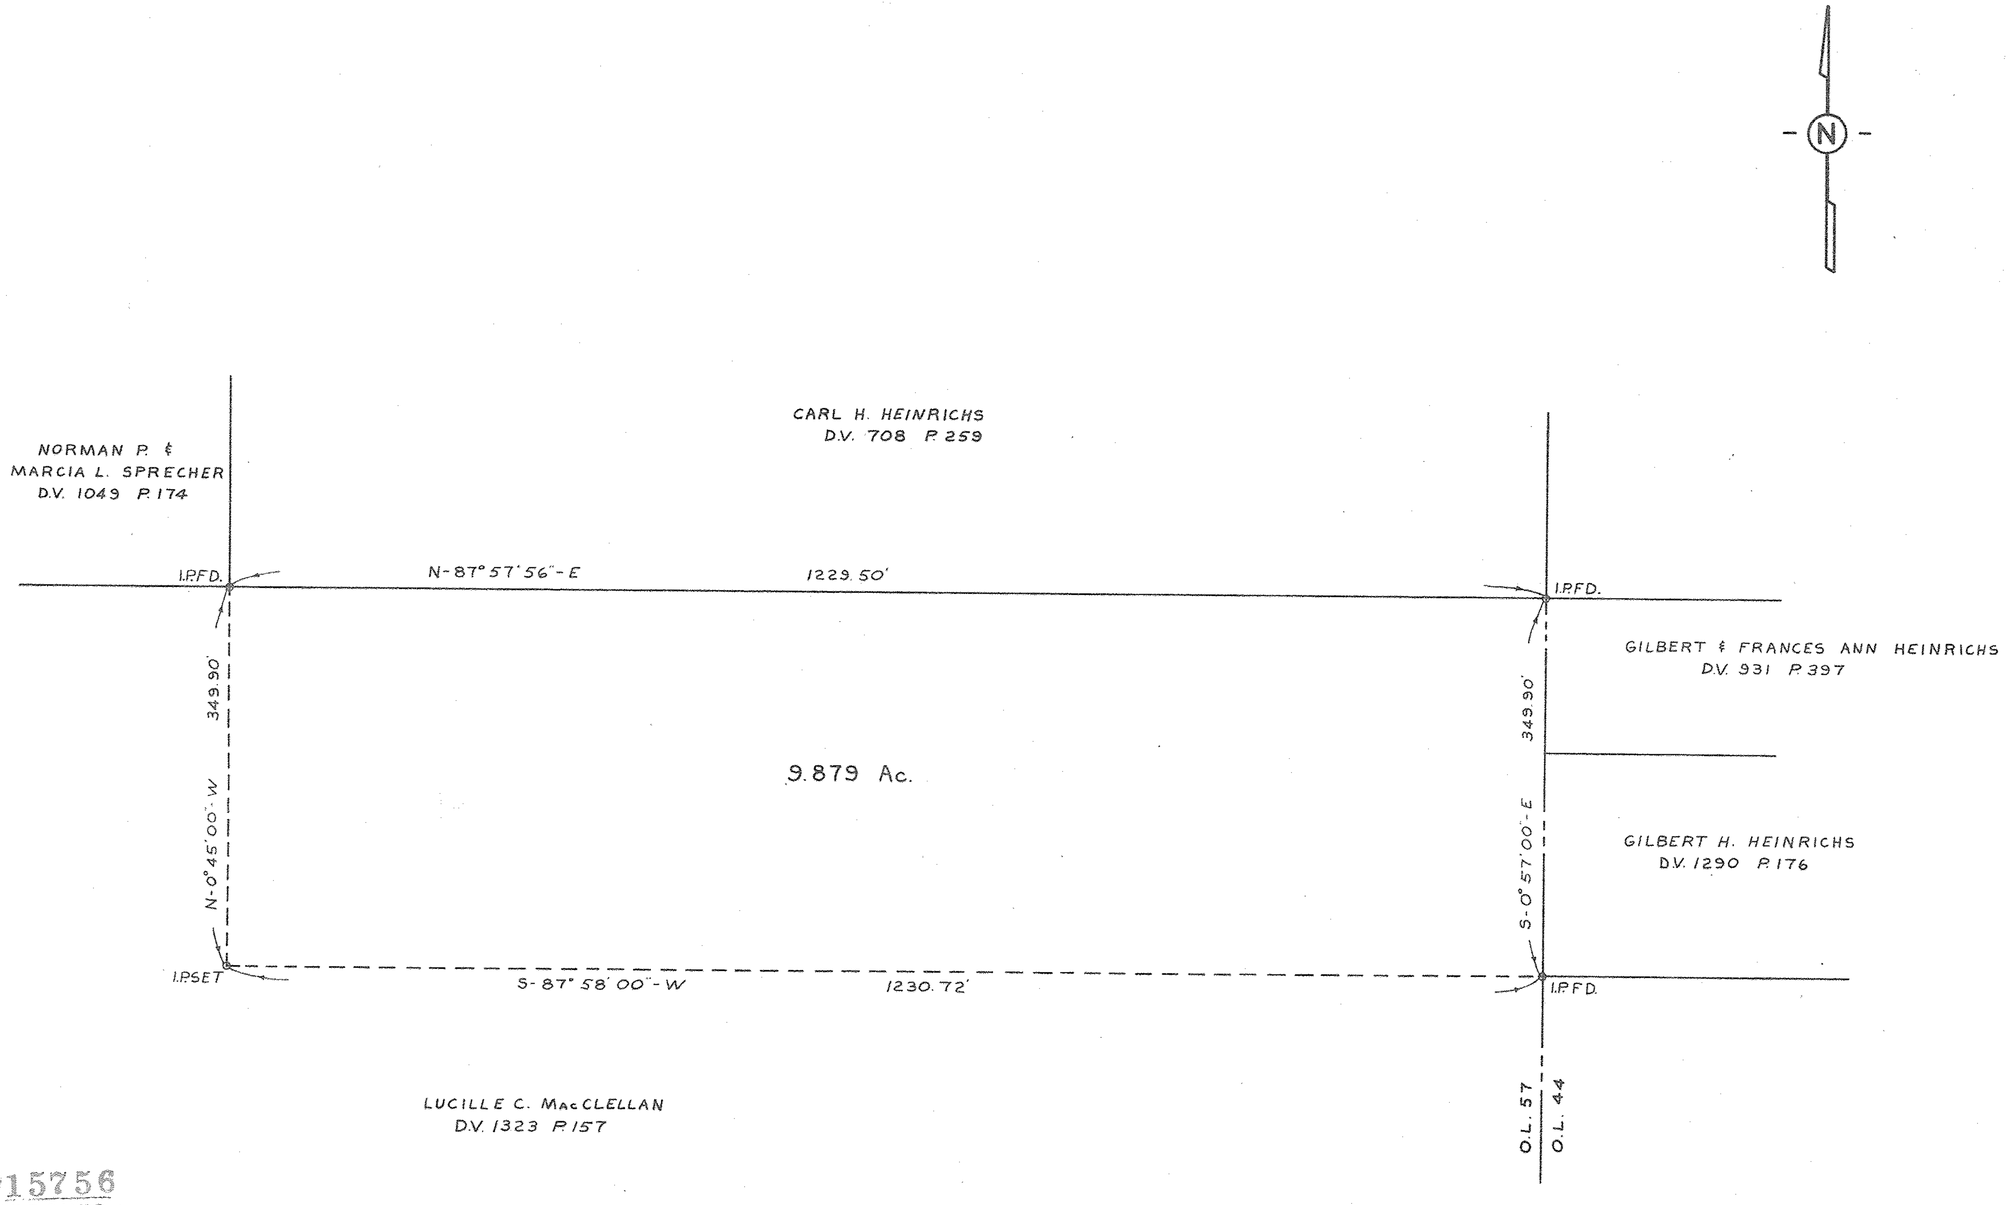

#15756
APPROVED
LORAIN CO.
MAP DEPT.
DATE 8-20-84
PAGE 12-B
BY T. McMain
VOID AFTER

PROJECT

BOUNDARY SURVEY

PART OF COLUMBIA TWP. ORIGINAL LOT NO. 57

TOWNSHIP OF COLUMBIA, COUNTY OF LORAIN, STATE OF OHIO

Prepared for: GILBERT HEINRICHS

Rev.

Drawn by: T.D.P.

Checked by:

App. by:

Scale: 1" = 100'

Date: 7-20-84

KLEINOEDER · SCHMIDT and ASSOCIATES

ENGINEERS — SURVEYORS — CONSULTANTS in LAND PLANNING

ELYRIA - NORWALK - MEDINA OHIO

REFERENCES

SHEET NO. ____ of ____

JOB NO. 84-93