12-00-080-000-019 7021, 031, 032, 034 Scan # 4816
12-00-080-B Julian & Agnes Suley D. Vol. 671 Pg. 278

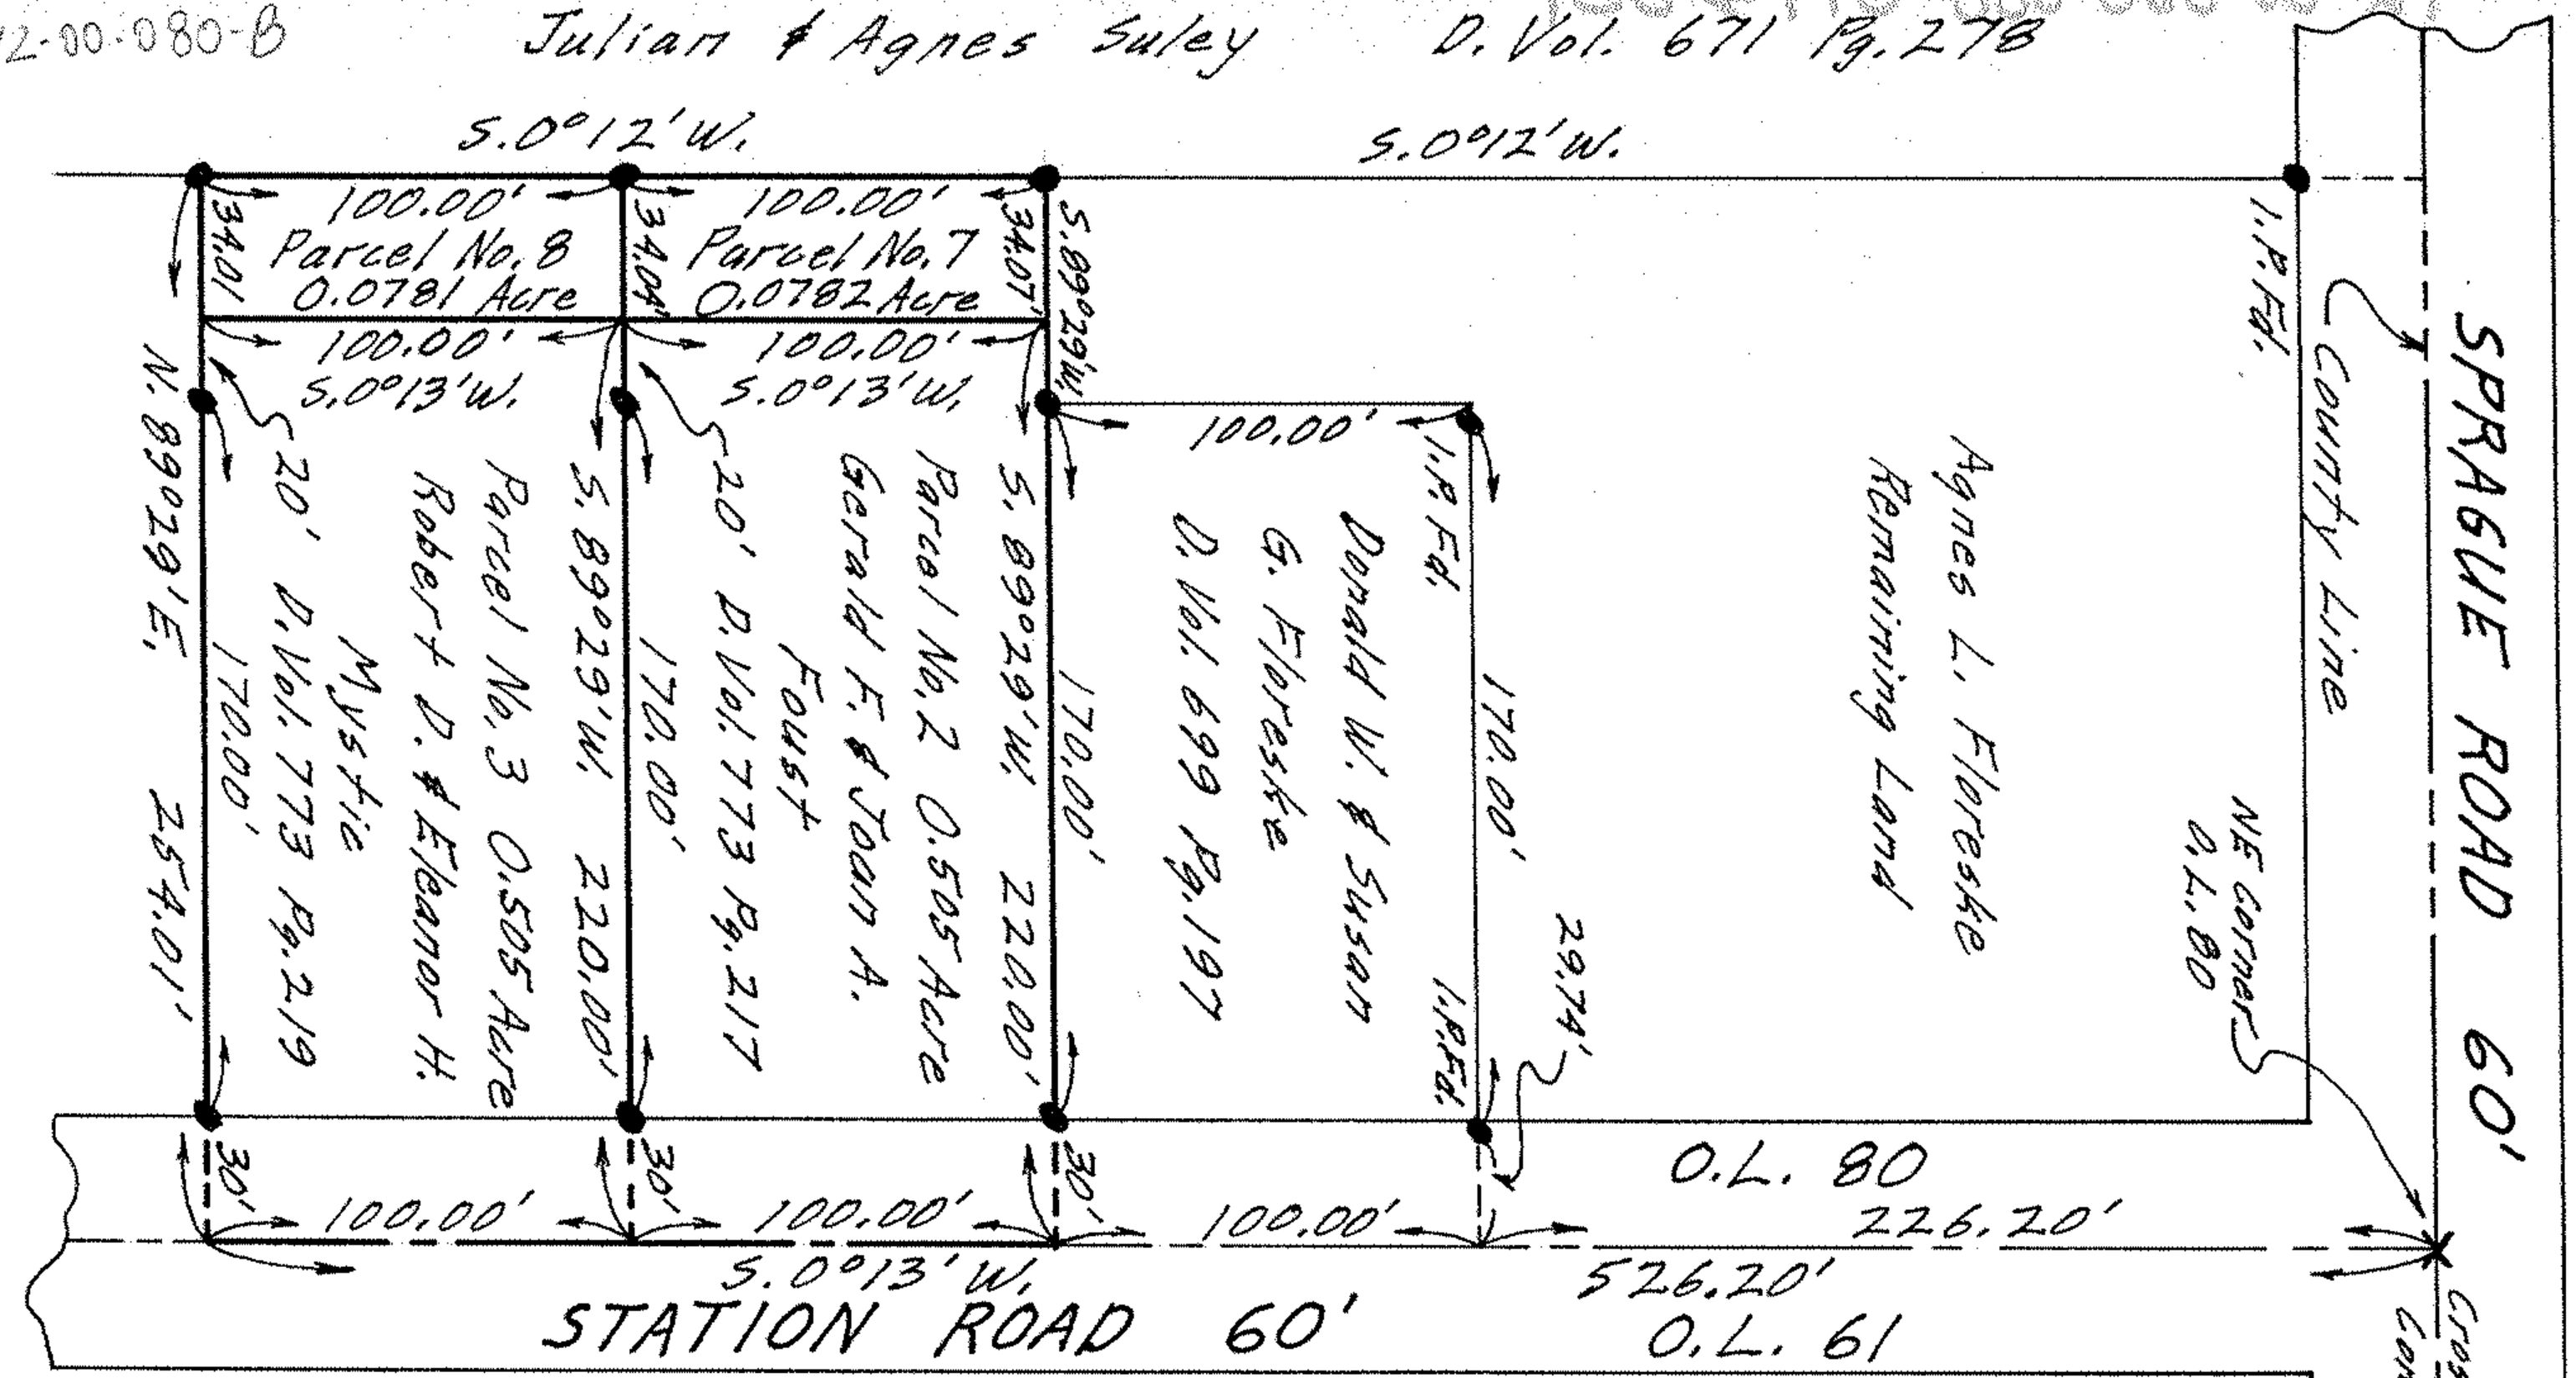


PLAT SHOWING SURVEYS FOR
AGNES L. FLORESKE
ORIGINAL LOT NO. 80 - COLUMBIA TWP.
LORAIN COUNTY OHIO
SCALE: 1"=60'

NOTE: ● indicates iron pin set unless otherwise designated.

N

Gary E. Penfound Reg. Surveyor No. 4457
PARCELS NOS. 2 & 3 SURVEYED MAY 3 - 1960
PARCELS NOS. 7 & 8 SURVEYED AUGUST 1967