


14-00-105-000-016, 017


Scan # 48174



Basis of bearings is the record bearing for the centerline of Ashland-Oberlin Road, State Route 58

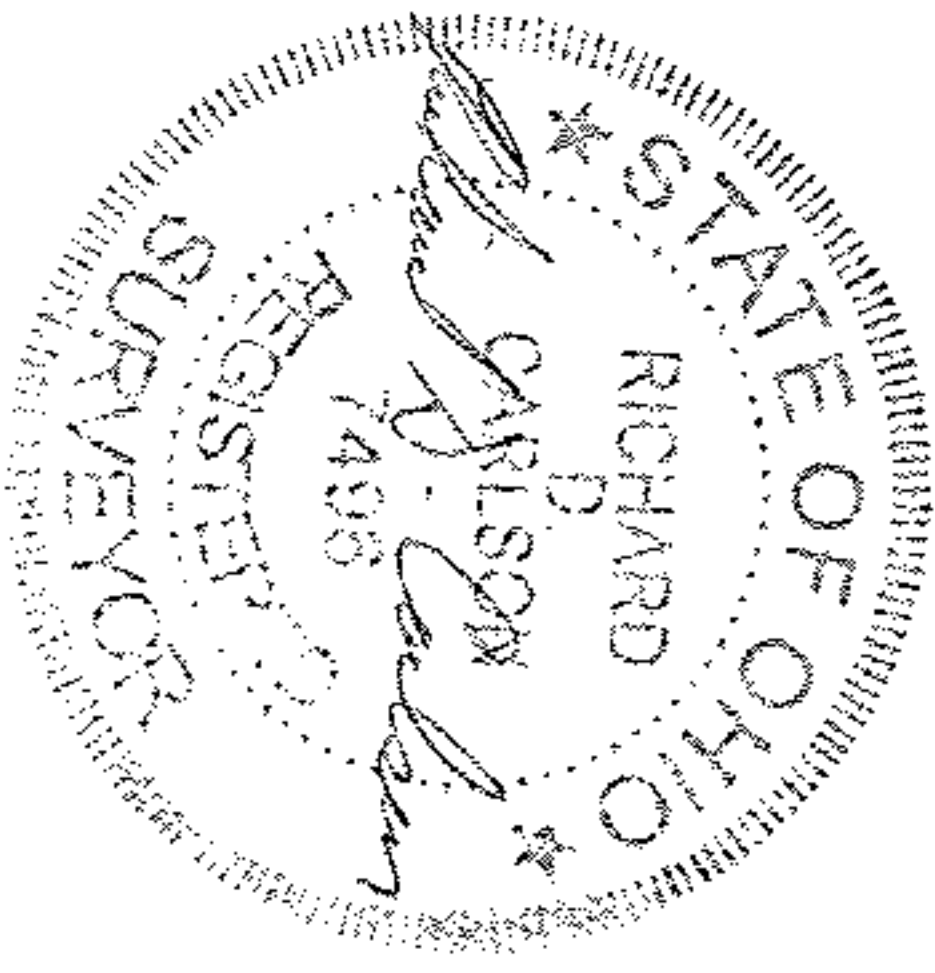

Assumed

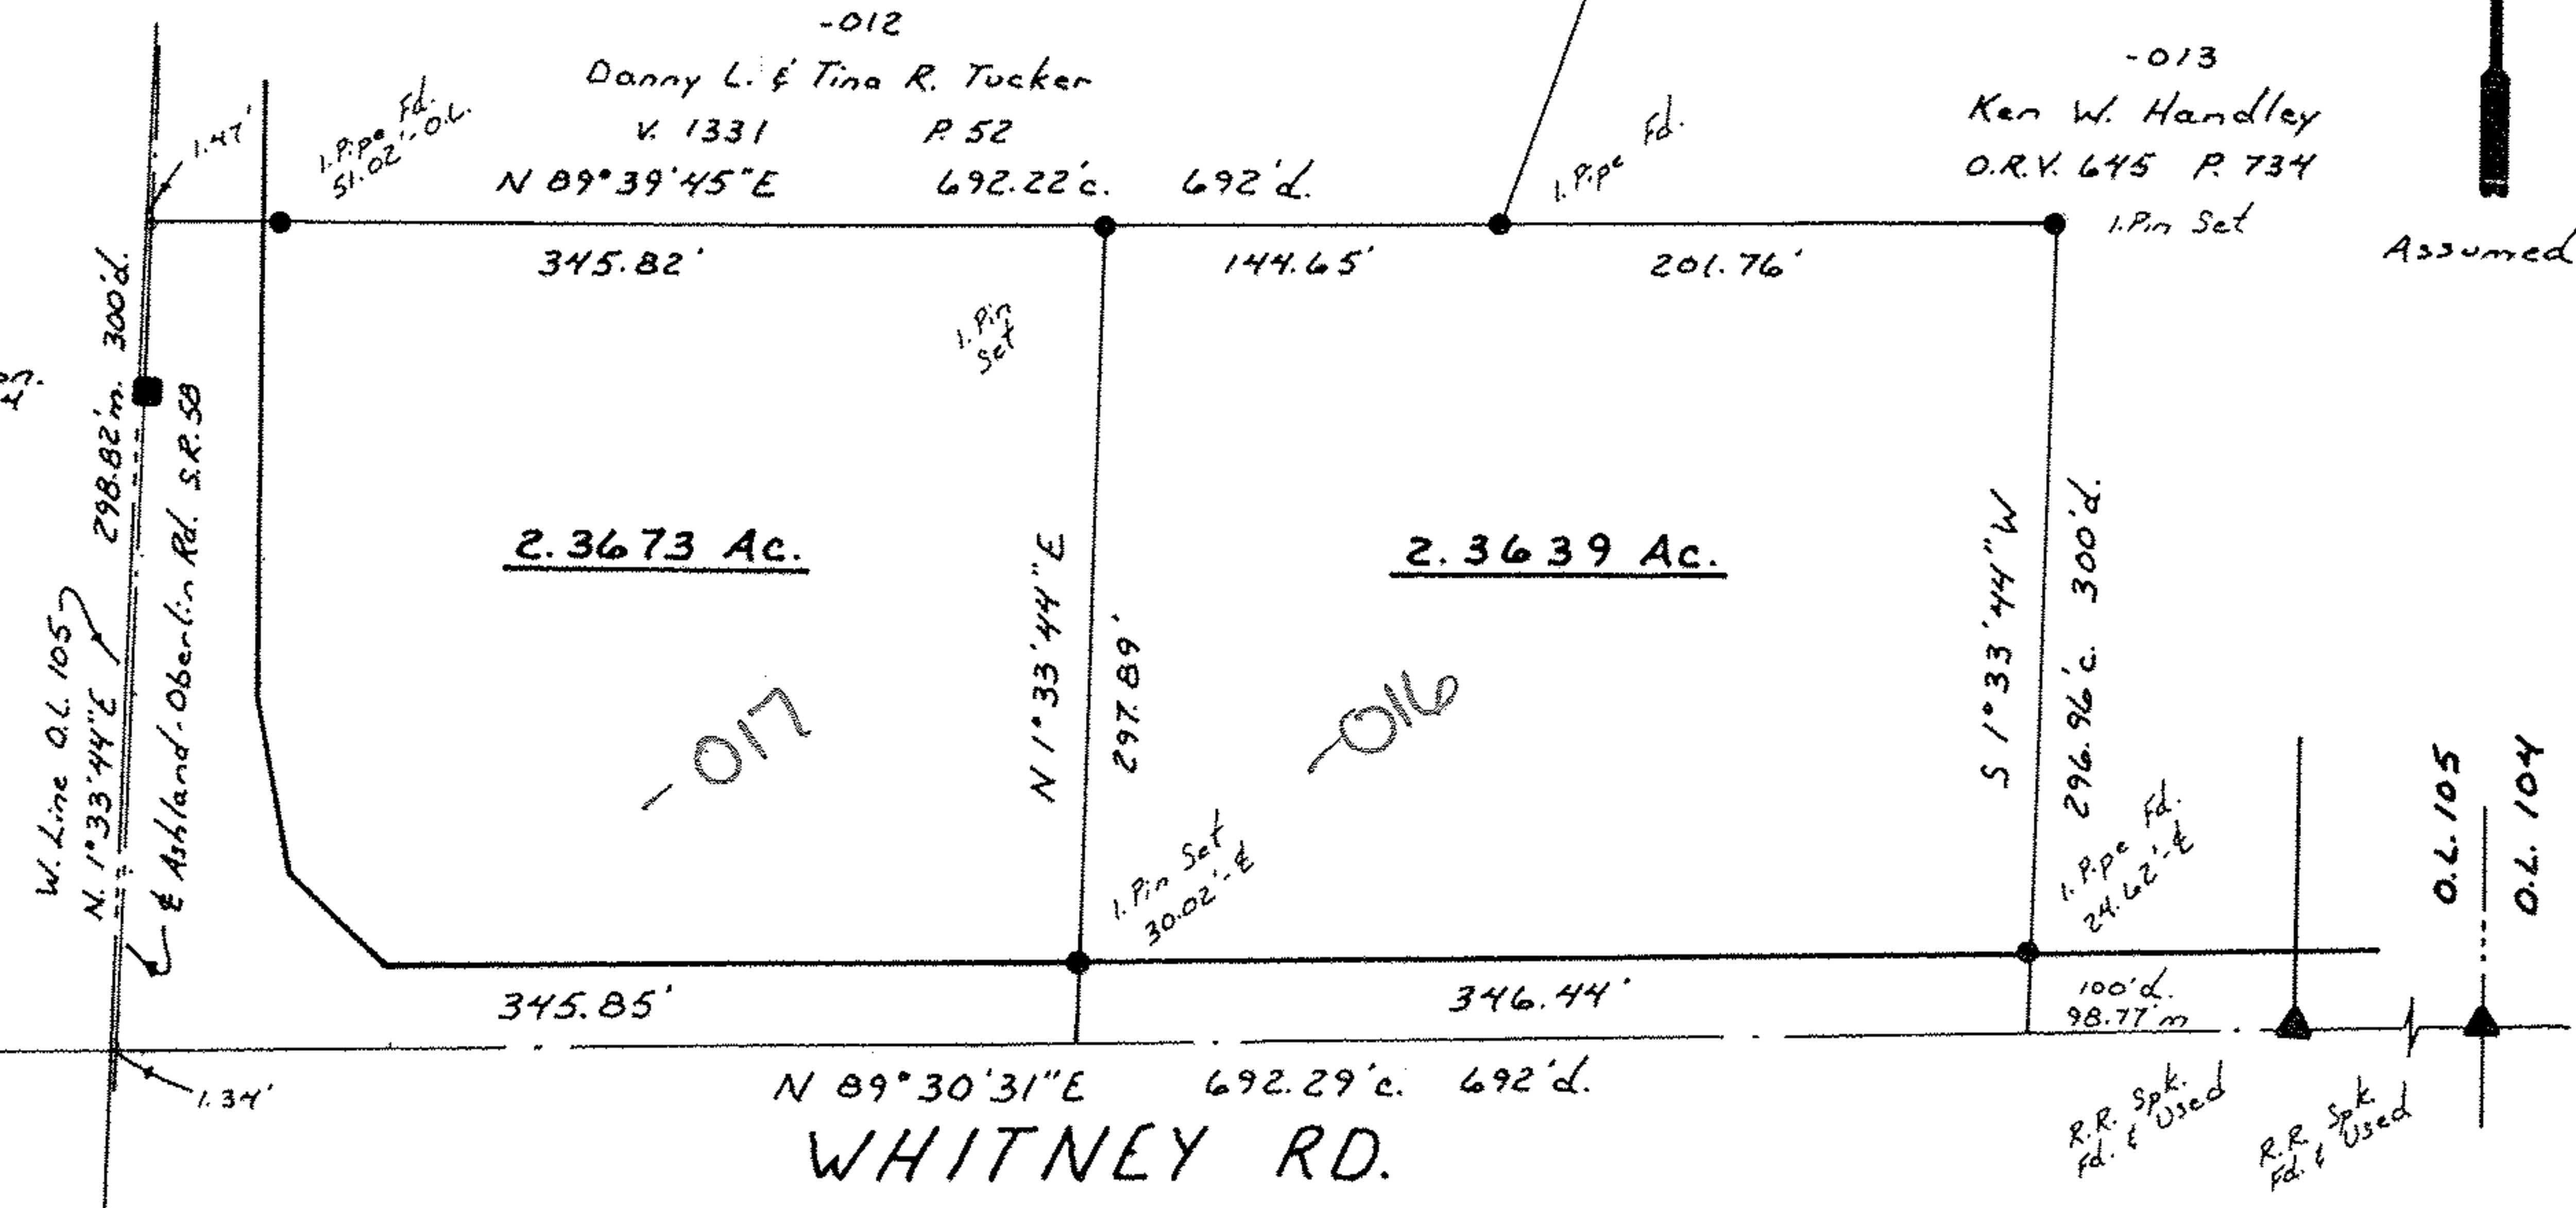

Survey For
MAXINE LAISY
 P.H.S. Field Twp.
 Lorain Co.
 CARLSON SURVEYS
 P.P. No. 14-00-105-000-003
 440-926-0200

00859
 APPROVED
 LORAIN CO.
 MAP DEPT
 DATE 9-10-01
 PAGE 14-G
 BY JHATFIELD
 *01-00859

This survey represents the minimum standards for boundary surveys in the State of Ohio as adopted 5-1-80 of the Administrative Code chapter 4733-37

Job No. 1401-01
 July 2001
 Scale: 1" = 100'