PLAT OF SURVEYS FOR HAROLD L. HAYES & RALPH HAYES

ORIGINAL LOT NO. 148 PITTSFIELD TWP.
LORAIN COUNTY OHIO
SCALE: 1"=100'
JULY 1, 1972
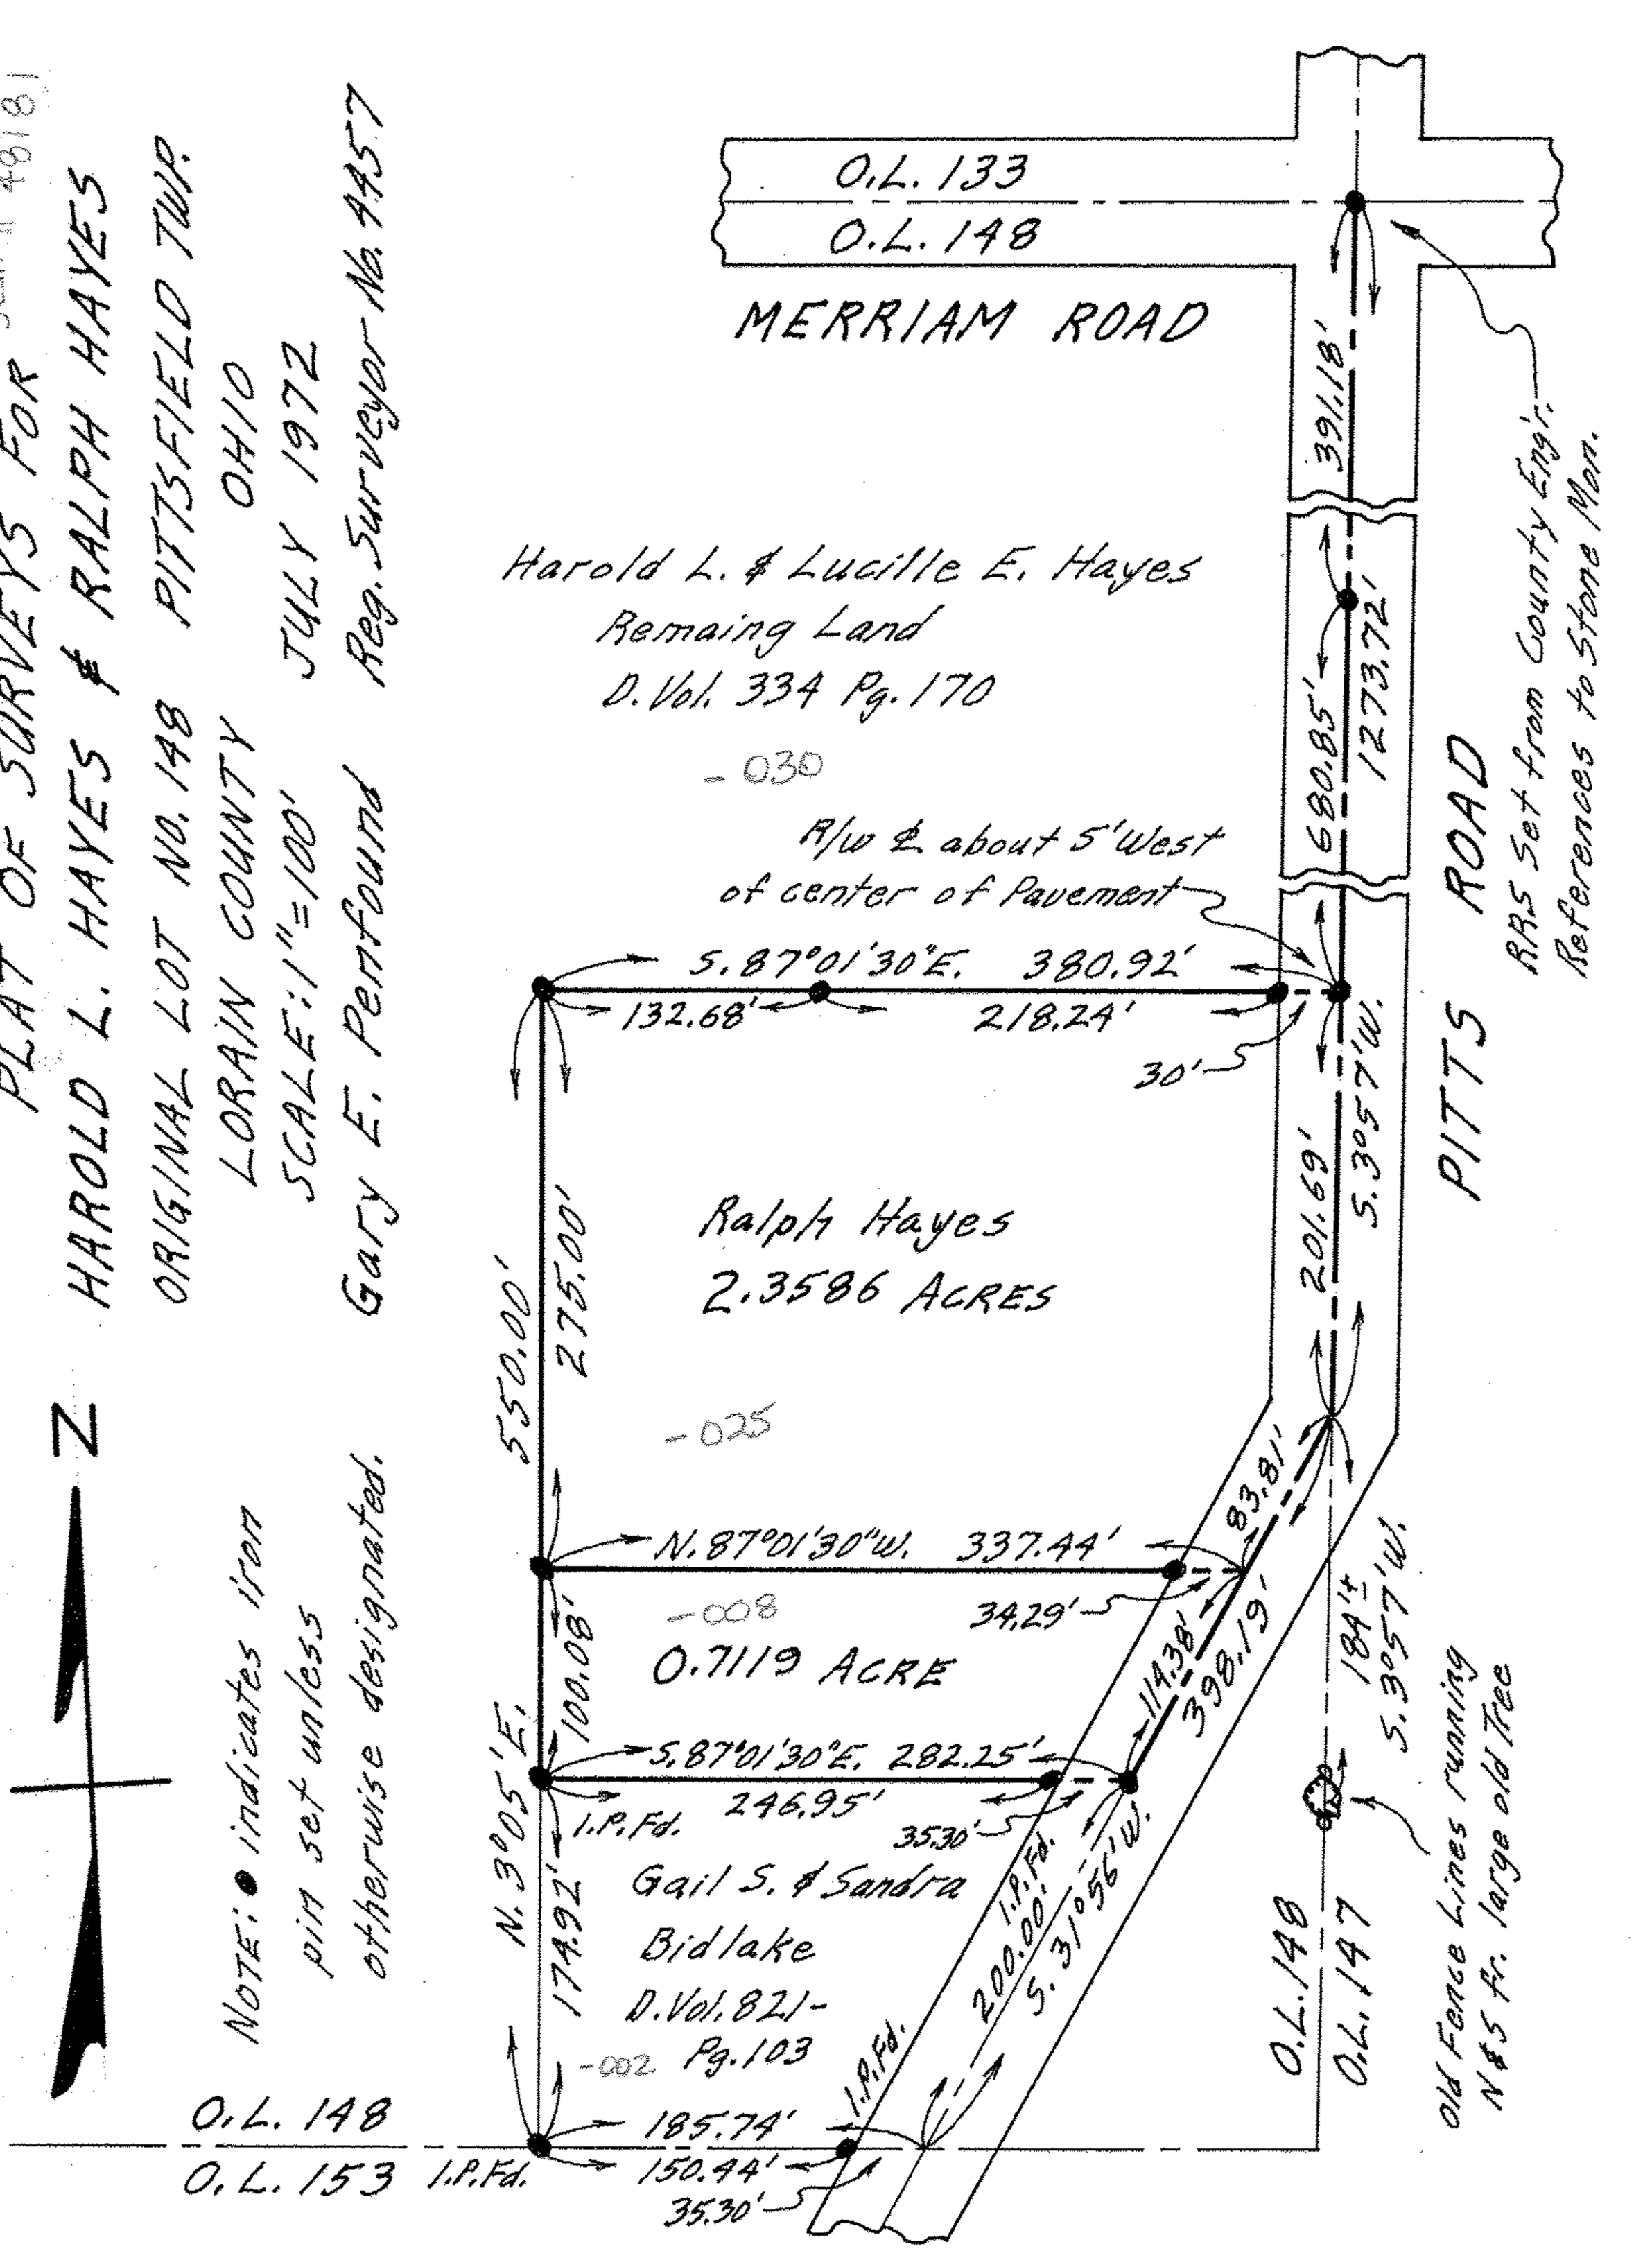
Gary E. Penfound
Reg. Surveyor-No. 4857