Scan # 48184

15-D #17142 15-00-008-000

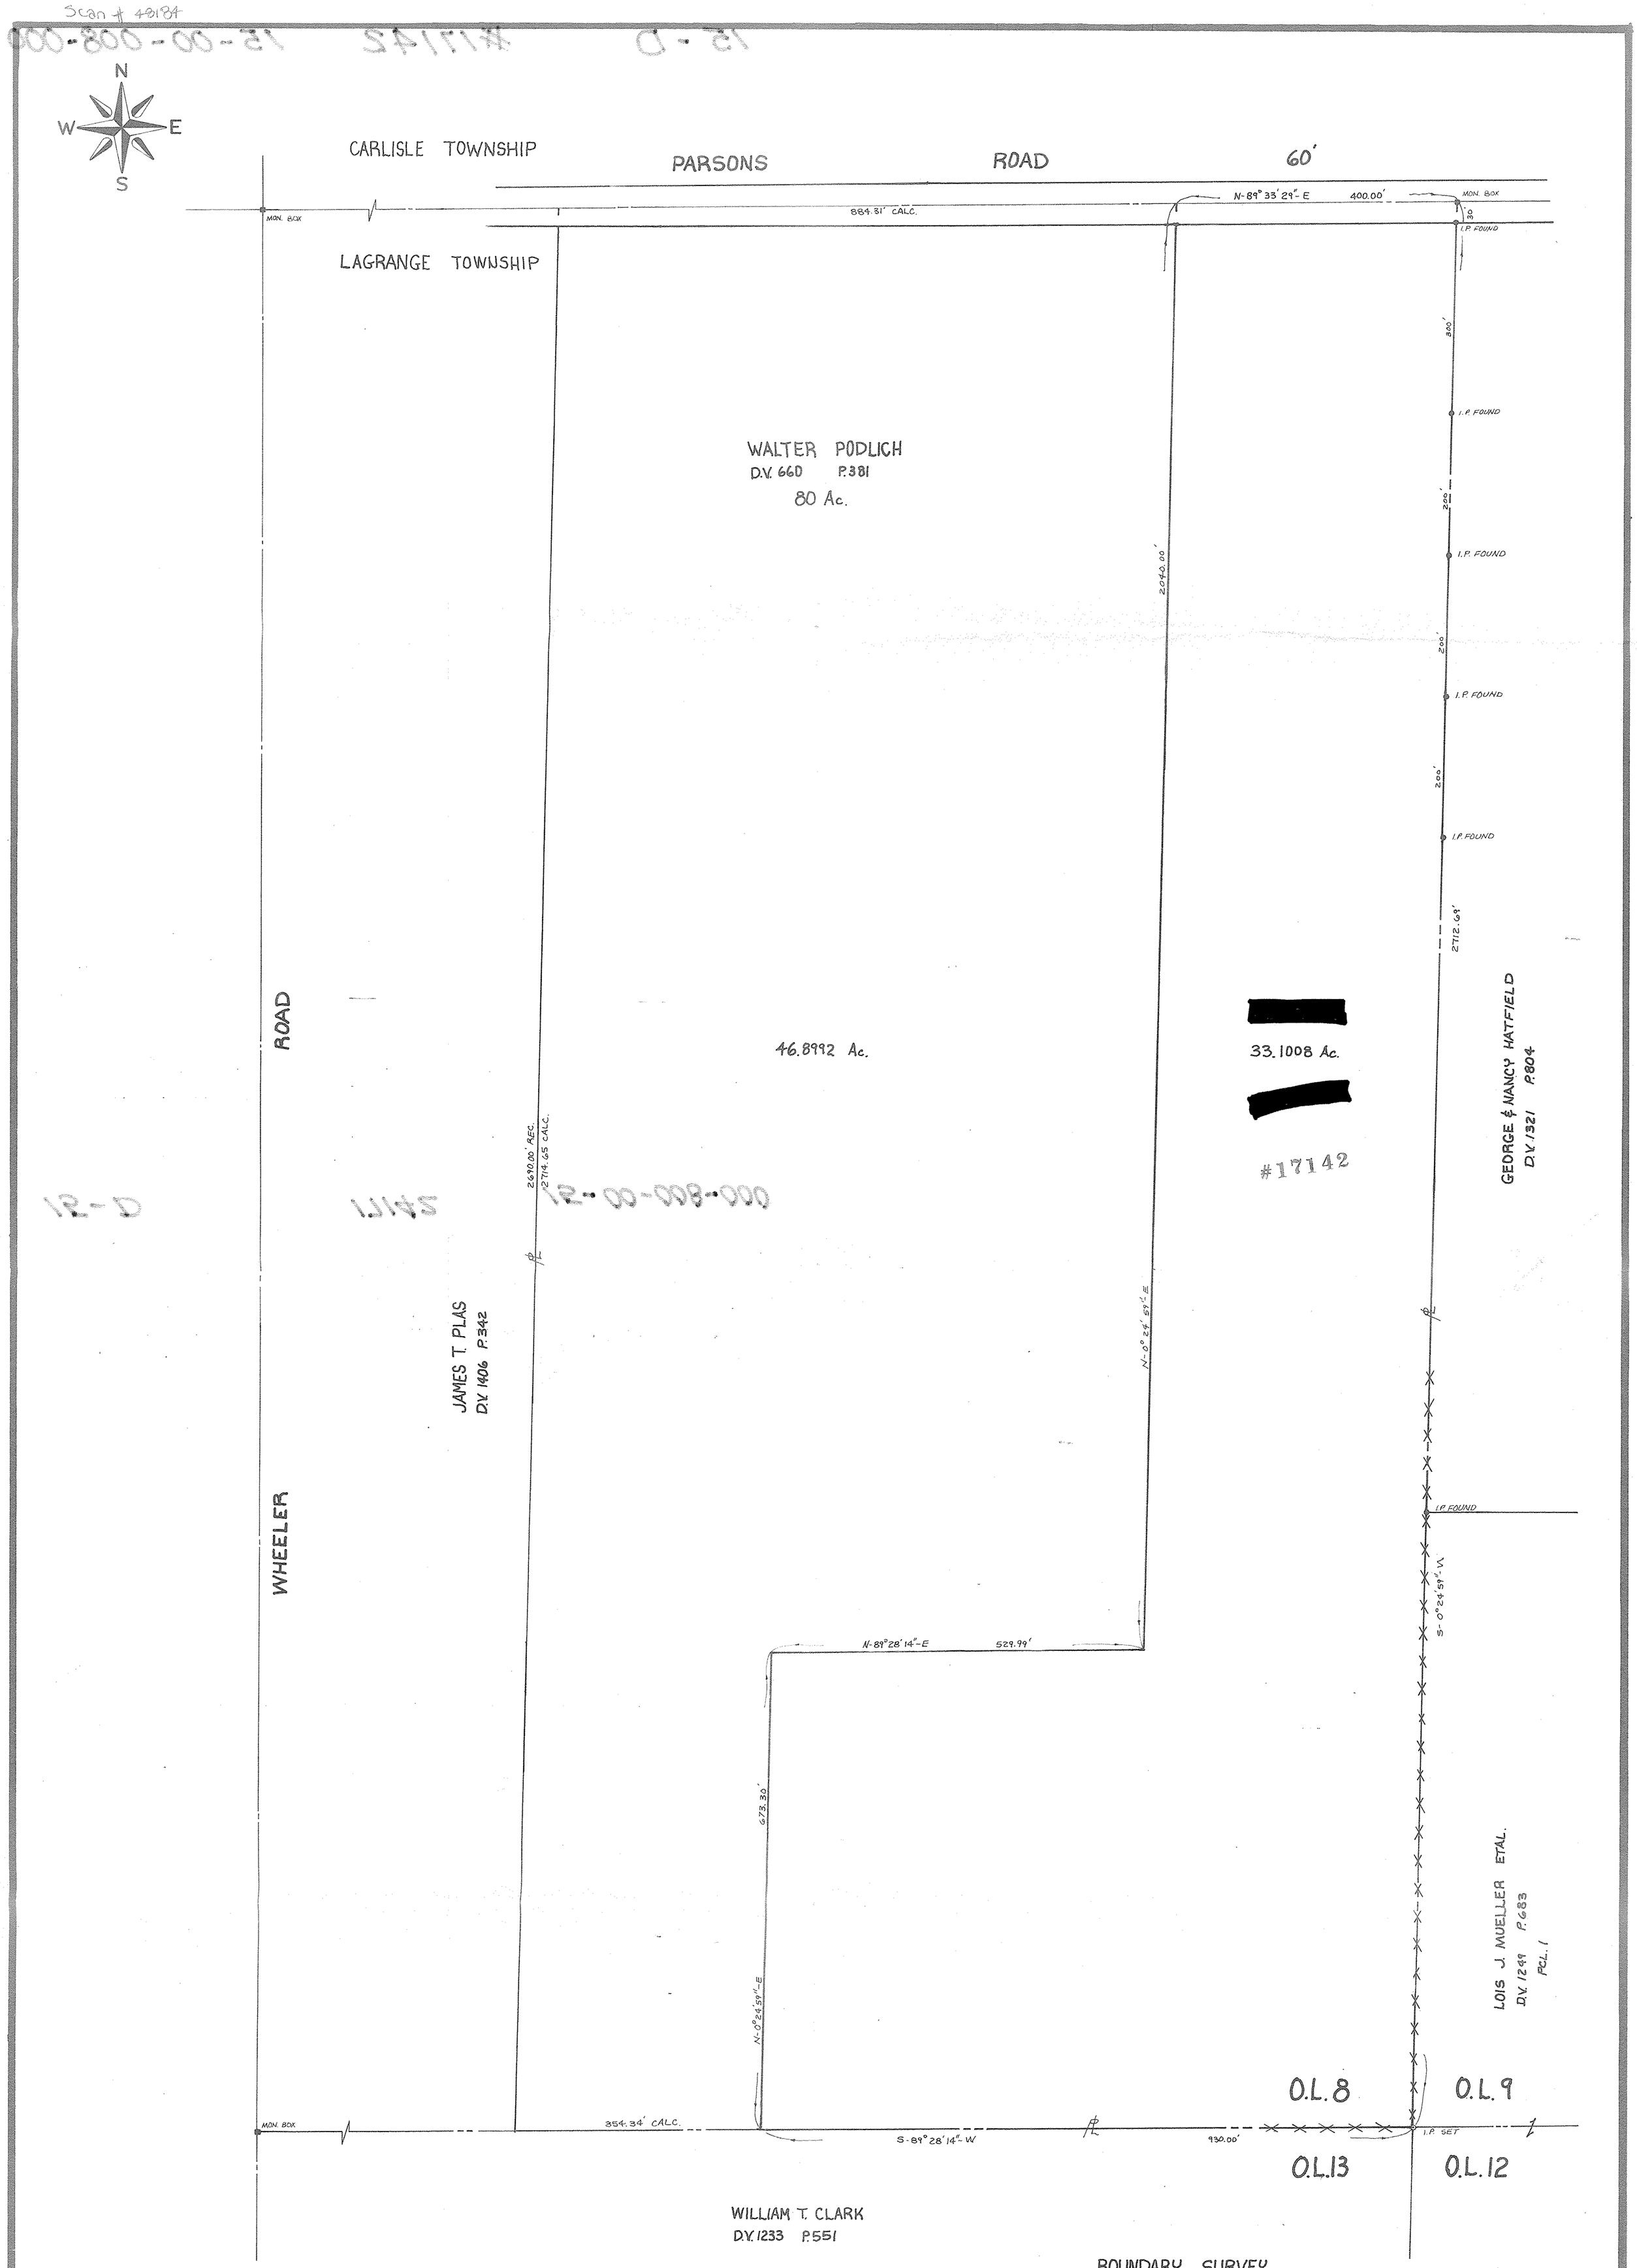

BOUNDARY SURVEY

PART OF LaGRANGE TWP. ORIGINAL LOT № 8

COUNTY of LORAIN — STATE of OHIO

SCALE: 1" = 100' — NOVEMBER 6, 1986

PREPARED BY

KLEINOEDER - SCHMIDT & ASSOCIATES
CONSULTING ENGINEERS — SURVEYORS

#17142

APPROVED
LORAIN CO.
MAP DEPT.
DATE 12-8-86
15-D
C. FRANCIS
ZONE AFTER 17142

86-230