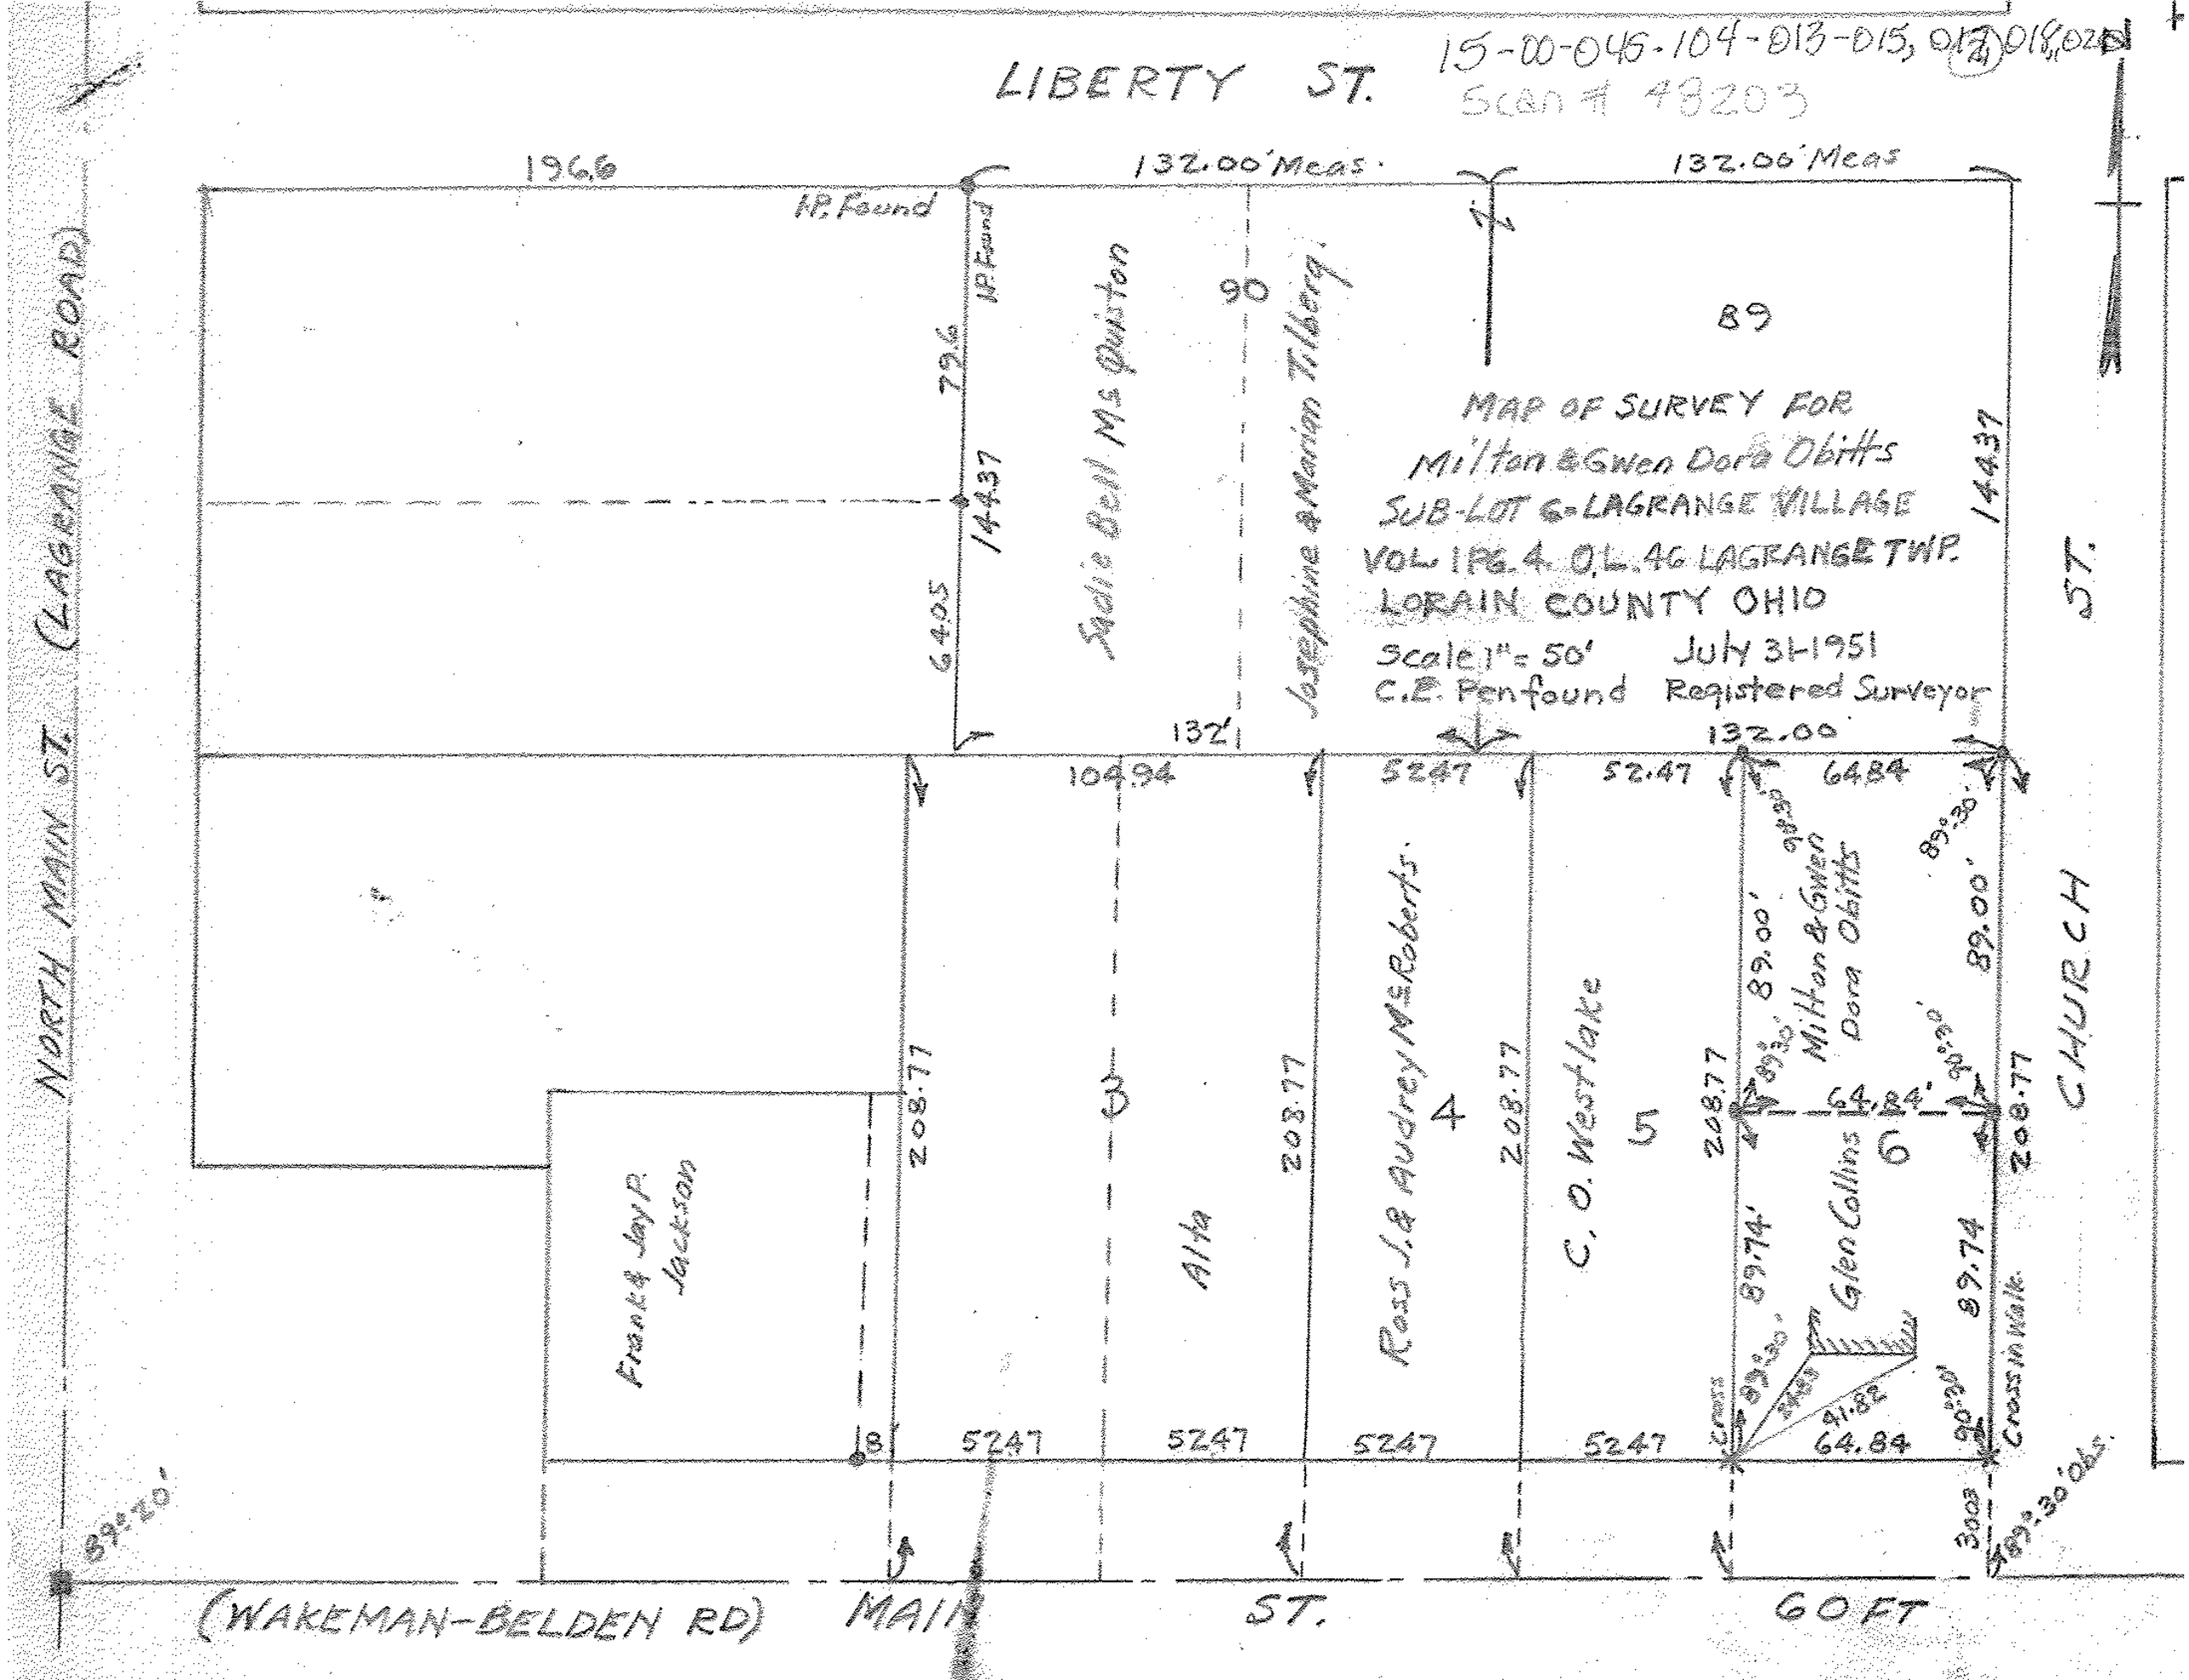

15-00-045-104-013-015, 017, 018, 020
Scan # 48203
LIBERTY ST.
196.6
132.00' Meas.
132.00' Meas
I.P. Found
I.P. Found
79.6
144.37
64.05
Sadie Bell Ms Quiston
90
Josephine & Marian Tilberg
89
MAP OF SURVEY FOR
Milton & Gwen Dora Obitts
SUB-LOT 6 - LAGRANGE VILLAGE
VOL. 1 PG. 4. O.L. 46 LAGRANGE TWP.
LORAIN COUNTY OHIO
Scale 1" = 50'
July 31-1951
C.E. Penfound
Registered Surveyor
144.37
132'
132.00
104.94
52.47
52.47
64.84
NORTH MAIN ST. (LAGRANGE ROAD)
CHURCH ST.
208.77
208.77
208.77
208.77
208.77
3
4
5
6
Alta
Ross J. & Audrey McRoberts
C. O. Westlake
Milton & Gwen Dora Obitts
Glen Collins
Frank & Jay P. Jackson
89.00'
89.00'
89.74'
89.74
64.84'
41.82
64.84
Cross
Cross in Walk
5247
5247
5247
5247
3003
89°30' Obs.
89°20'
(WAKEMAN-BELDEN RD)
MAIN ST.
60 FT