
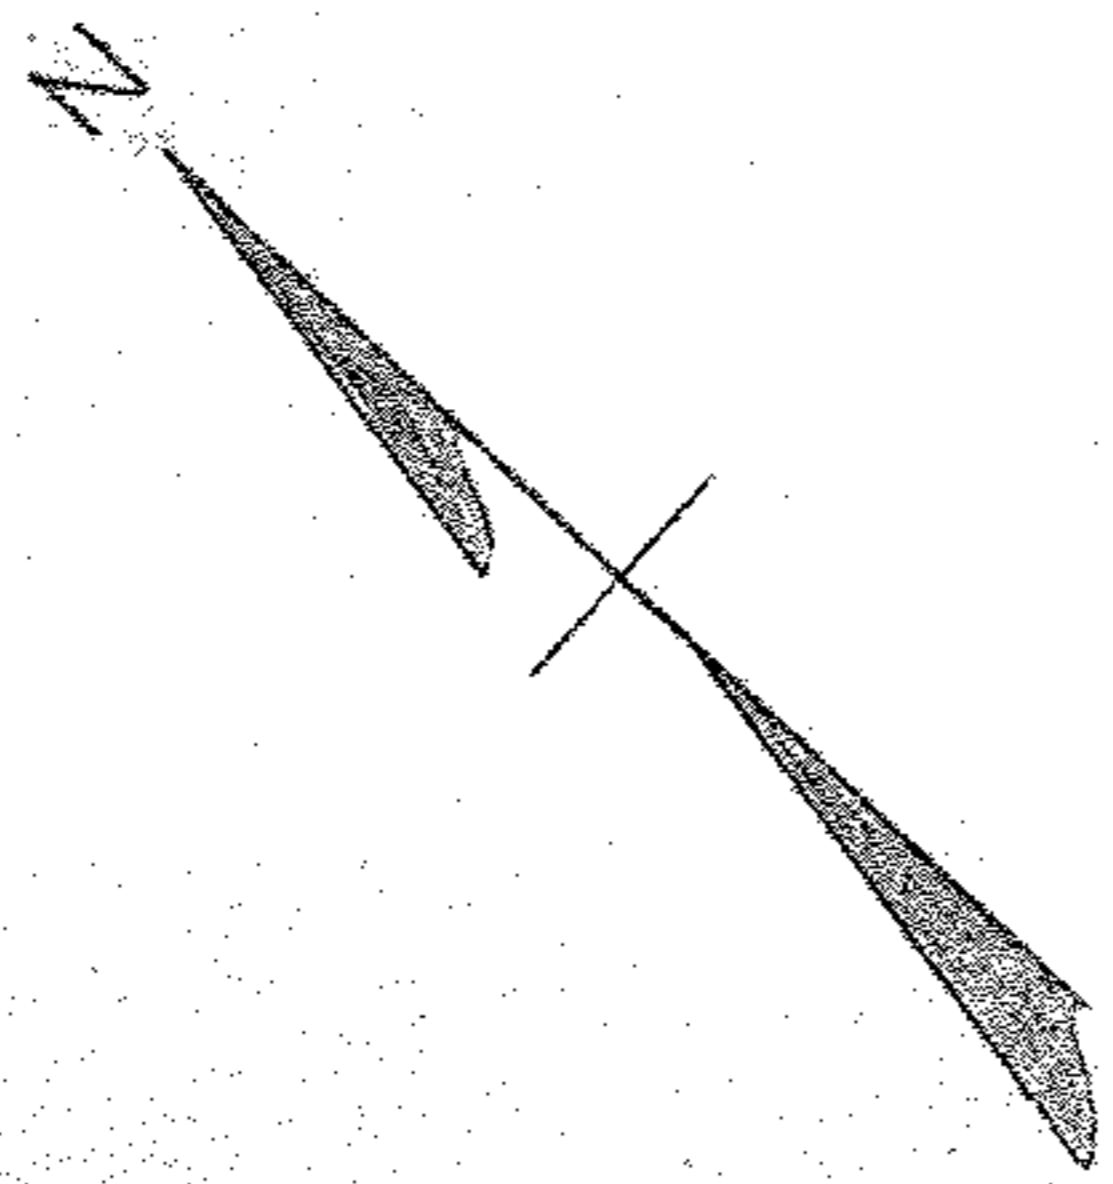


RAILROAD STREET 66'

N. 47° 35' E.

121505' by survey made
95 used and
cleared

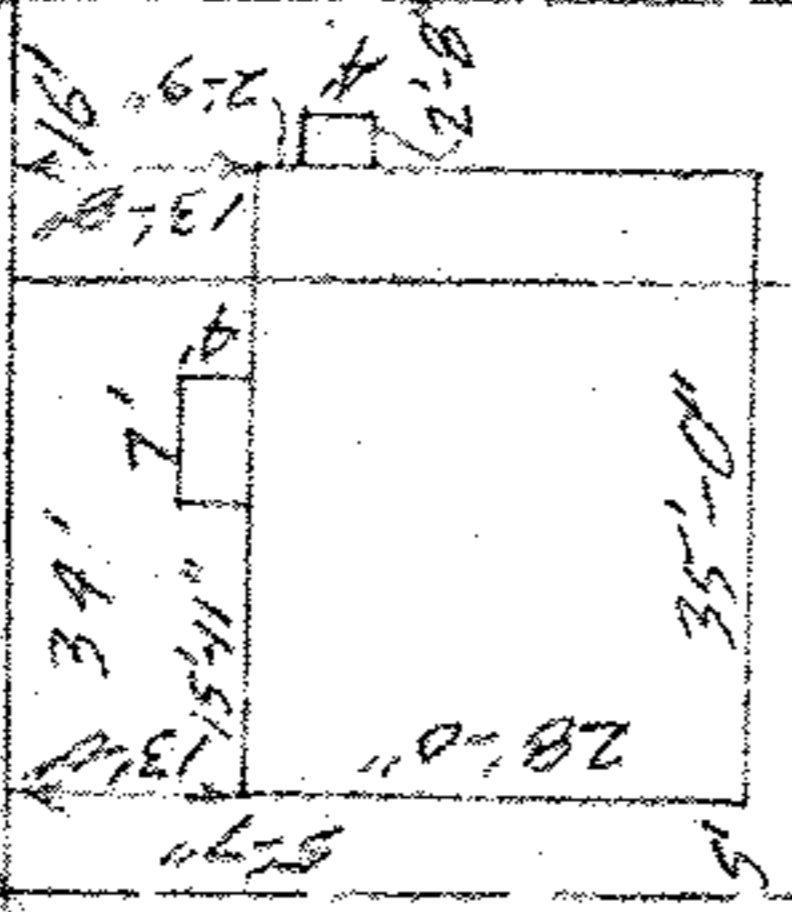

N. 42° 25' W. 165'

S. 42° 25' E. 165'


Order No. E-9726
Jacob & Verdic Boisek

114A

115

50.0'
34' 16'
66' 5.47° 35' W.

MAP OF EASTERLY 34' OF SUB-LOT 114 AND
WESTERLY 16' OF SUB-LOT 115
ORIGINAL PLAT OF LAGRANGE VILLAGE Vol. 1 P. 10
ORIG. LOT 55 LAGRANGE TWP. - LORAIN CO. - OHIO
SCALE: 1" = 30'
Gang E. Perfound
for C. E. Perfound REG. SURVEYORS
NOV. 10 - 1959 3:30 P.M.

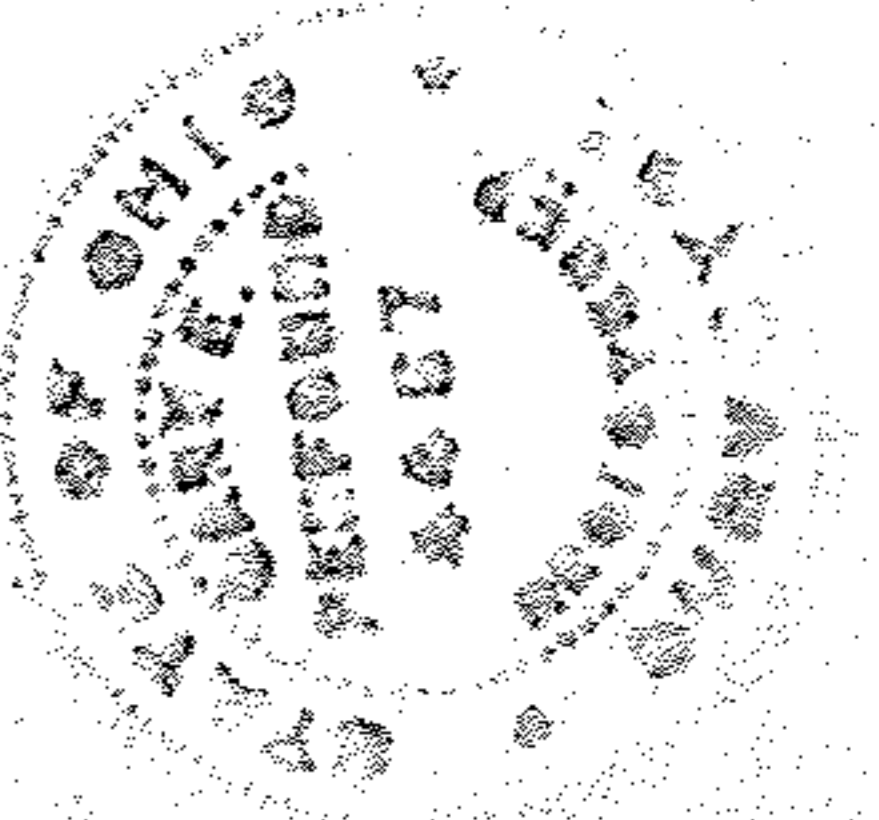

66
1/2
66/2
11232
61105
21505