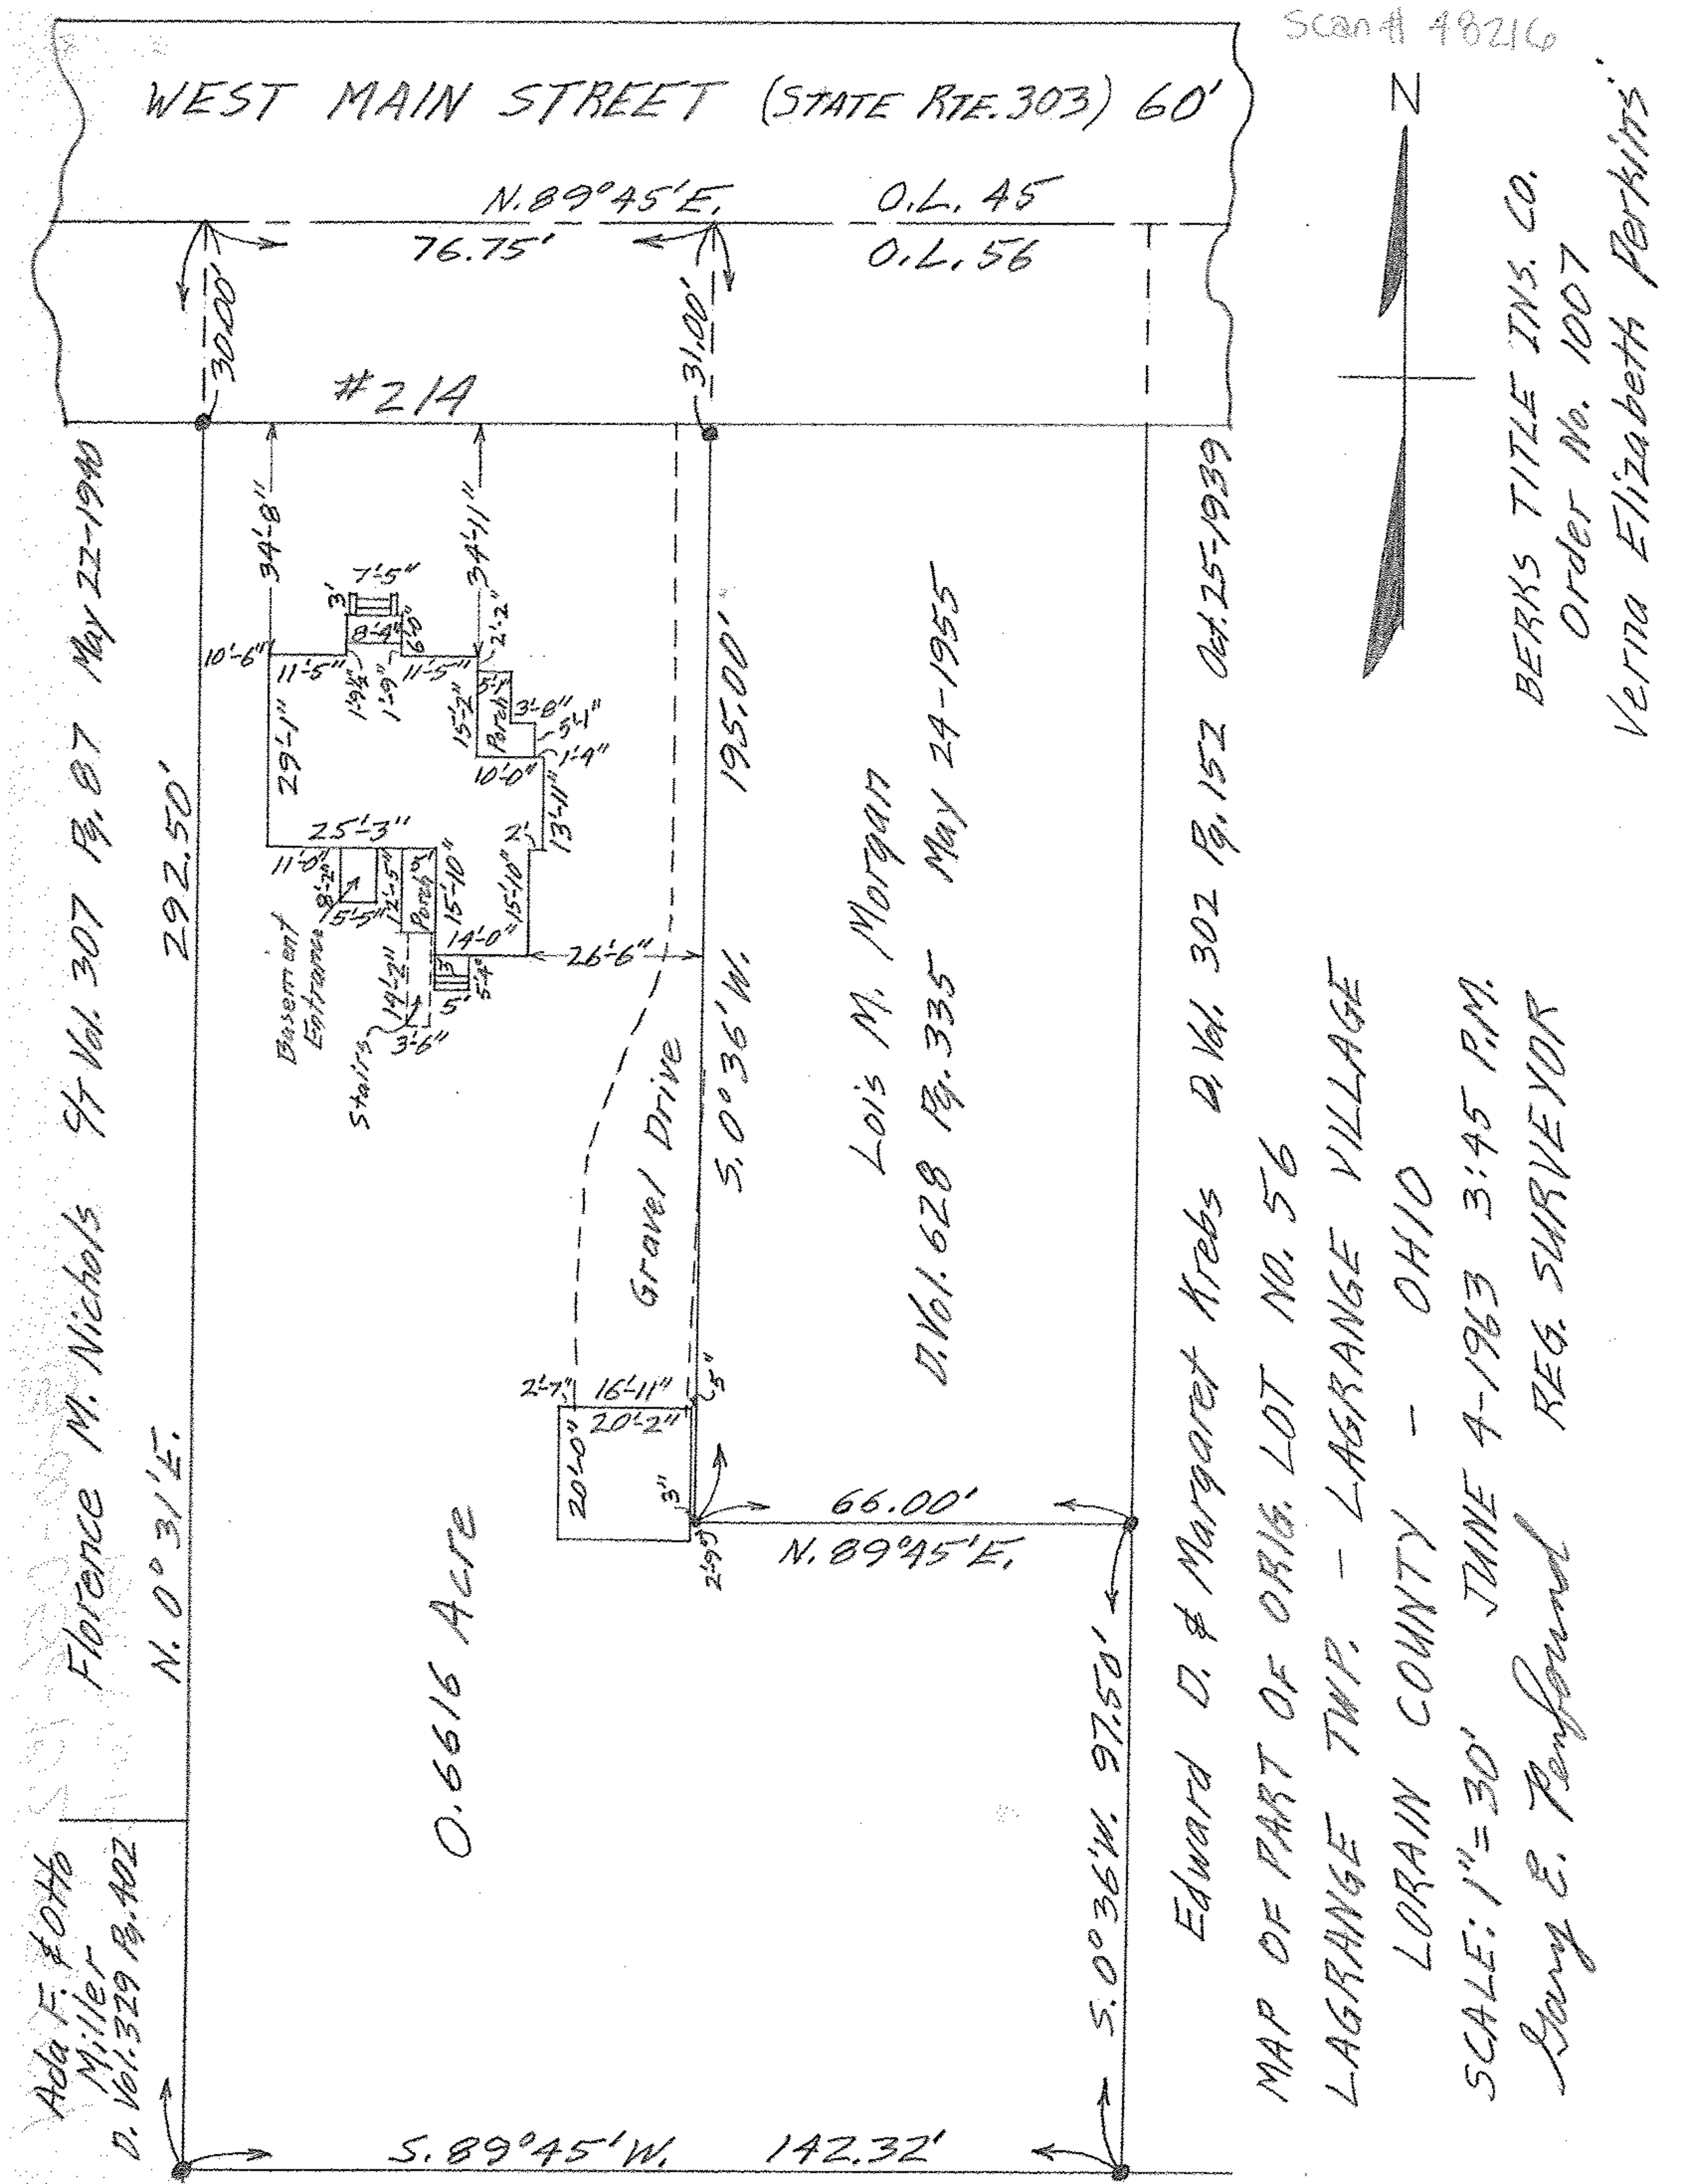

Scan # 48216
WEST MAIN STREET (STATE RTE. 303) 60'
N. 89°45'E.
O.L. 45
O.L. 56
76.75'
30.00'
31.00'
#214
N
BERKS TITLE INS. CO.
Order No. 1007
Verna Elizabeth Perkins
Florence M. Nichols S/T Vol. 307 Pg. 87 May 22-1940
N. 0°31'E.
292.50'
Ada F. & Otto Miller D. Vol. 329 Pg. 402
Edward D. & Margaret Krebs D. Vol. 302 Pg. 152 Oct. 25-1939
Lois M. Morgan D. Vol. 628 Pg. 335 May 24-1955
S. 0°36'W.
195.00'
Gravel Drive
0.6616 Acre
66.00'
N. 89°45'E.
S. 0°36'W. 97.50'
S. 89°45'W. 142.32'
34'-8"
34'-11"
29'-1"
25'-3"
26'-6"
Basement Entrance
Stairs
Porch
Porch
Porch
MAP OF PART OF ORIG. LOT NO. 56
LAGRANGE TWP. - LAGRANGE VILLAGE
LORAIN COUNTY - OHIO
SCALE: 1" = 30' JUNE 4-1963 3:45 P.M.
Gary E. Penfound REG. SURVEYOR