

#18632


15.00.063.000.013, 033, 034

PARENT 011, 031,
SCAN # 48225

Exhibit A

L.A.L.
D.M.F.
J.A.R.
D.A.P.
W.P.

David & Judith Long
65,586 Acres
Remainder

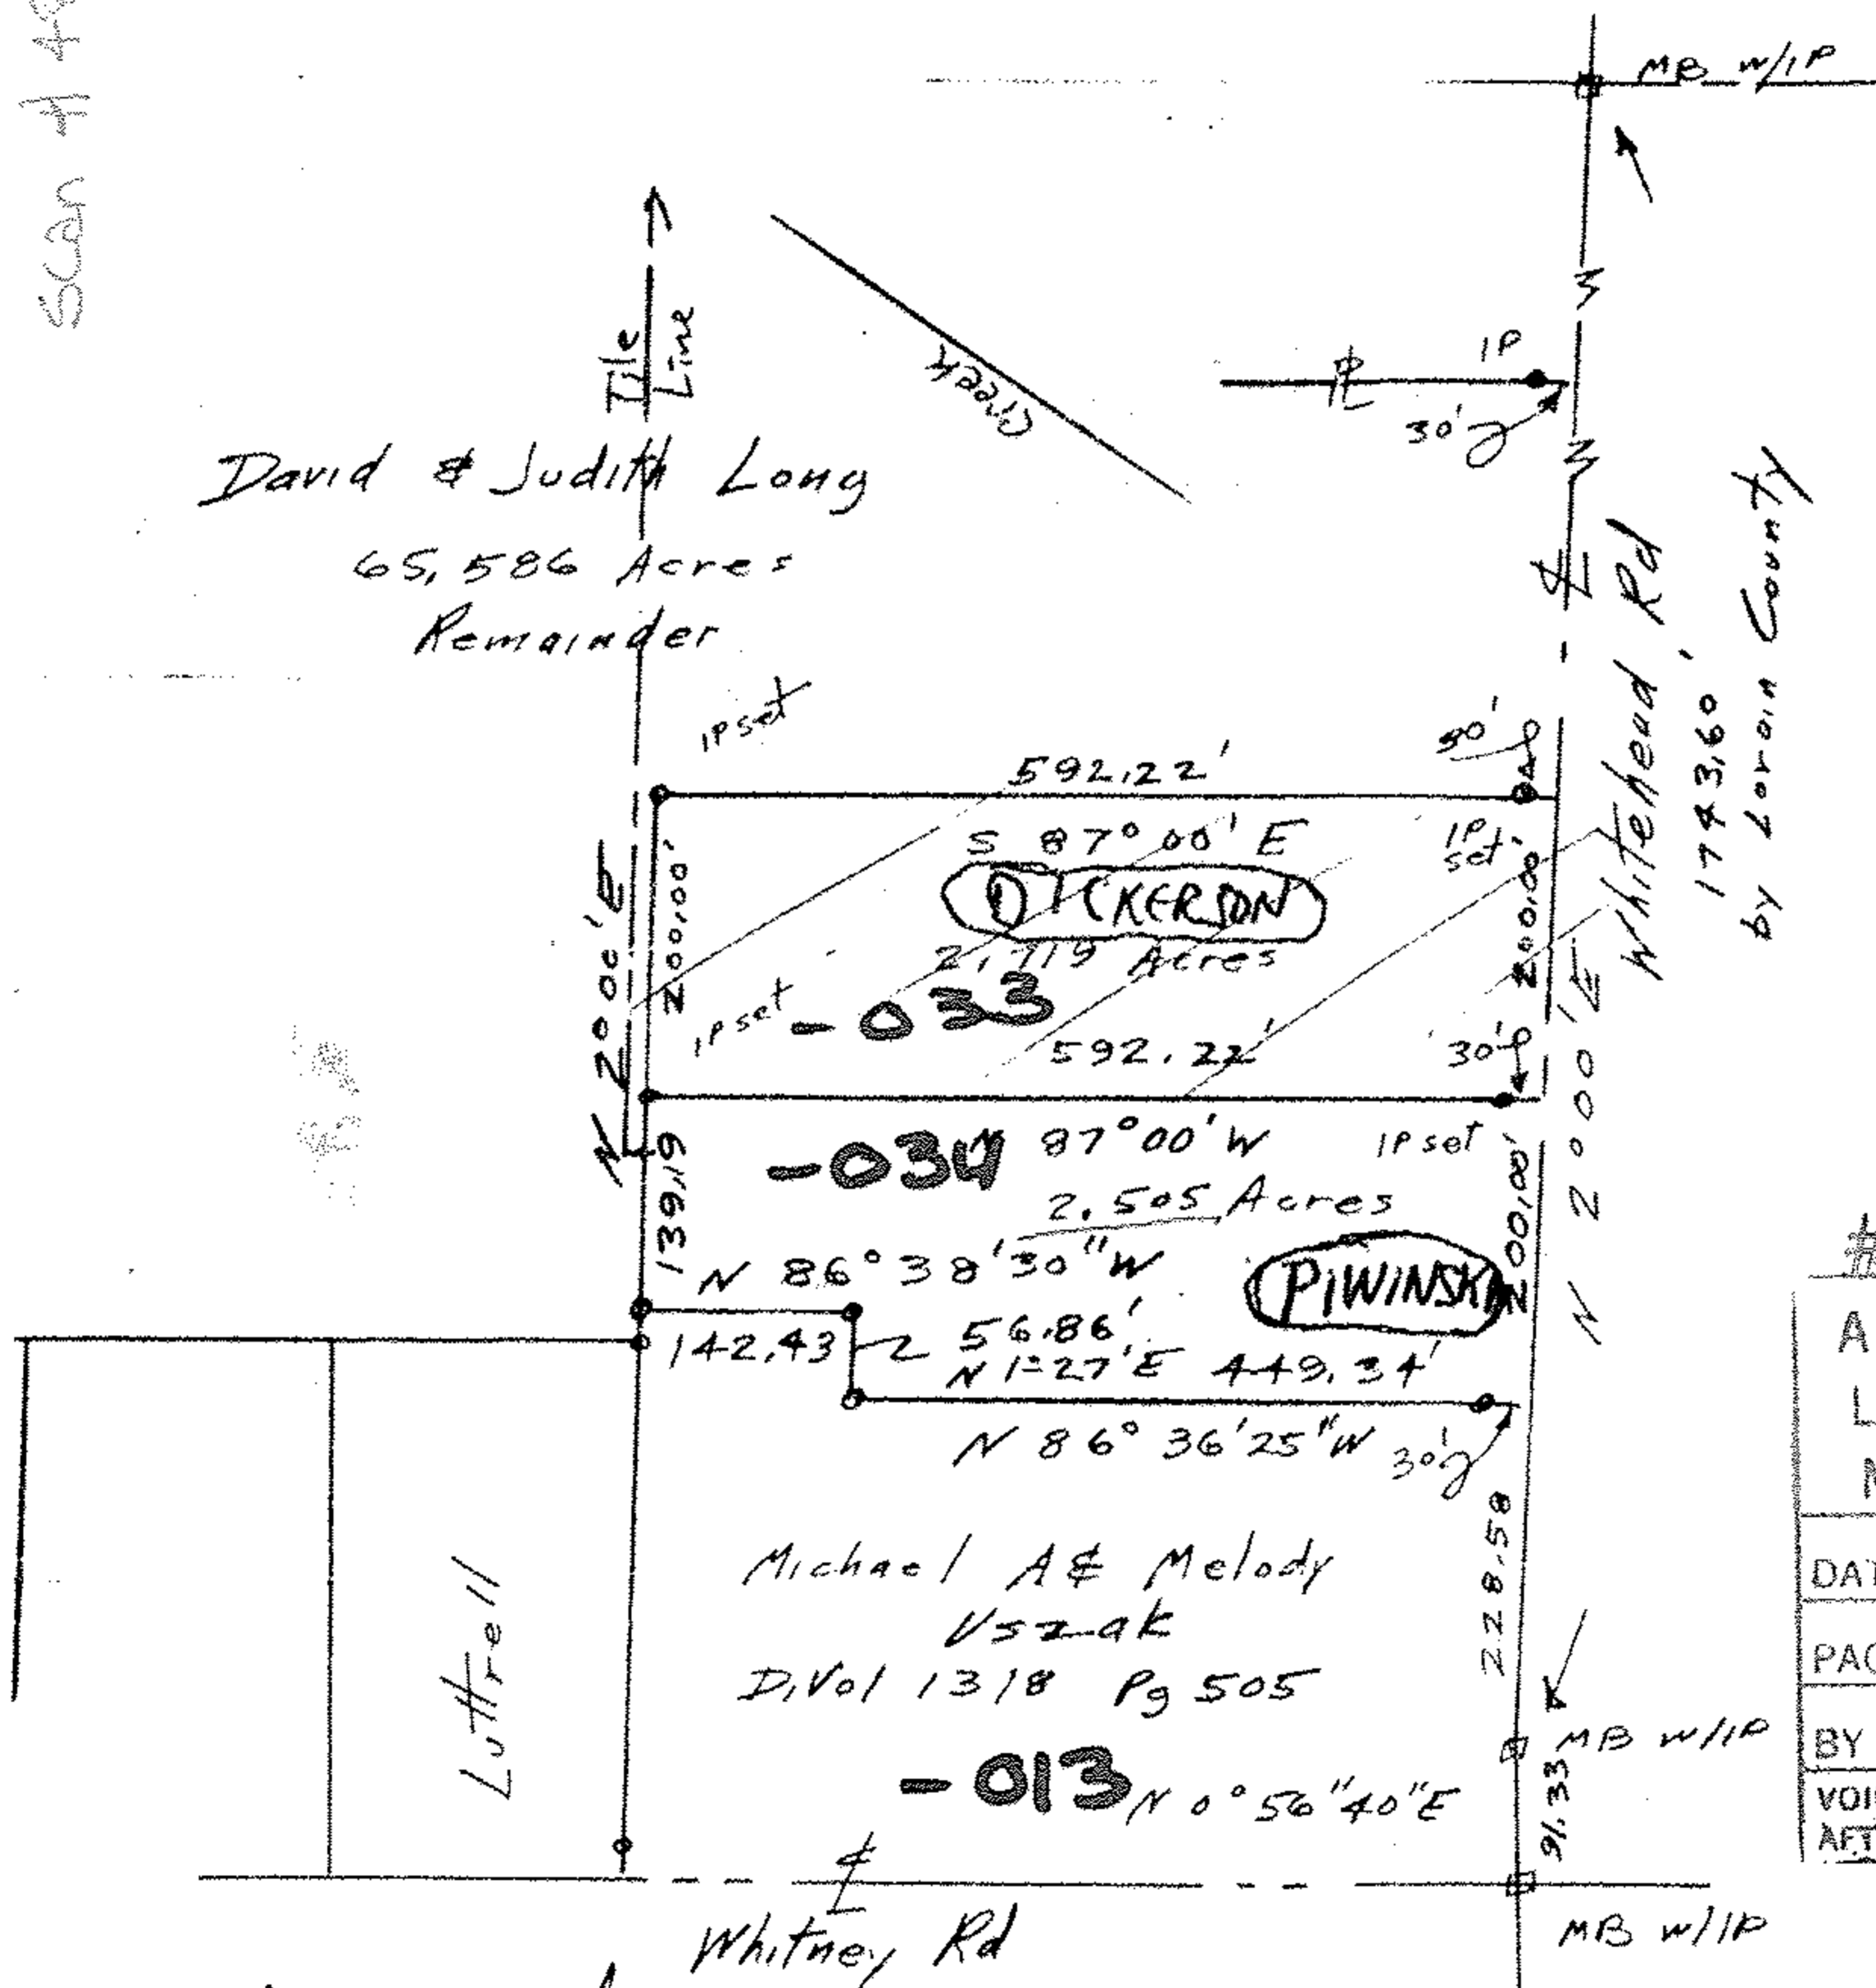

#18632

APPROVED
LORAIN CO.
MAP DEPT.

DATE 9-14-89

PAGE 15-E

BY CAROLYN
FRANCIS

VOID
AFTER # 18632

Michael A & Melody
Vszak
Divol 1318 Pg 505

John Pozywak
Surveyor
5292

ORIGINAL LOT 63 DATE June 2, 1989

TOWNSHIP La Grange SCALE 1" = 200

CITY OF N/A FIELD BOOK N/A

COUNTY OF Lorain DRAWN BY J. Pozywak

STATE OF OHIO CHECKED BY _____

W. O. _____ FILE NO. _____

15-E