


15.00-070.000-016, 047, 048
 051.000-008, 019, 020

Scan # 40227

1500.070.016, 047

DIV 1341 Pg 11
 Patricia Jo Pick ETAL

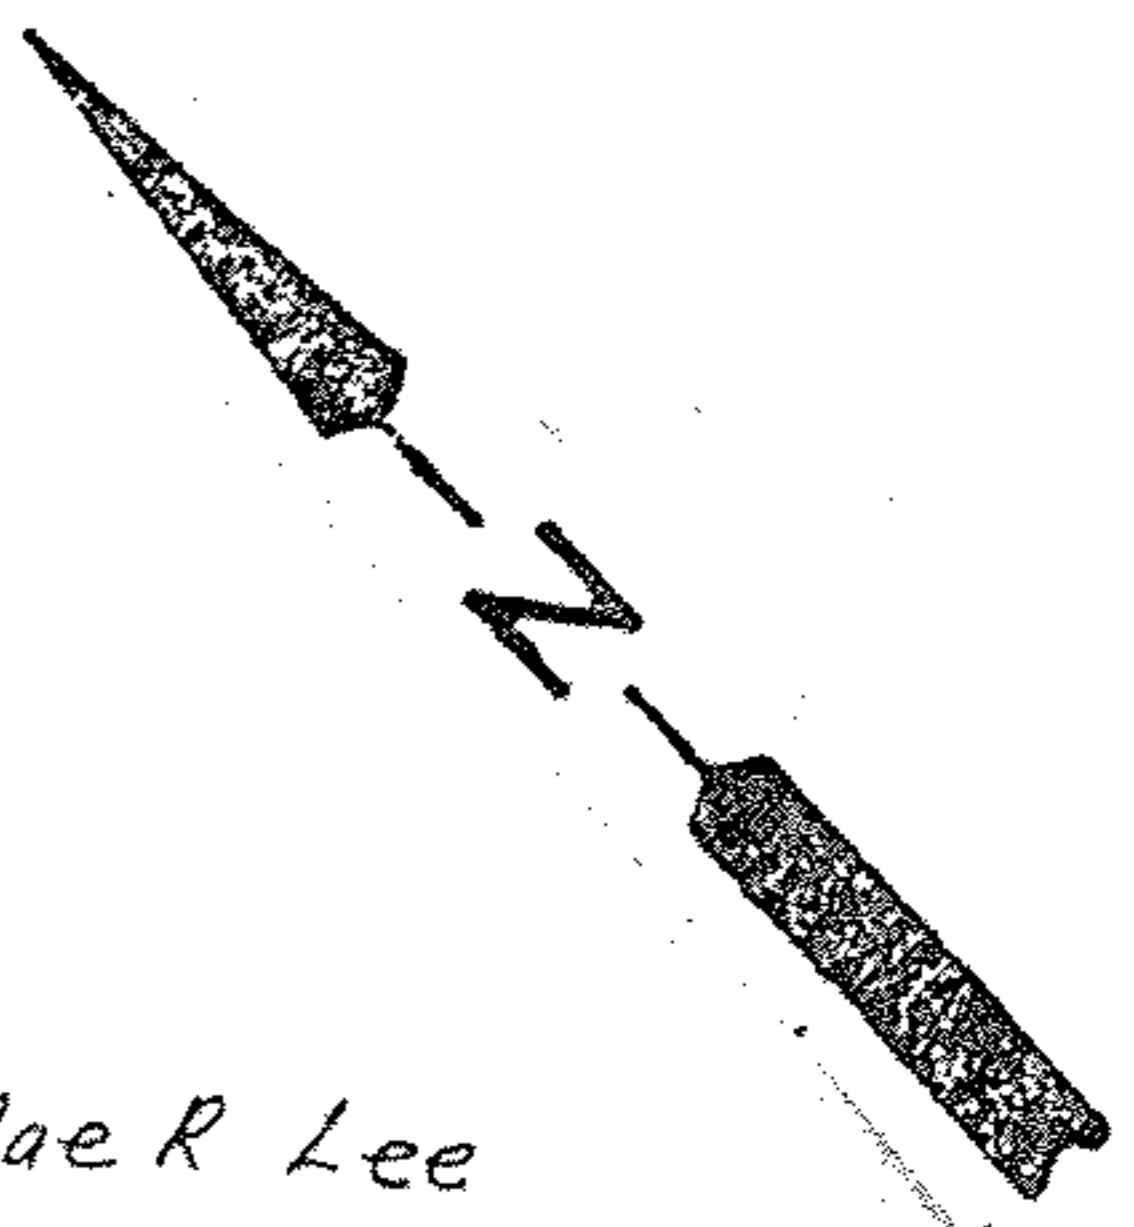

Charles B & Mae R Lee
 DIV 1085 Pg 943

Center
 Showed Black N River Graphically
 Glen Buswell
 DIV 759 Pg 47

#00471

APPROVED
 LORAIN CO.
 MAP DEPT

DATE 7.5.00

PAGE 15-H


BY T-McVain

#00-00471

24.44 Acres
 SUBTRACTED
 REM.

SEE C.M.C.
 SHEET ATTACHED

Glen H & Ruth Buswell
 OR 846 Pg 152

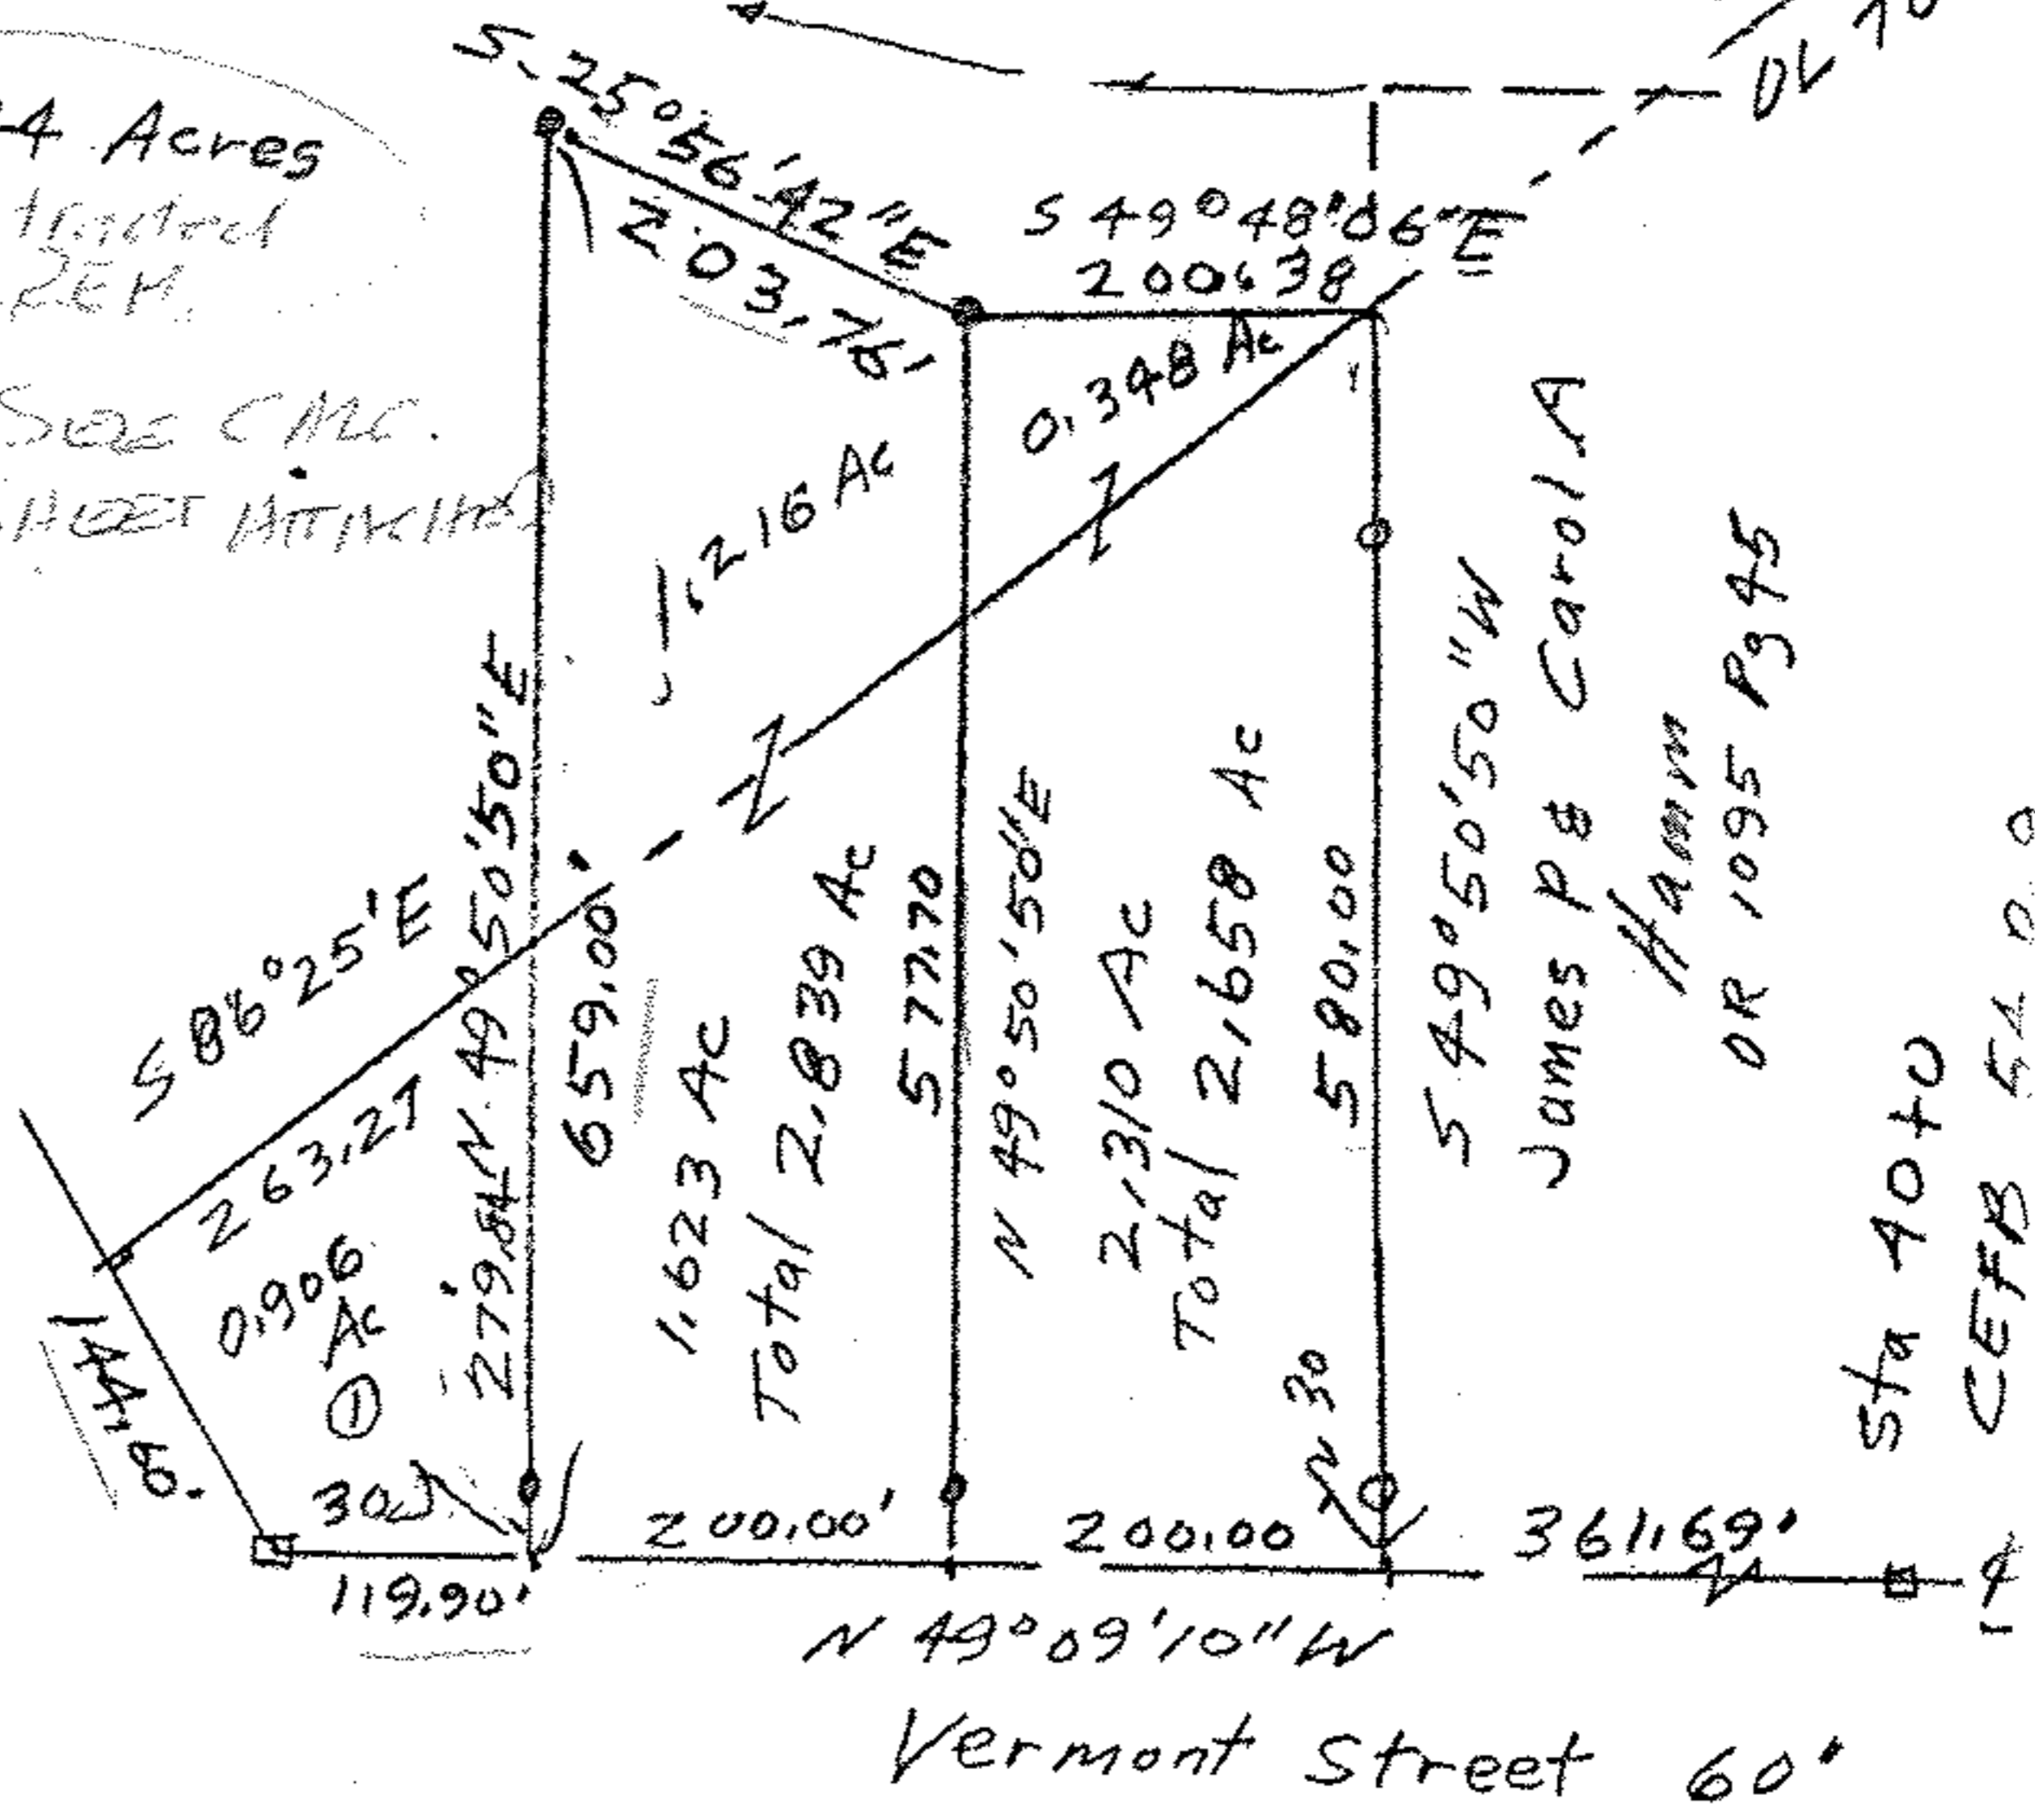

James P & Carol A
 Hamm
 OR 1095 Pg 95

Sta 40+0
 CEFB 54.0.0

o Iron pins fd
 o Iron pins set
 o Monument boxes

STATE OF OHIO
 JOHN POZYWAK
 5292
 REGISTERED
 SURVEYOR

Survey of Parcel splits
 Glen Buswell
 Original Lot 70 OL 51?
 LaGrange Township
 Scale 1" = 200' Nov 1999
 John Pozzywak
 Rev's June 2000