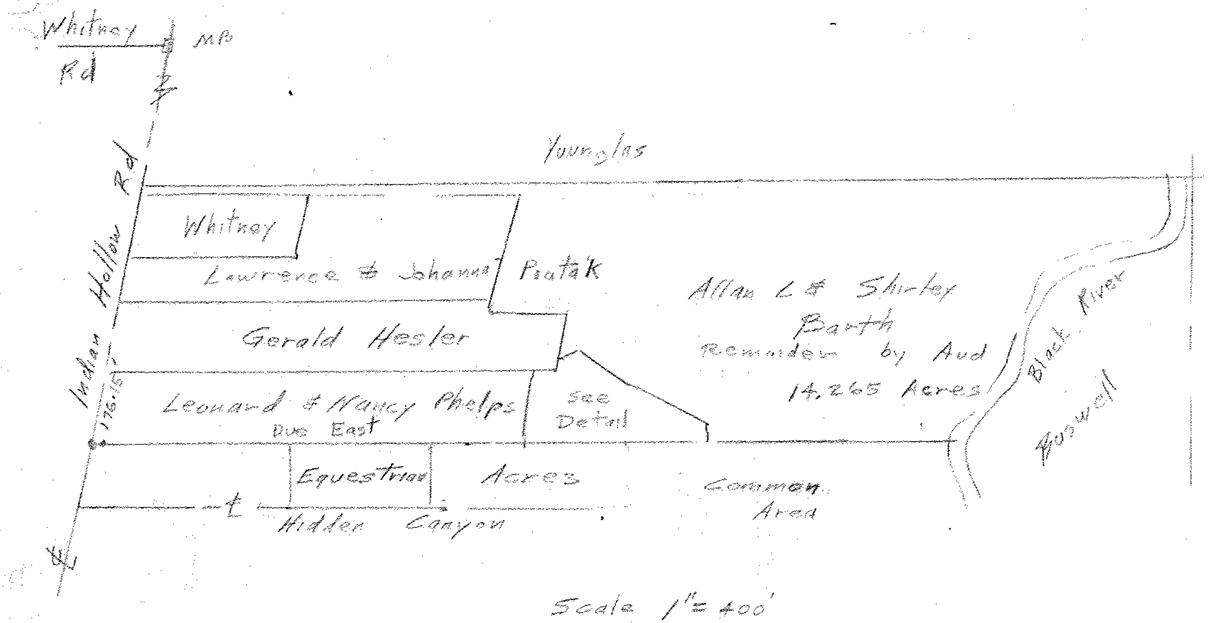


Scale 1" = 400'

Survey of a parcel split
for
William Kruger
Part of Original Lot 72
La Grange Township
Lorain County Ohio
Sept 1992

Allan L & Shirley Barth
Remainder by Auditor
14.265 acres

John Pozywak
Reg Surveyor
5292

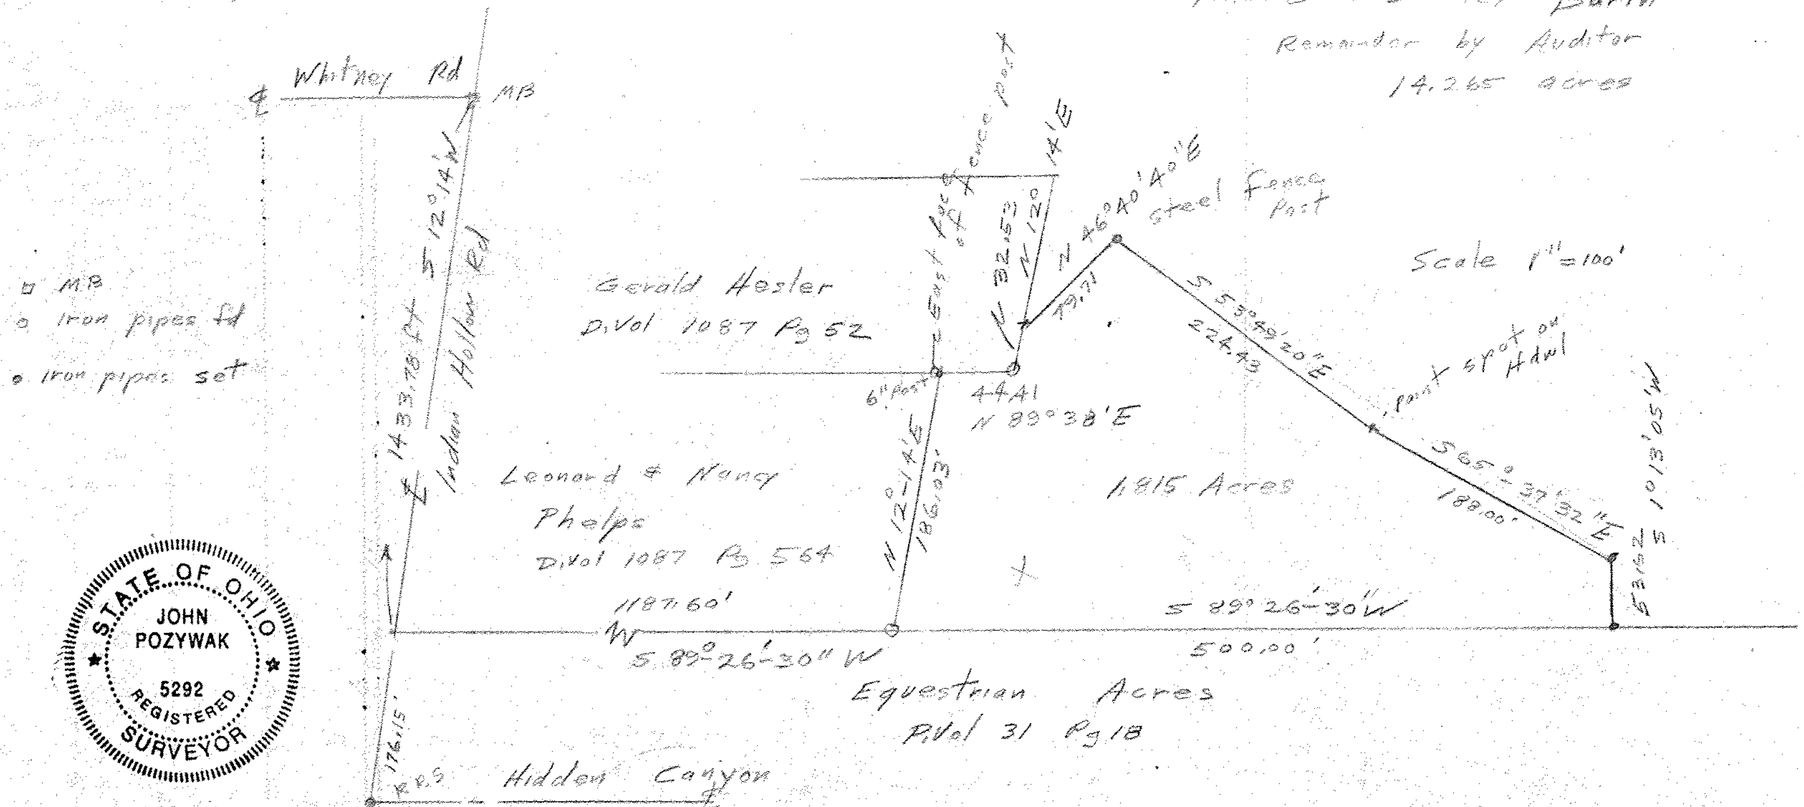

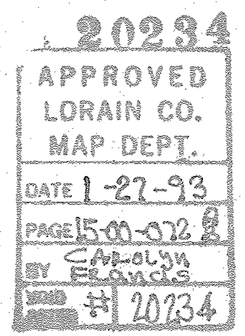
- MB
- ○ Iron pipes fd
- ● Iron pipes set