16-00-003-A

16.00.003.03.011

HICKORY STREET 60'

S. 89°53'30" W.

#1133

C=74.45' N. 87°28'16" W.

Δ=5°16'28" A=74.48'

I.P.

I.P.

525'

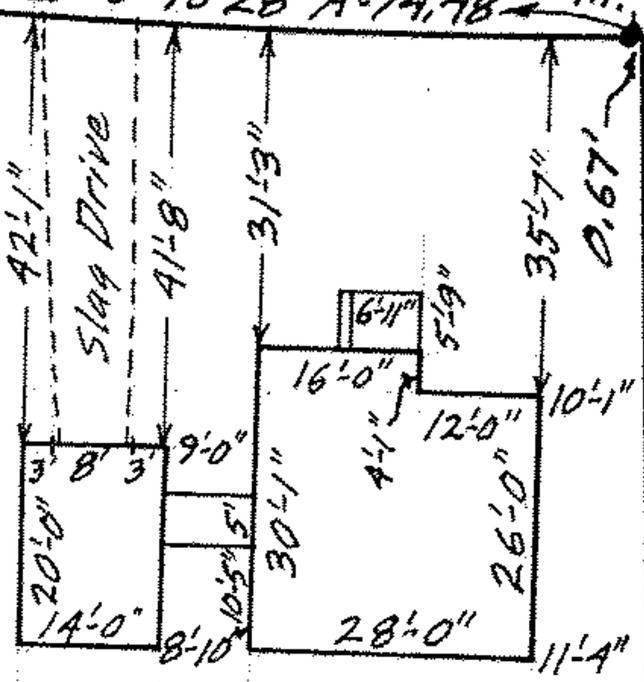

ST. 60'

WILLOW

NORTH

N. 0°45' W.

123.43'

153.43'

149.16'

N. 0°45' W.

30'

75.0'

S. 89°15' W.

23

24

25

N

BERKS TITLE INS. CO.
Order No. 1656

MAP OF SUB-LOT NO. 24
MYLES KNECHTGES SUB'N. NO. 2
VOL. 15 PG. 3 PLATS
O.L. 3 GRAFTON TWP. — GRAFTON VILLAGE
LORAIN COUNTY OHIO
SCALE: 1" = 30' JUNE 13-1966 8:00 P.M.
Gary E. Penfound REG. SURVEYOR