Scan 48292 16-00-029-000-010

16-D

PLAT OF SURVEYS FOR
EDMON E. & ELEANOR BOLEN

ORIGINAL LOT 29 GRAFTON TWP.
LORAIN COUNTY OHIO
SCALE: 1" = 100' JUNE & JULY 1972
Gary E. Penfound Reg. Surveyor No. 4457

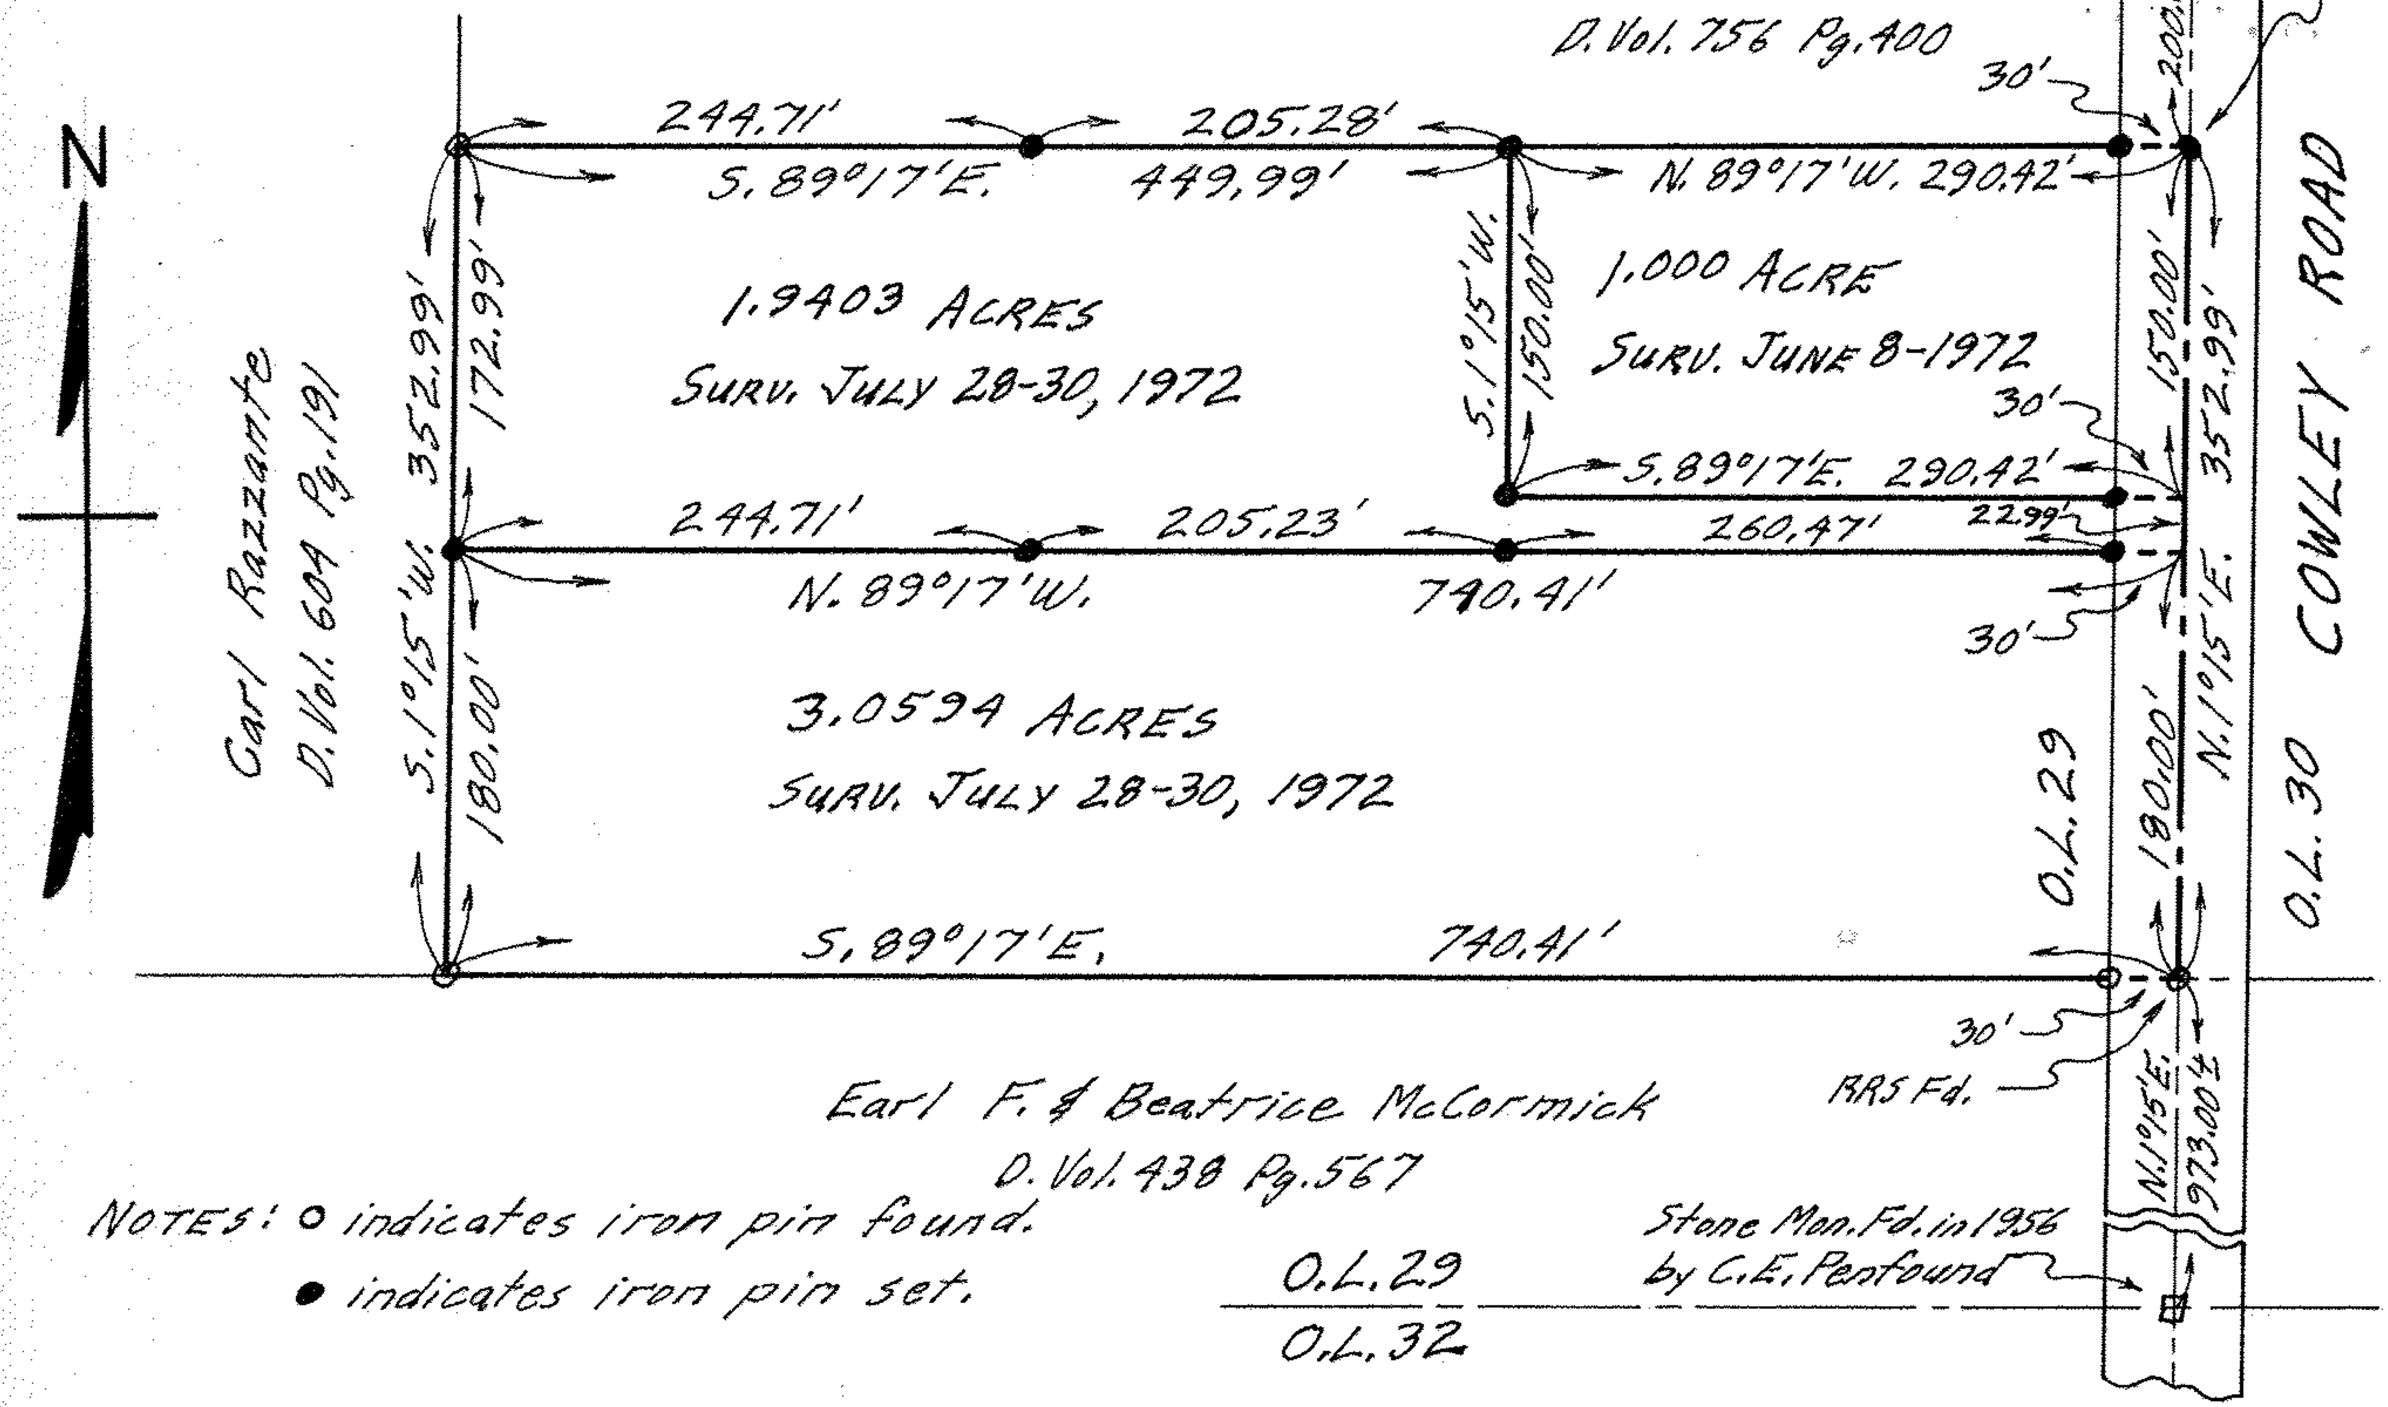

NOTES: ○ indicates iron pin found.
● indicates iron pin set.