

LEGAL DESCRIPTION OF PROPOSED LOT 1  
LORAIN COUNTY DEVELOPMENT, INC.

SITUATED IN ORIGINAL GRAFTON TOWNSHIP LOT NO. 49, COUNTY OF LORAIN, AND STATE OF OHIO, AND BEING FURTHER DESCRIBED AS FOLLOWS:

BEGINNING AT AN IRON PIN FOUND IN A MONUMENT BOX ON THE CENTERLINE OF COWLEY ROAD (60 FEET WIDE) AT THE NORTHEAST CORNER OF ORIGINAL GRAFTON TOWNSHIP LOT NO. 49, SAID POINT ALSO BEING THE NORTHEAST CORNER OF LAND CONVEYED TO LORAIN COUNTY DEVELOPMENT, INC. IN VOLUME OR915, PAGE 559 OF LORAIN COUNTY RECORDS;

THENCE SOUTH 0°20'40" WEST ALONG THE CENTERLINE OF SAID COWLEY ROAD AND THE EASTERLY LINE OF LOT 49 A DISTANCE OF 232.00 FEET TO A POINT;

THENCE NORTH 89°56'24" WEST, PASSING THROUGH AN IRON PIN SET AT 30.00 FEET, A DISTANCE OF 970.00 FEET TO AN IRON PIN SET;

THENCE NORTH 0°20'40" EAST A DISTANCE OF 232.00 FEET TO AN IRON PIN SET ON THE NORTH LINE OF LAND CONVEYED TO LORAIN COUNTY DEVELOPMENT, INC. AS AFORESAID;

THENCE SOUTH 89°56'24" EAST ALONG SAID LINE A DISTANCE OF 970.00 FEET, PASSING THROUGH AN IRON PIN SET AT 940.00 FEET, TO THE POINT OF BEGINNING AND CONTAINING ABOUT 5.1661 ACRES OF LAND ACCORDING TO A SURVEY MADE BY JOHN R. HOY AND ASSOCIATES, INC. IN MAY OF 1994, BE THE SAME MORE OR LESS AND SUBJECT TO ALL LEGAL HIGHWAYS.

MEDINA - ELYRIA ROAD STATE ROUTES 303 and 57

21019


APPROVED  
LORAIN CO.  
MAP DEPT

DATE 8-22-94

PAGE 16-D


BY CAROLYN  
FRANCIS

21019

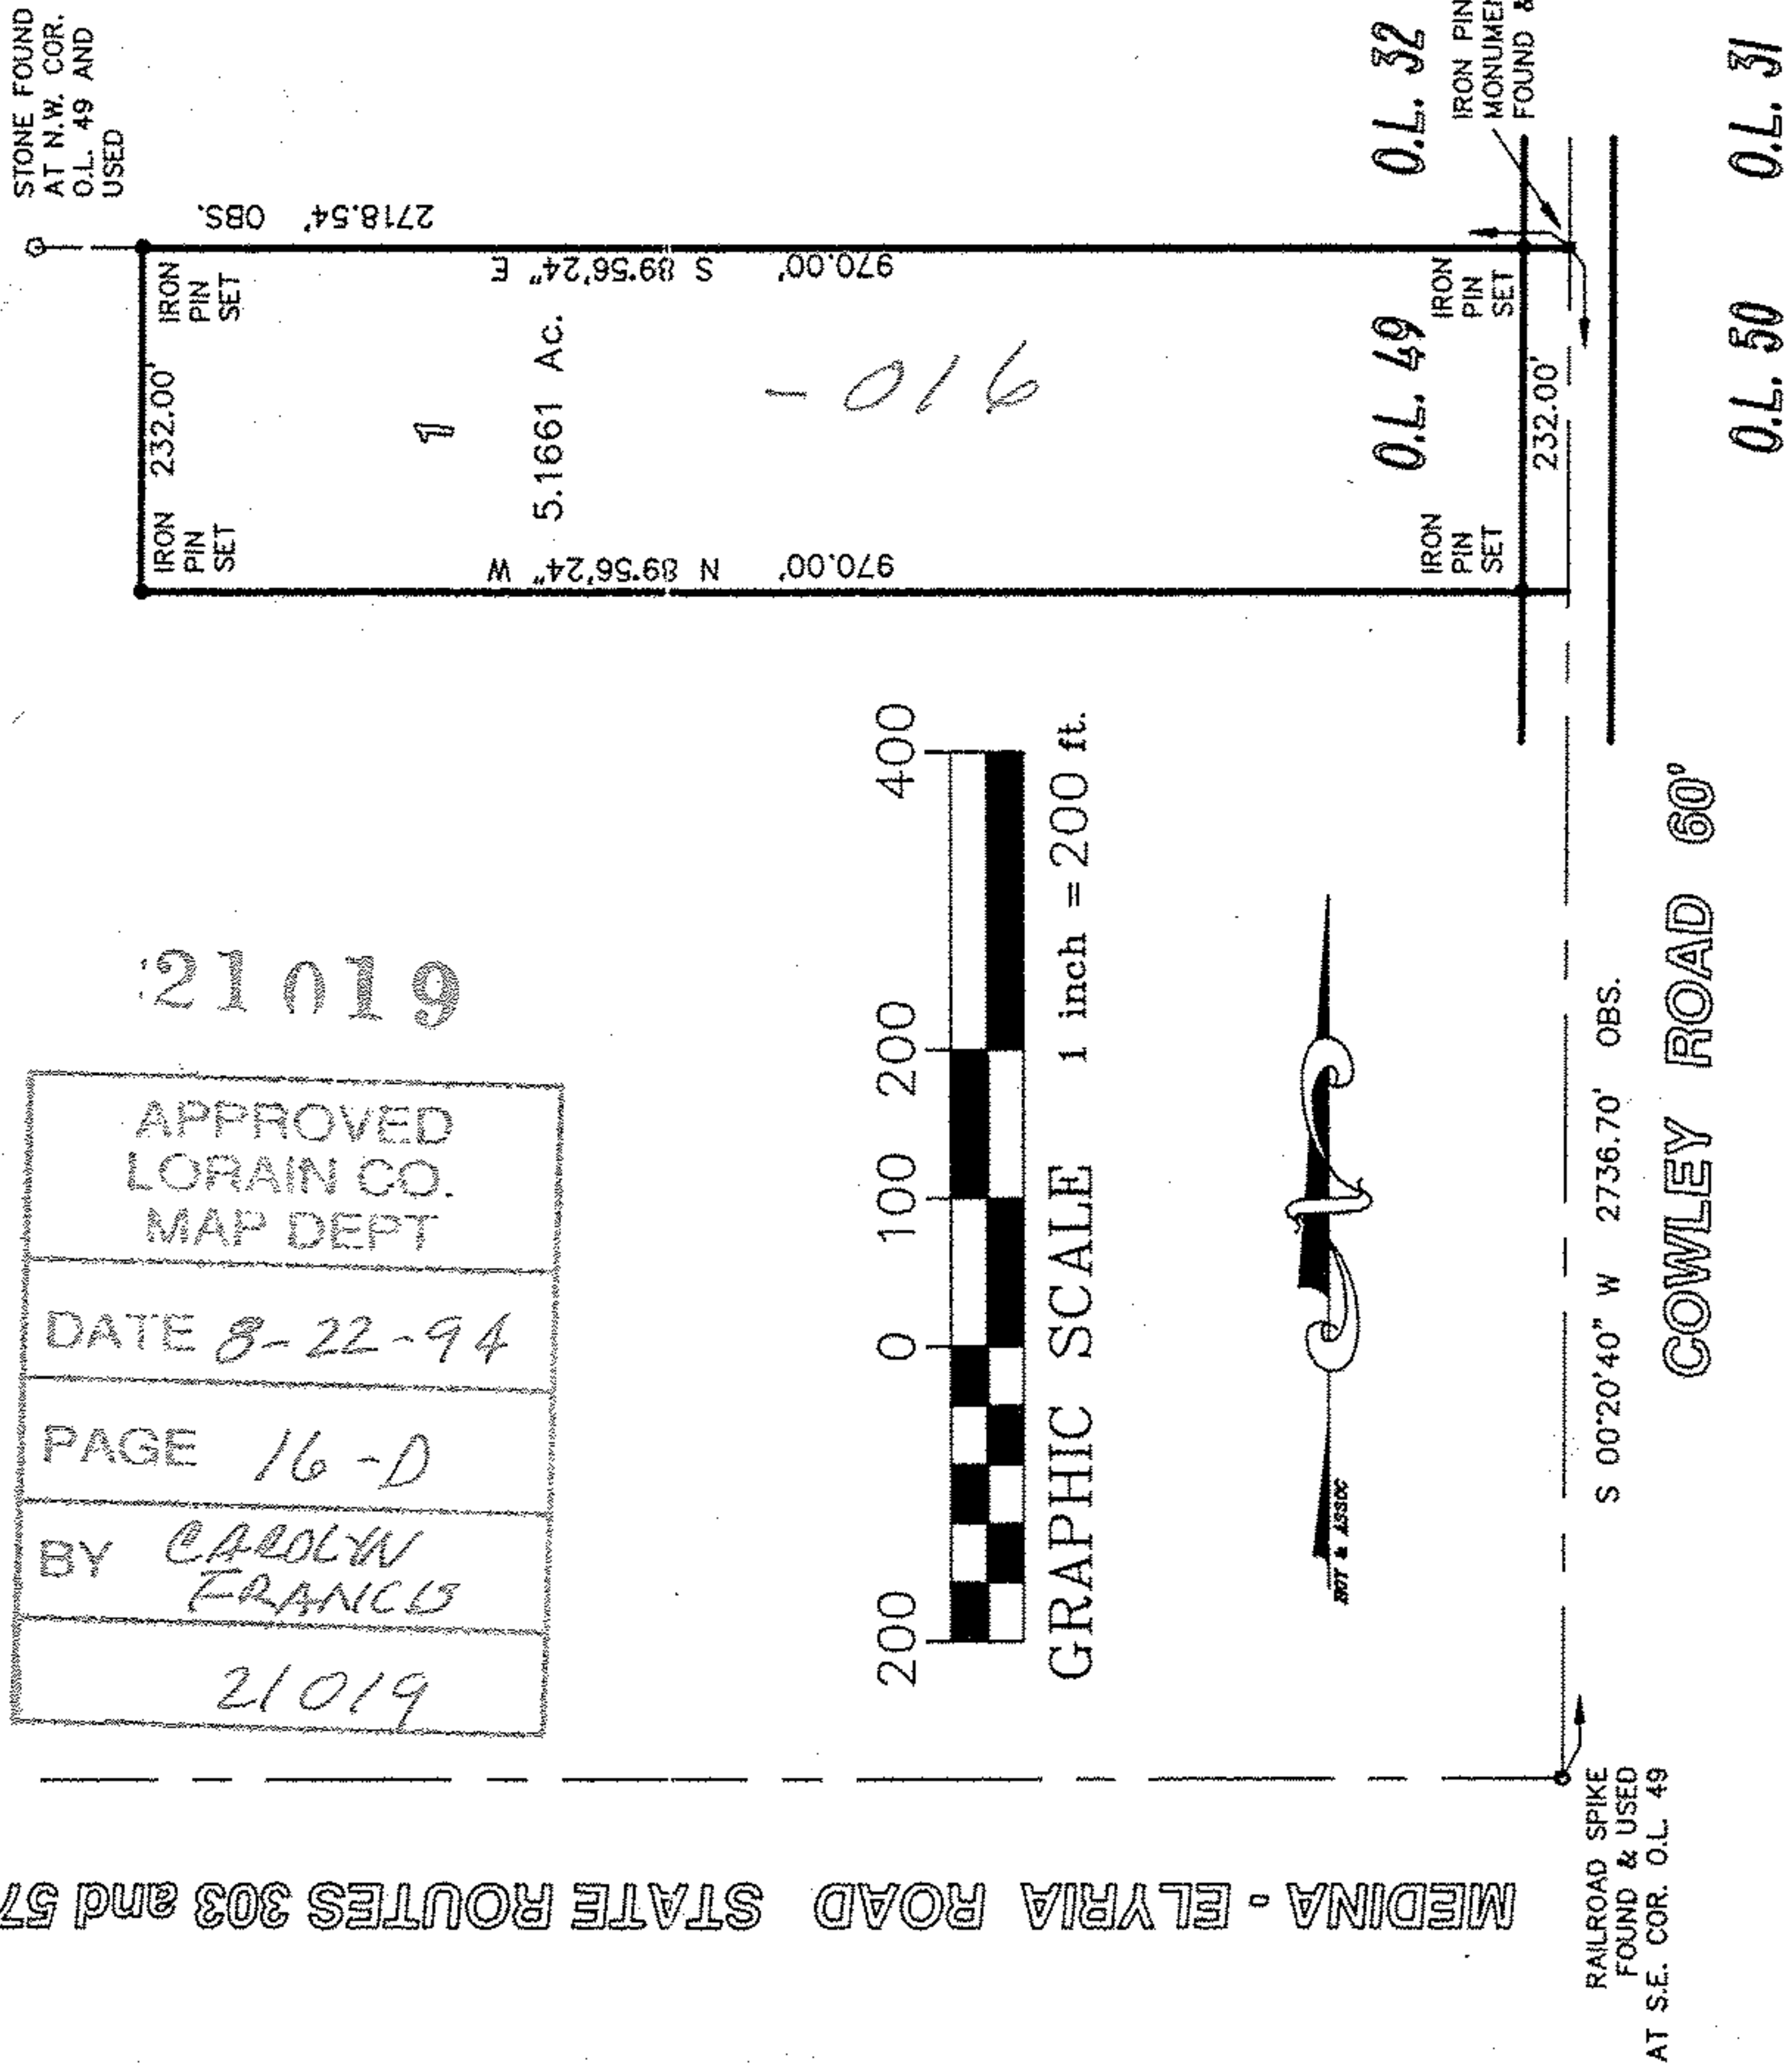

NOTES:

1. DEPTH DIMENSIONS SHOWN ARE TO THE CENTERLINE.
2. ACREAGE FIGURES INCLUDE RIGHT-OF-WAY AND EASEMENTS.
3. BEARINGS USED HEREON ARE TO AN ASSUMED MERIDIAN AND ARE USED TO REPRESENT ANGLES ONLY.
4. "IRON PINS SET" ARE 5/8" RE-BAR, 30" LONG WITH YELLOW PLASTIC IDENTIFICATION CAPS AS REQUIRED.

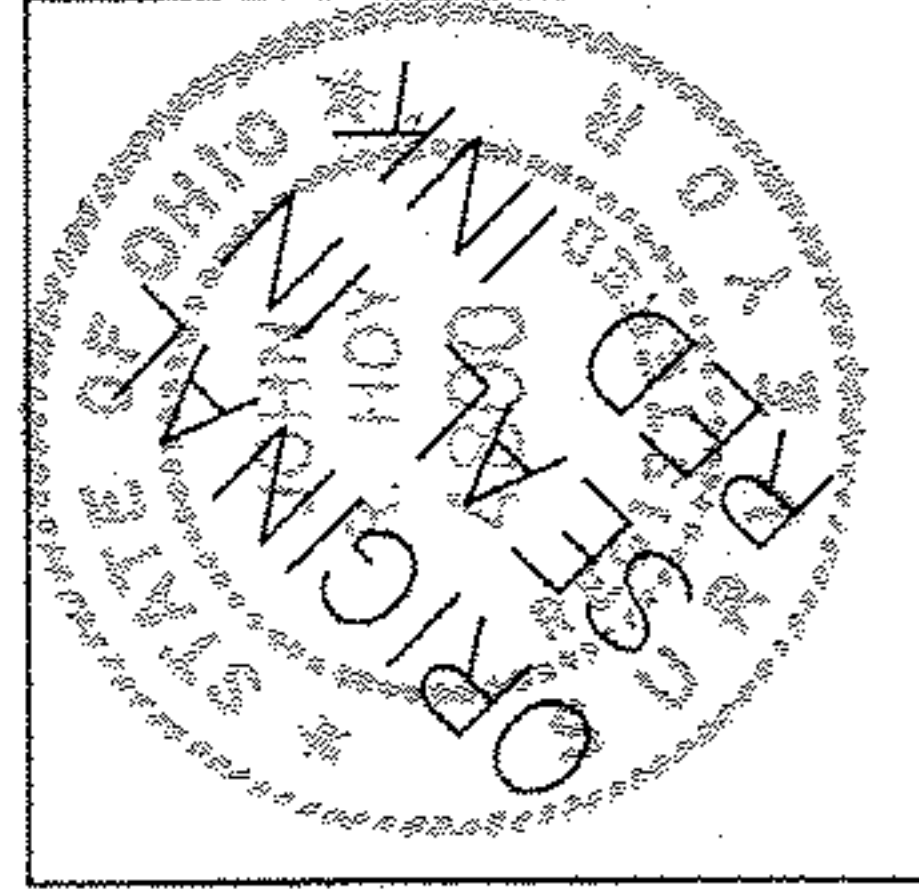

I HEREBY CERTIFY THAT I HAVE SURVEYED THIS PROPERTY ON THE GROUND AND THAT THIS PLAT DEPICTS GRAPHICALLY, IN SO FAR AS IS POSSIBLE, THE RESULTS OF SAID SURVEY, MADE IN ACCORDANCE WITH PROVISIONS OF ARTICLE 4733-37 OF THE OHIO ADMINISTRATIVE CODE.

JOHN R. HOY & ASSOCIATES, INC.  
PROFESSIONAL LAND SURVEYORS  
4562 UP WEST 130 STREET  
CLEVELAND, OH 44135-3538  
(216)476-3600 FAX: 476-1665  
FILE NO. 2106

JOHN R. HOY and ASSOCIATES, INC.  
BY: *John R. Hoy* JOHN R. HOY, PRESIDENT  
REGISTERED PROFESSIONAL  
OHIO SURVEYOR NO. 4800

SW 48305 16-D-049.000.016