DRAWN	DATE	PREPARED BY:	PREPARED FOR:	REVISED:
T.SNEZEK	08-01-13	SNEZEK & ASSOCIATES, L.L.C.	CYRUS H. & MARY A. BLISS AND GEORGE O. & LIANE C. BLISS, CO-TRUSTEES	12-11-13 12-16-13 1-18-14
		PROFESSIONAL SURVEYORS CLEVELAND, OHIO 44111 DADSURV@HOTMAIL.COM	3496 COLLETTA LANE (216) 671-4902 CELL (216)-385-6791	ON DETROIT ROAD AVON, OHIO 44011

BOUNDARY AND LOT SPLIT SURVEY PLAT

SHEET 1OF1

SCALE: 1" = 60'
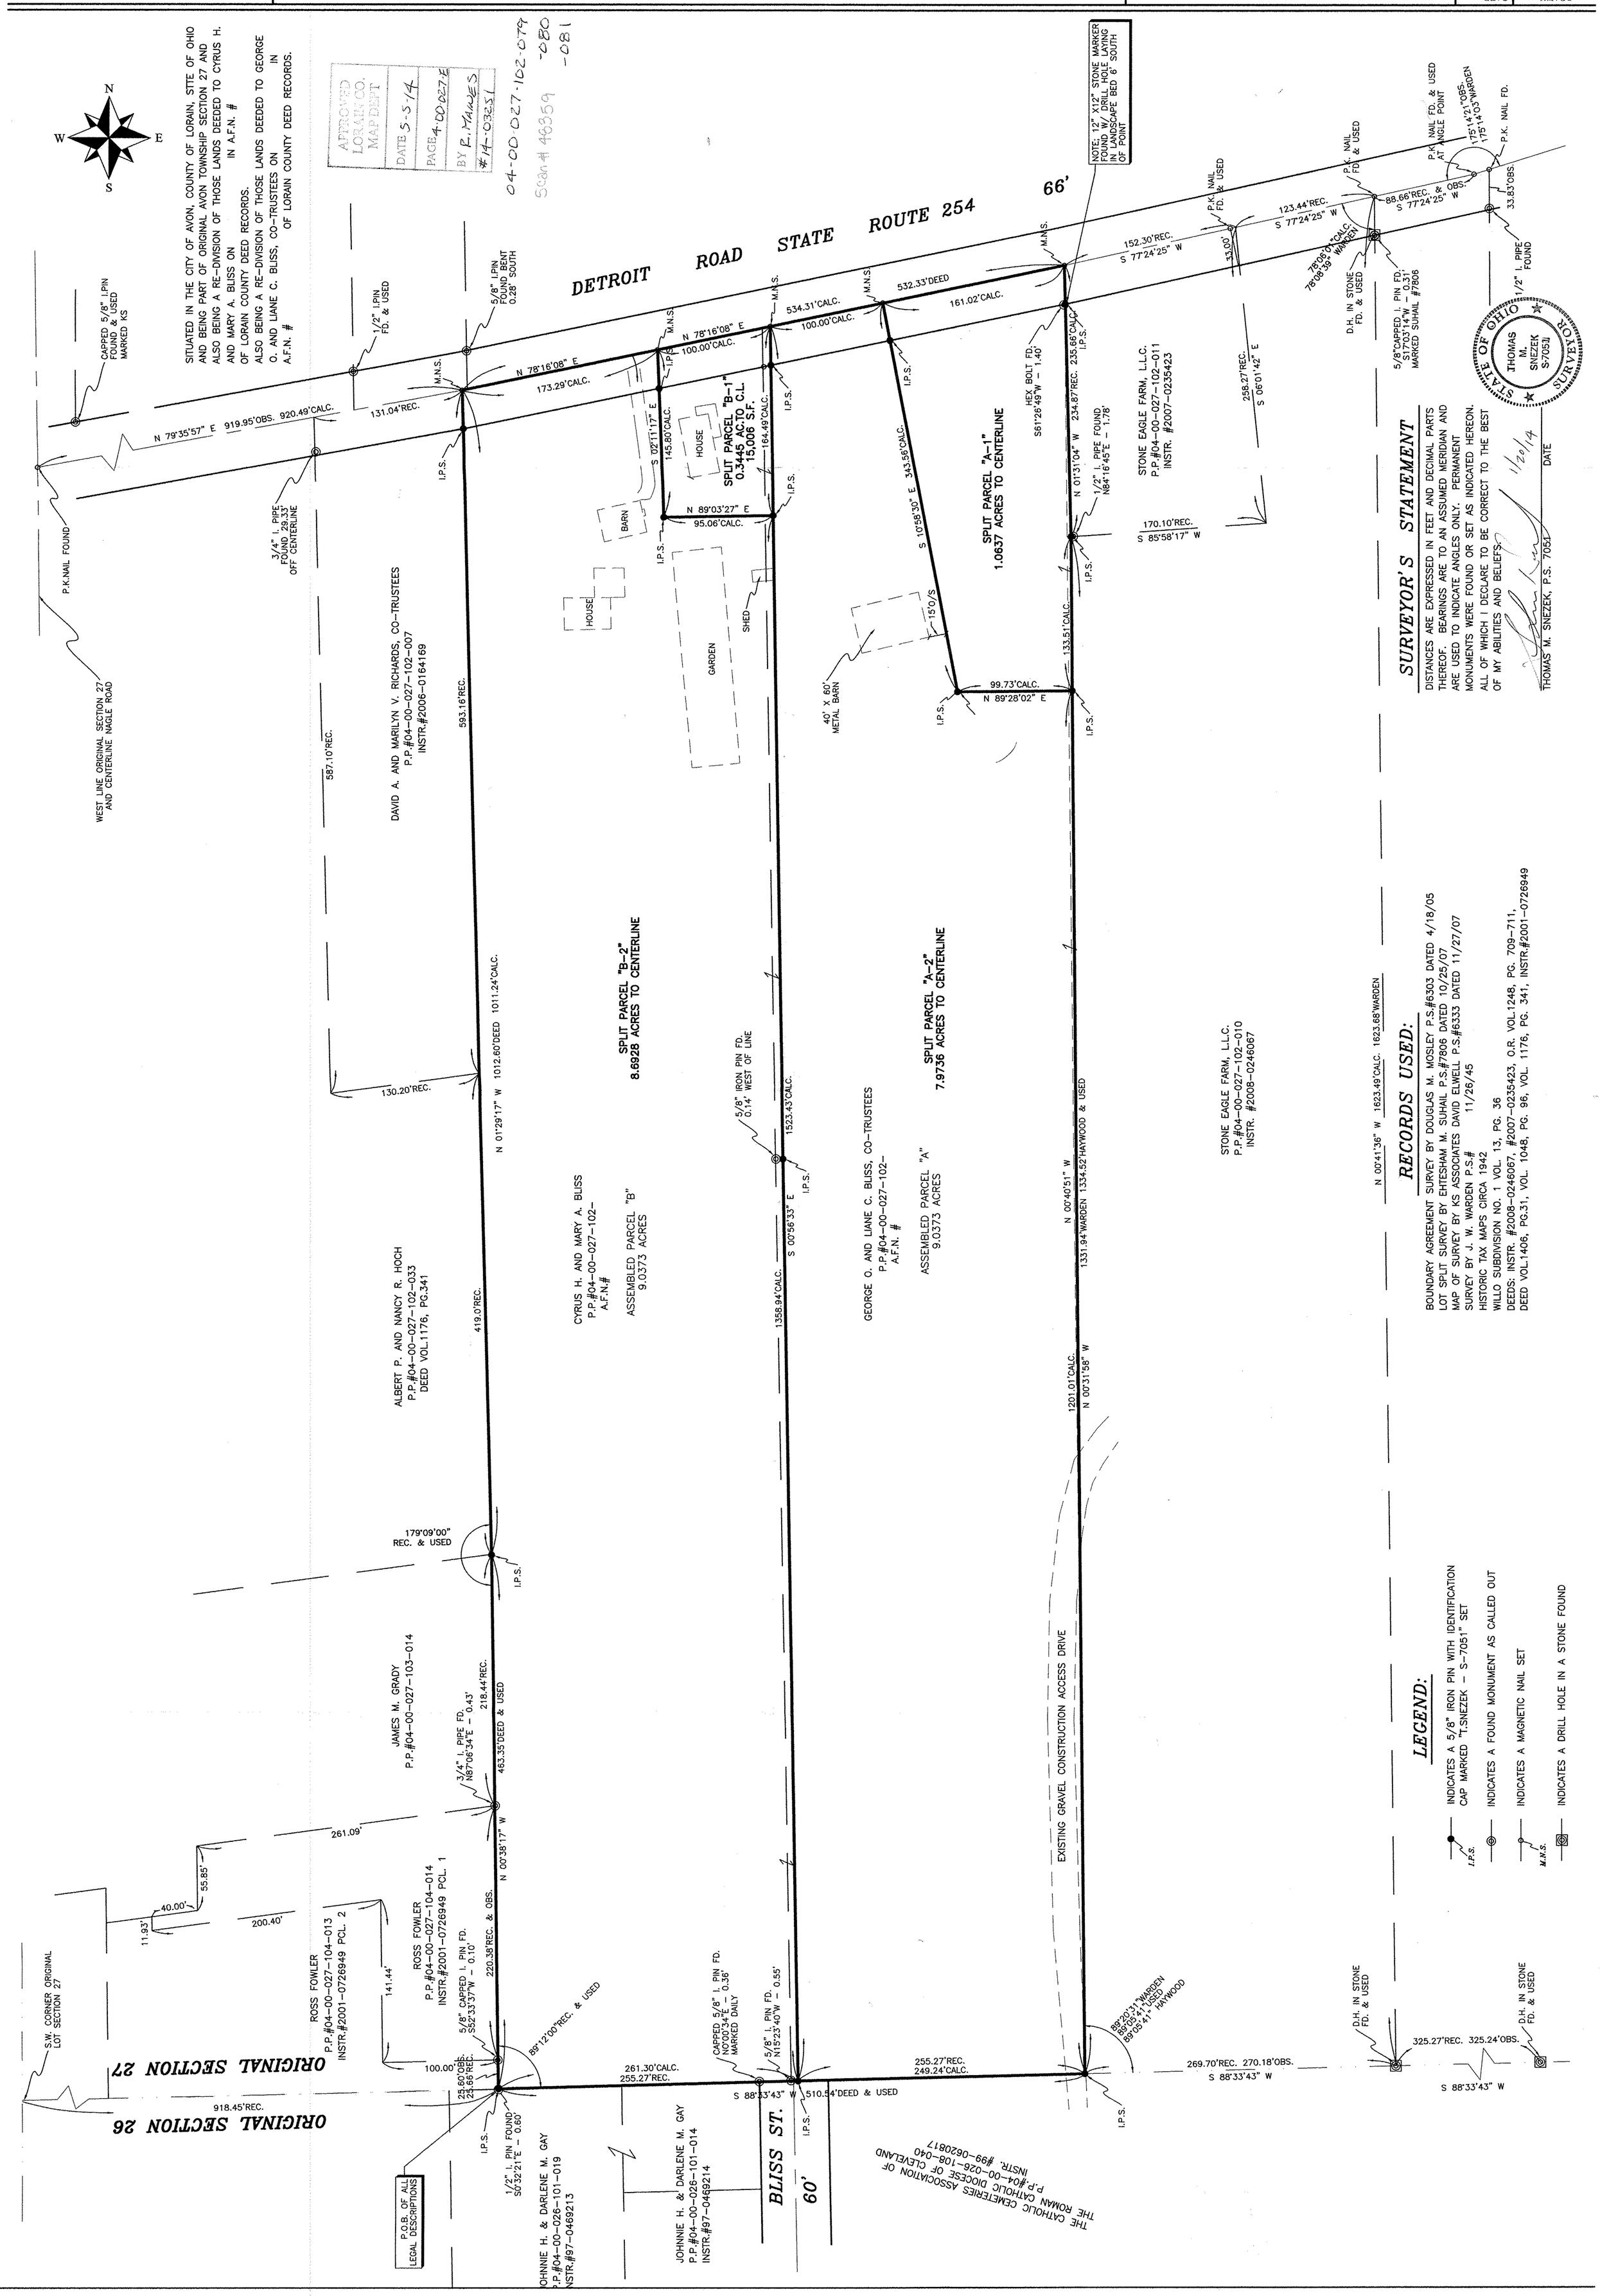
PROJECT NO. BLISS-LOT-SPLIT-#1310