


Scan # 48367 16-F No. 00084.000.017

BREWSTER
COURT 50'

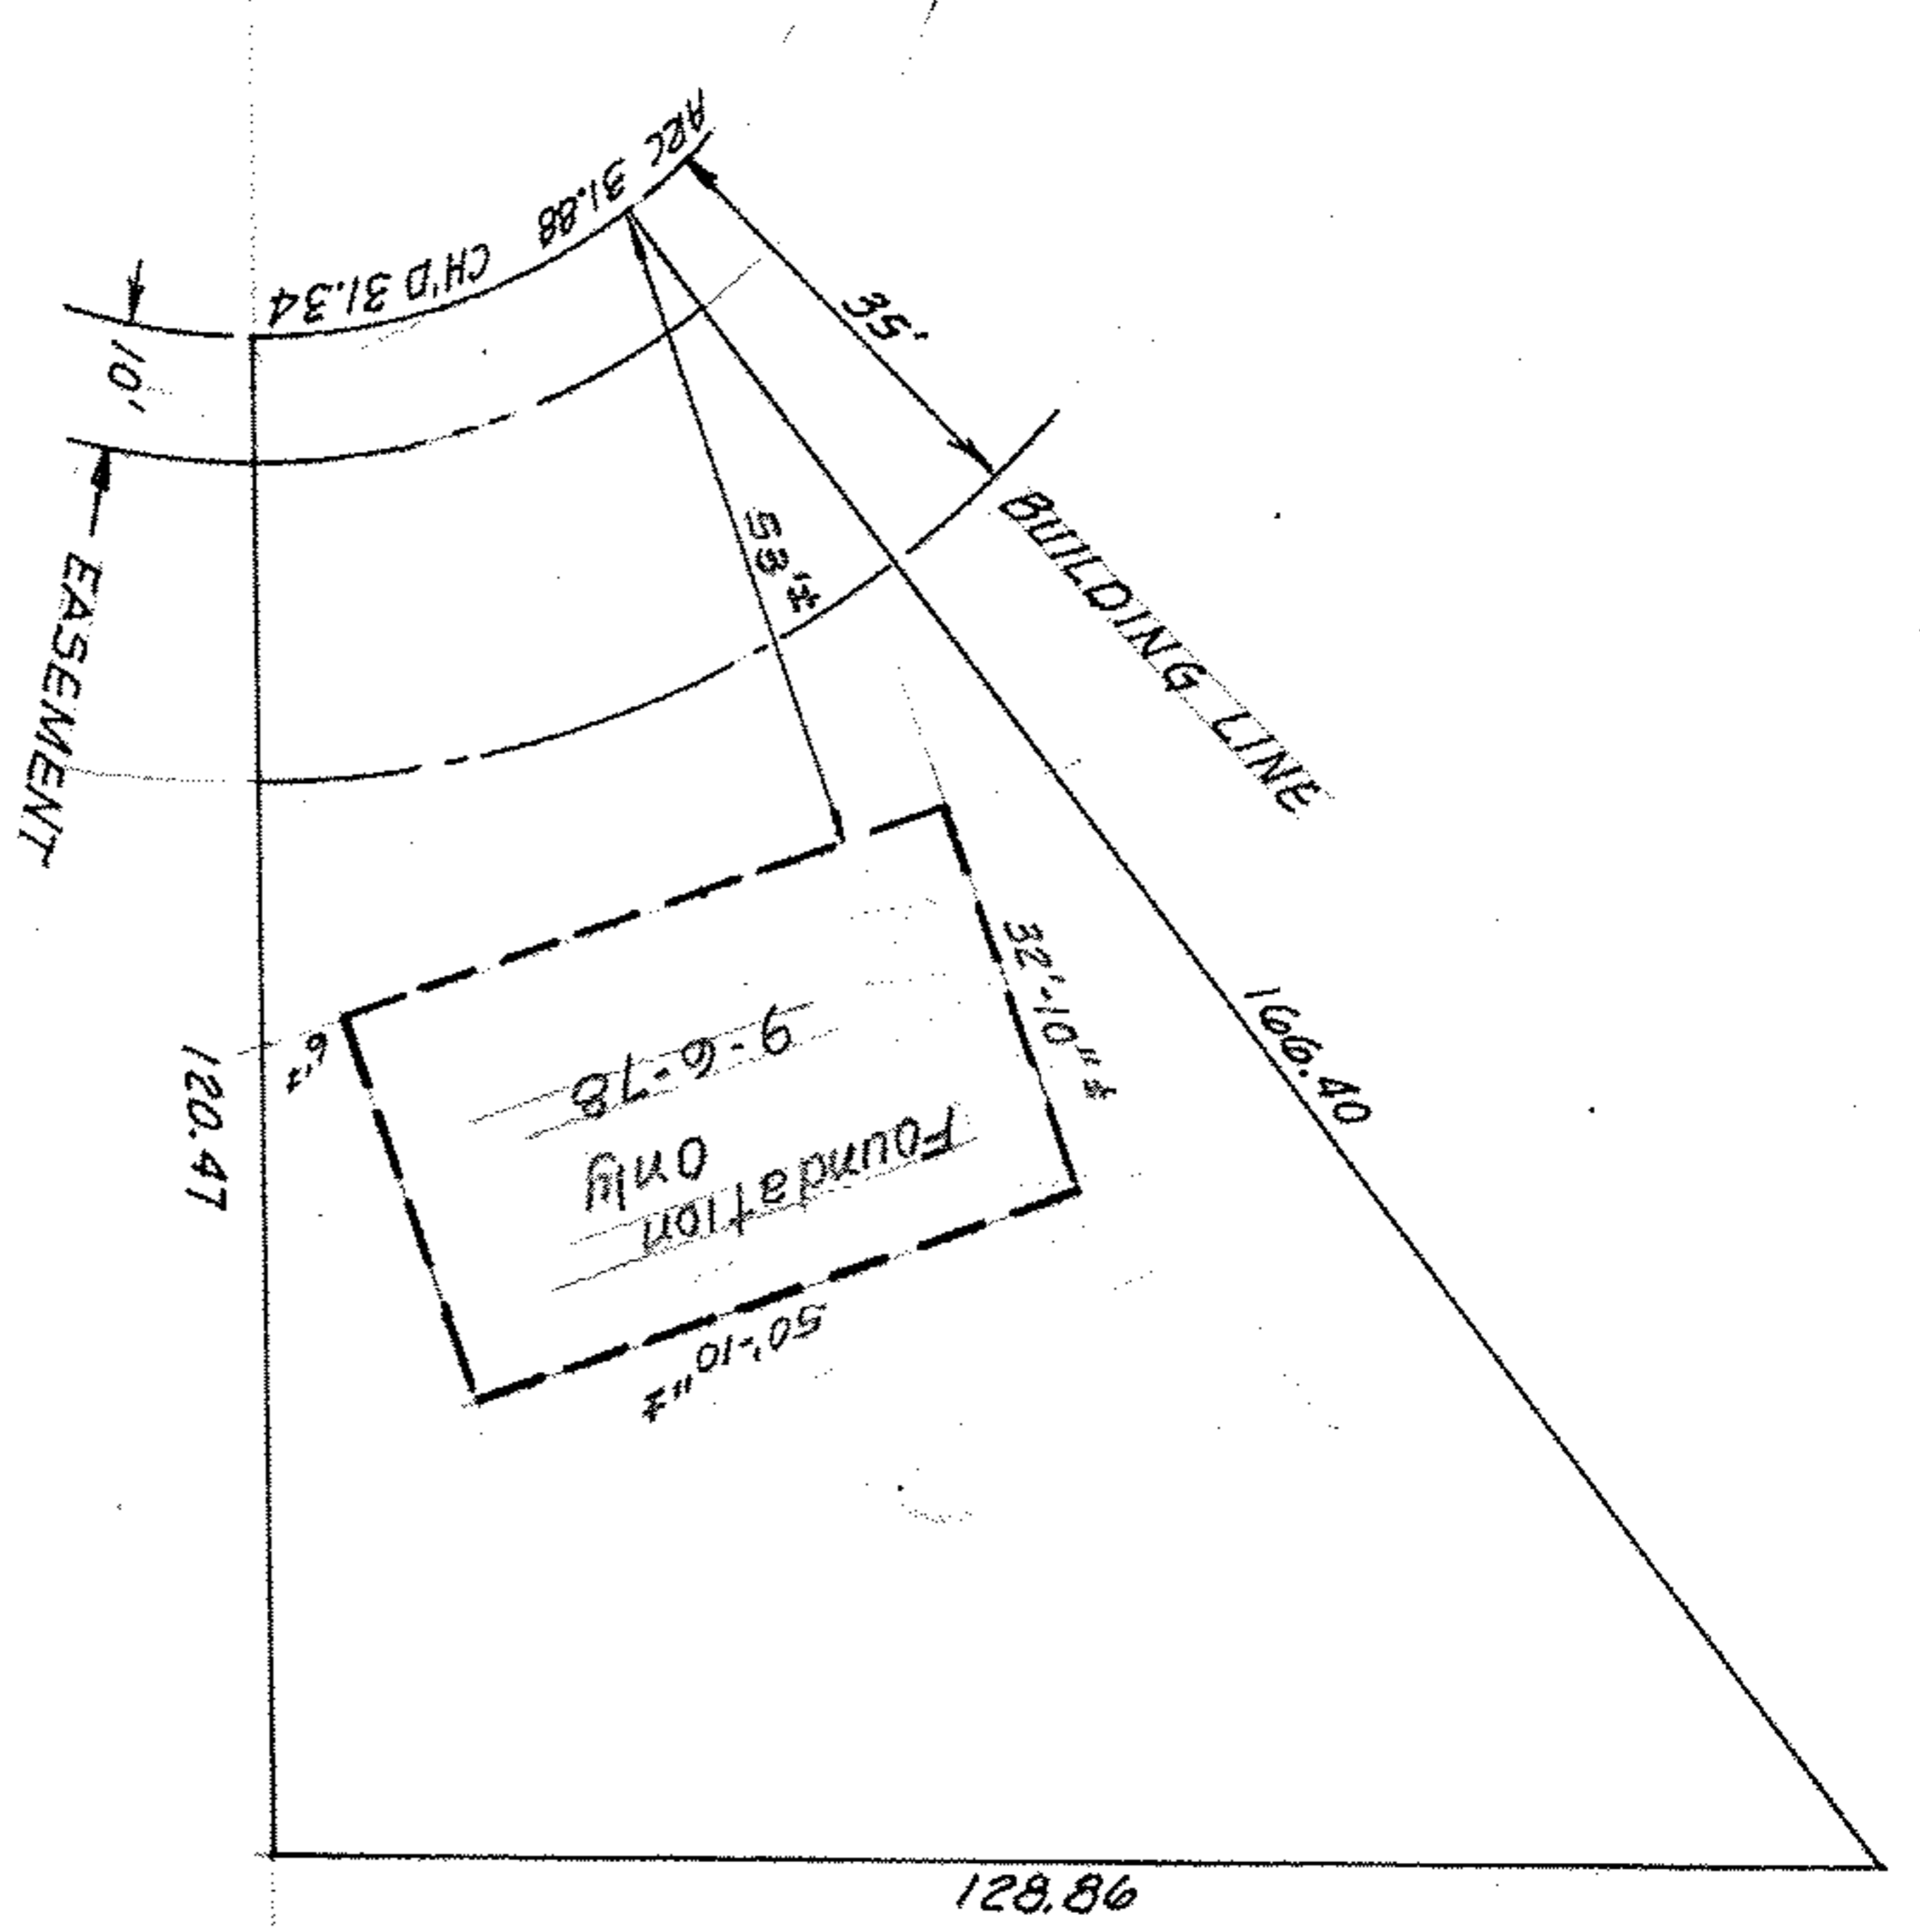

1"=30'



SUBLOT #84 of NEW ENGLAND ESTATES NO.3

PLAT VOL. 30 PAGE 65
PART of ORIG. EATON TWP. LOT 99
NOW in VILLAGE of GRAFTON, OHIO

THIS IS NOT A PLAT OF SURVEY:
FOR MORTGAGE LOAN PURPOSES ONLY

McGLINCHY & ASSOCIATES

AUG. 1, 1978 #783862

2nd P.C. SEPT. 6, 1978 MINN T E 20, 295