LAUNDON • SIMON • CAHL & ASSOC. INC.
CONSULTING ENGINEERS & SURVEYORS
504 MIDDLE AVENUE ELYRIA, OHIO 44035

SURVEY FOR
BEN & DEBORAH KIMMICK
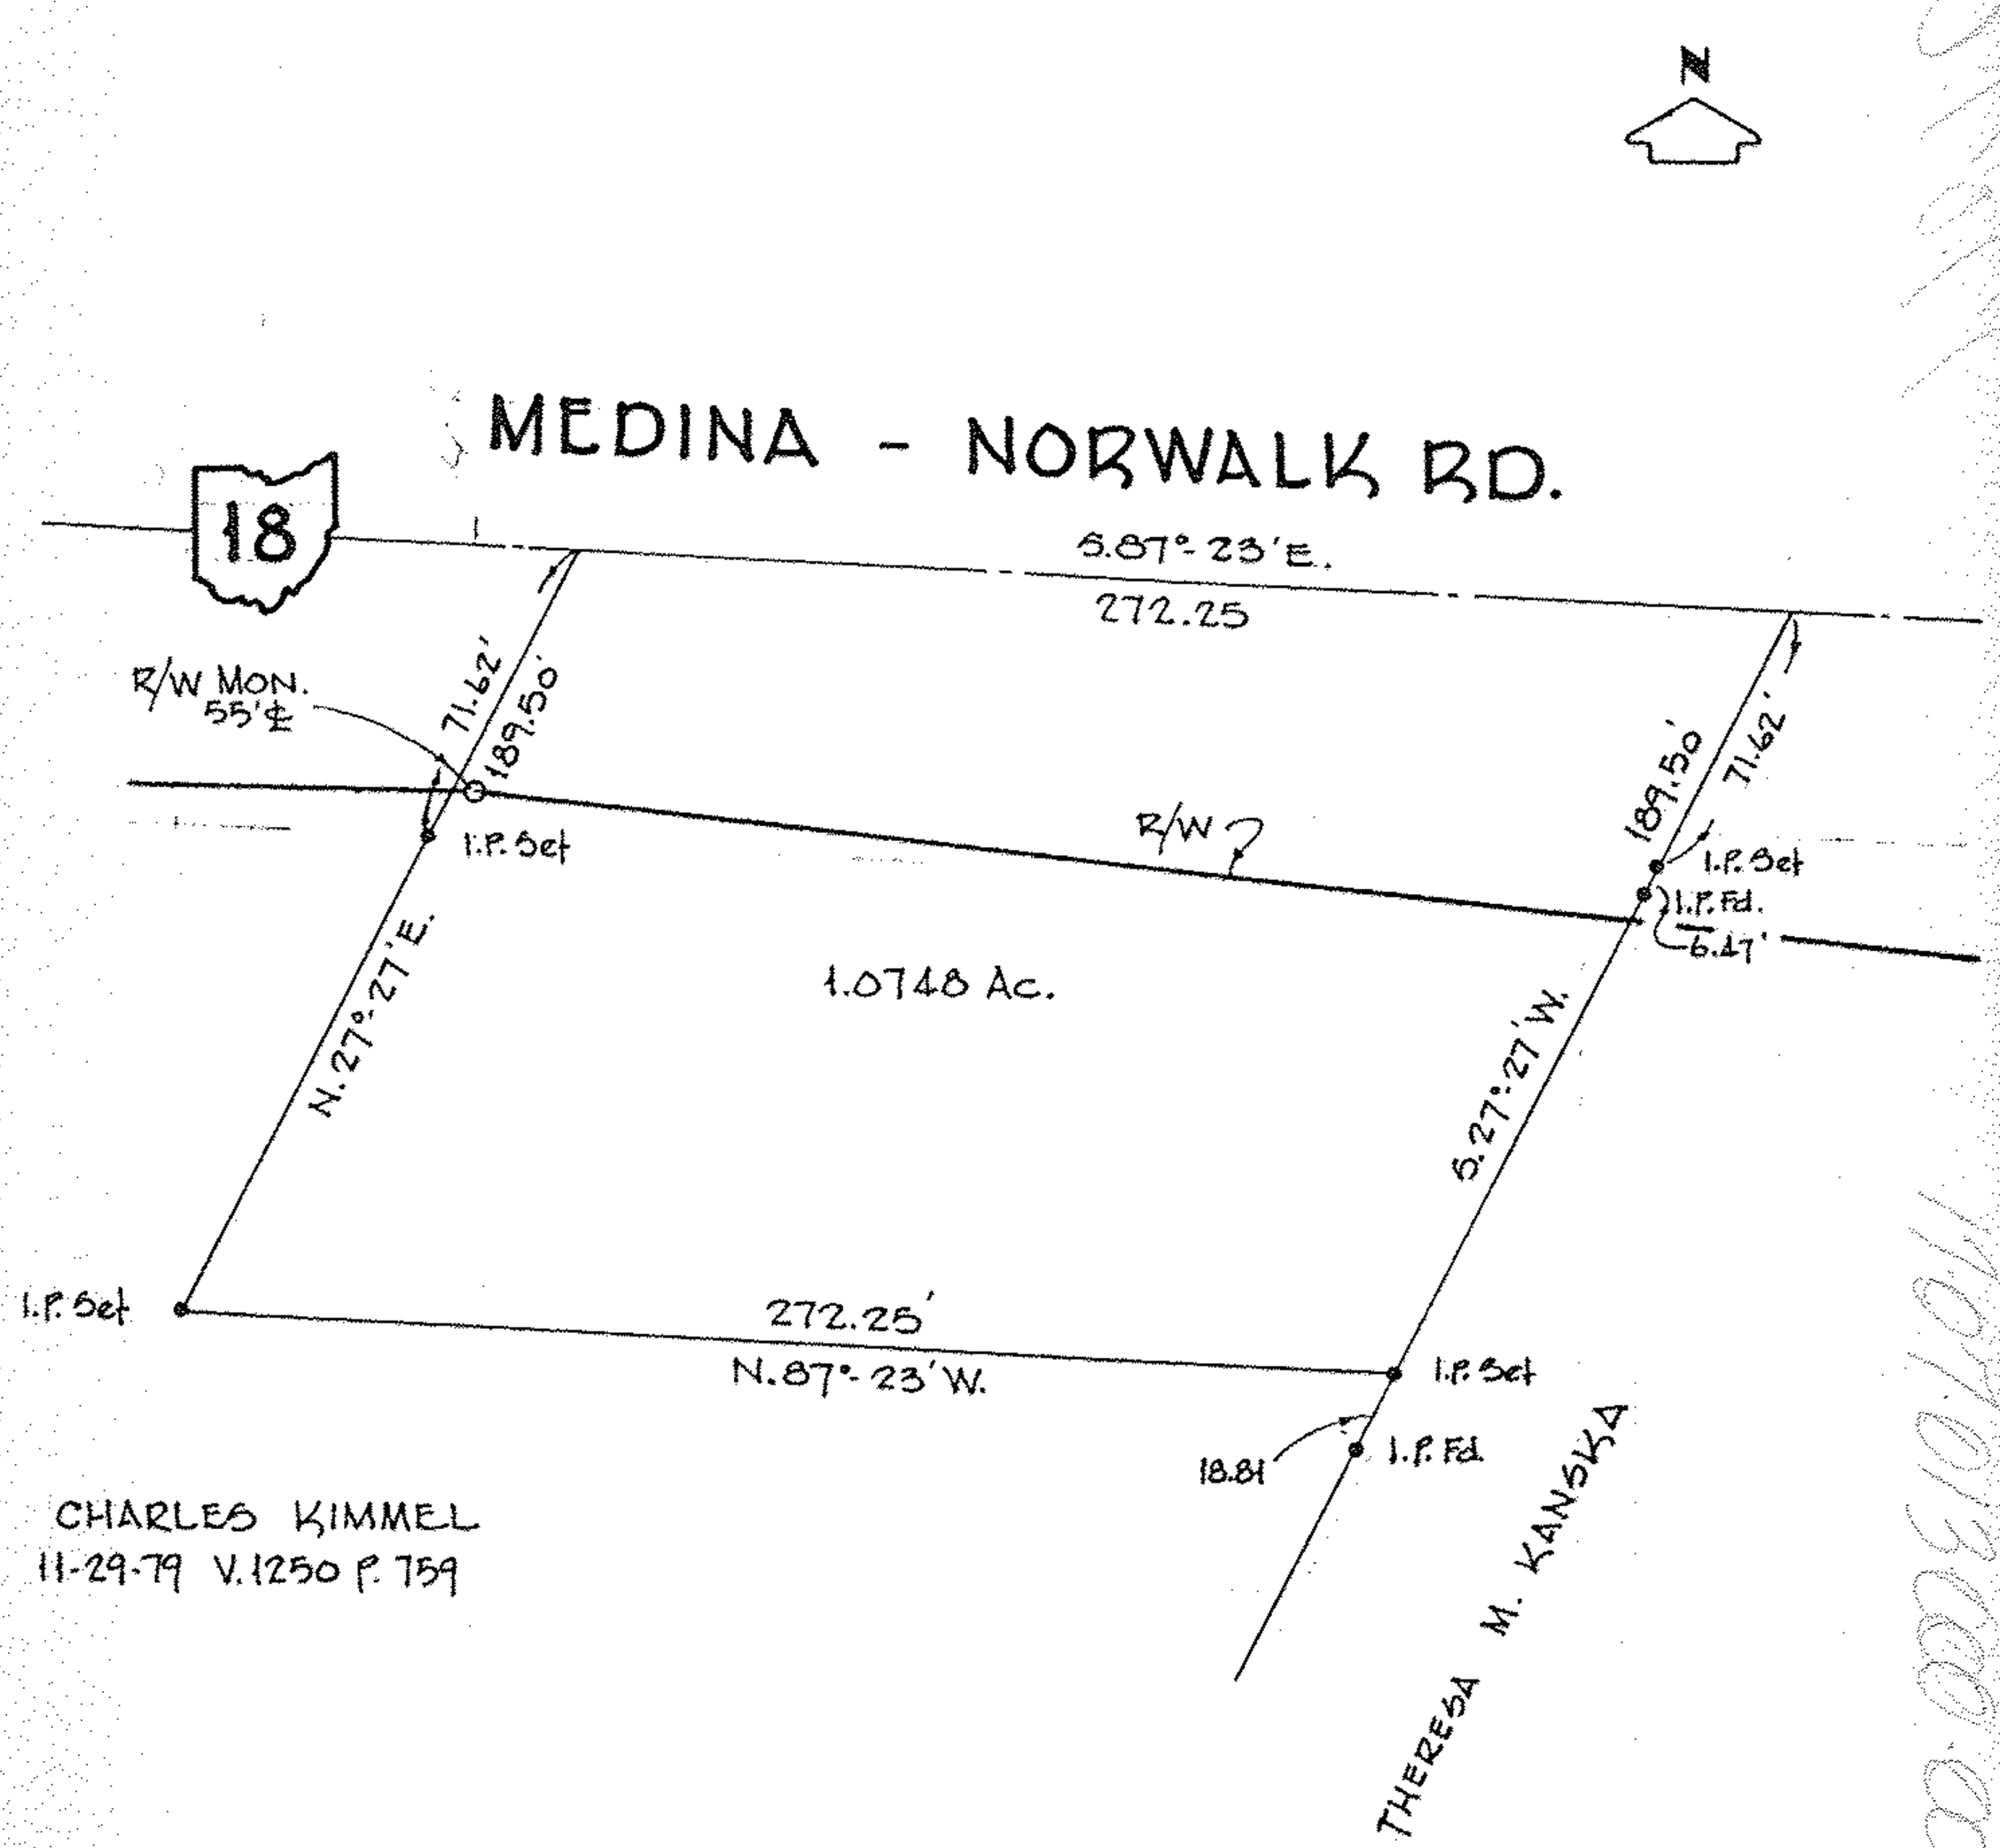
Orig. Lot 13	City of	Date 3/6/84 Scale 1"=60'
Orig. Sec	Village of	Dwn. by R.G.G. Chkd. by J.C.
Tract 7	County of LORAIN	Job No. 84-1263 F.B.
Township of BRIGHTON	State of OHIO	Printed