
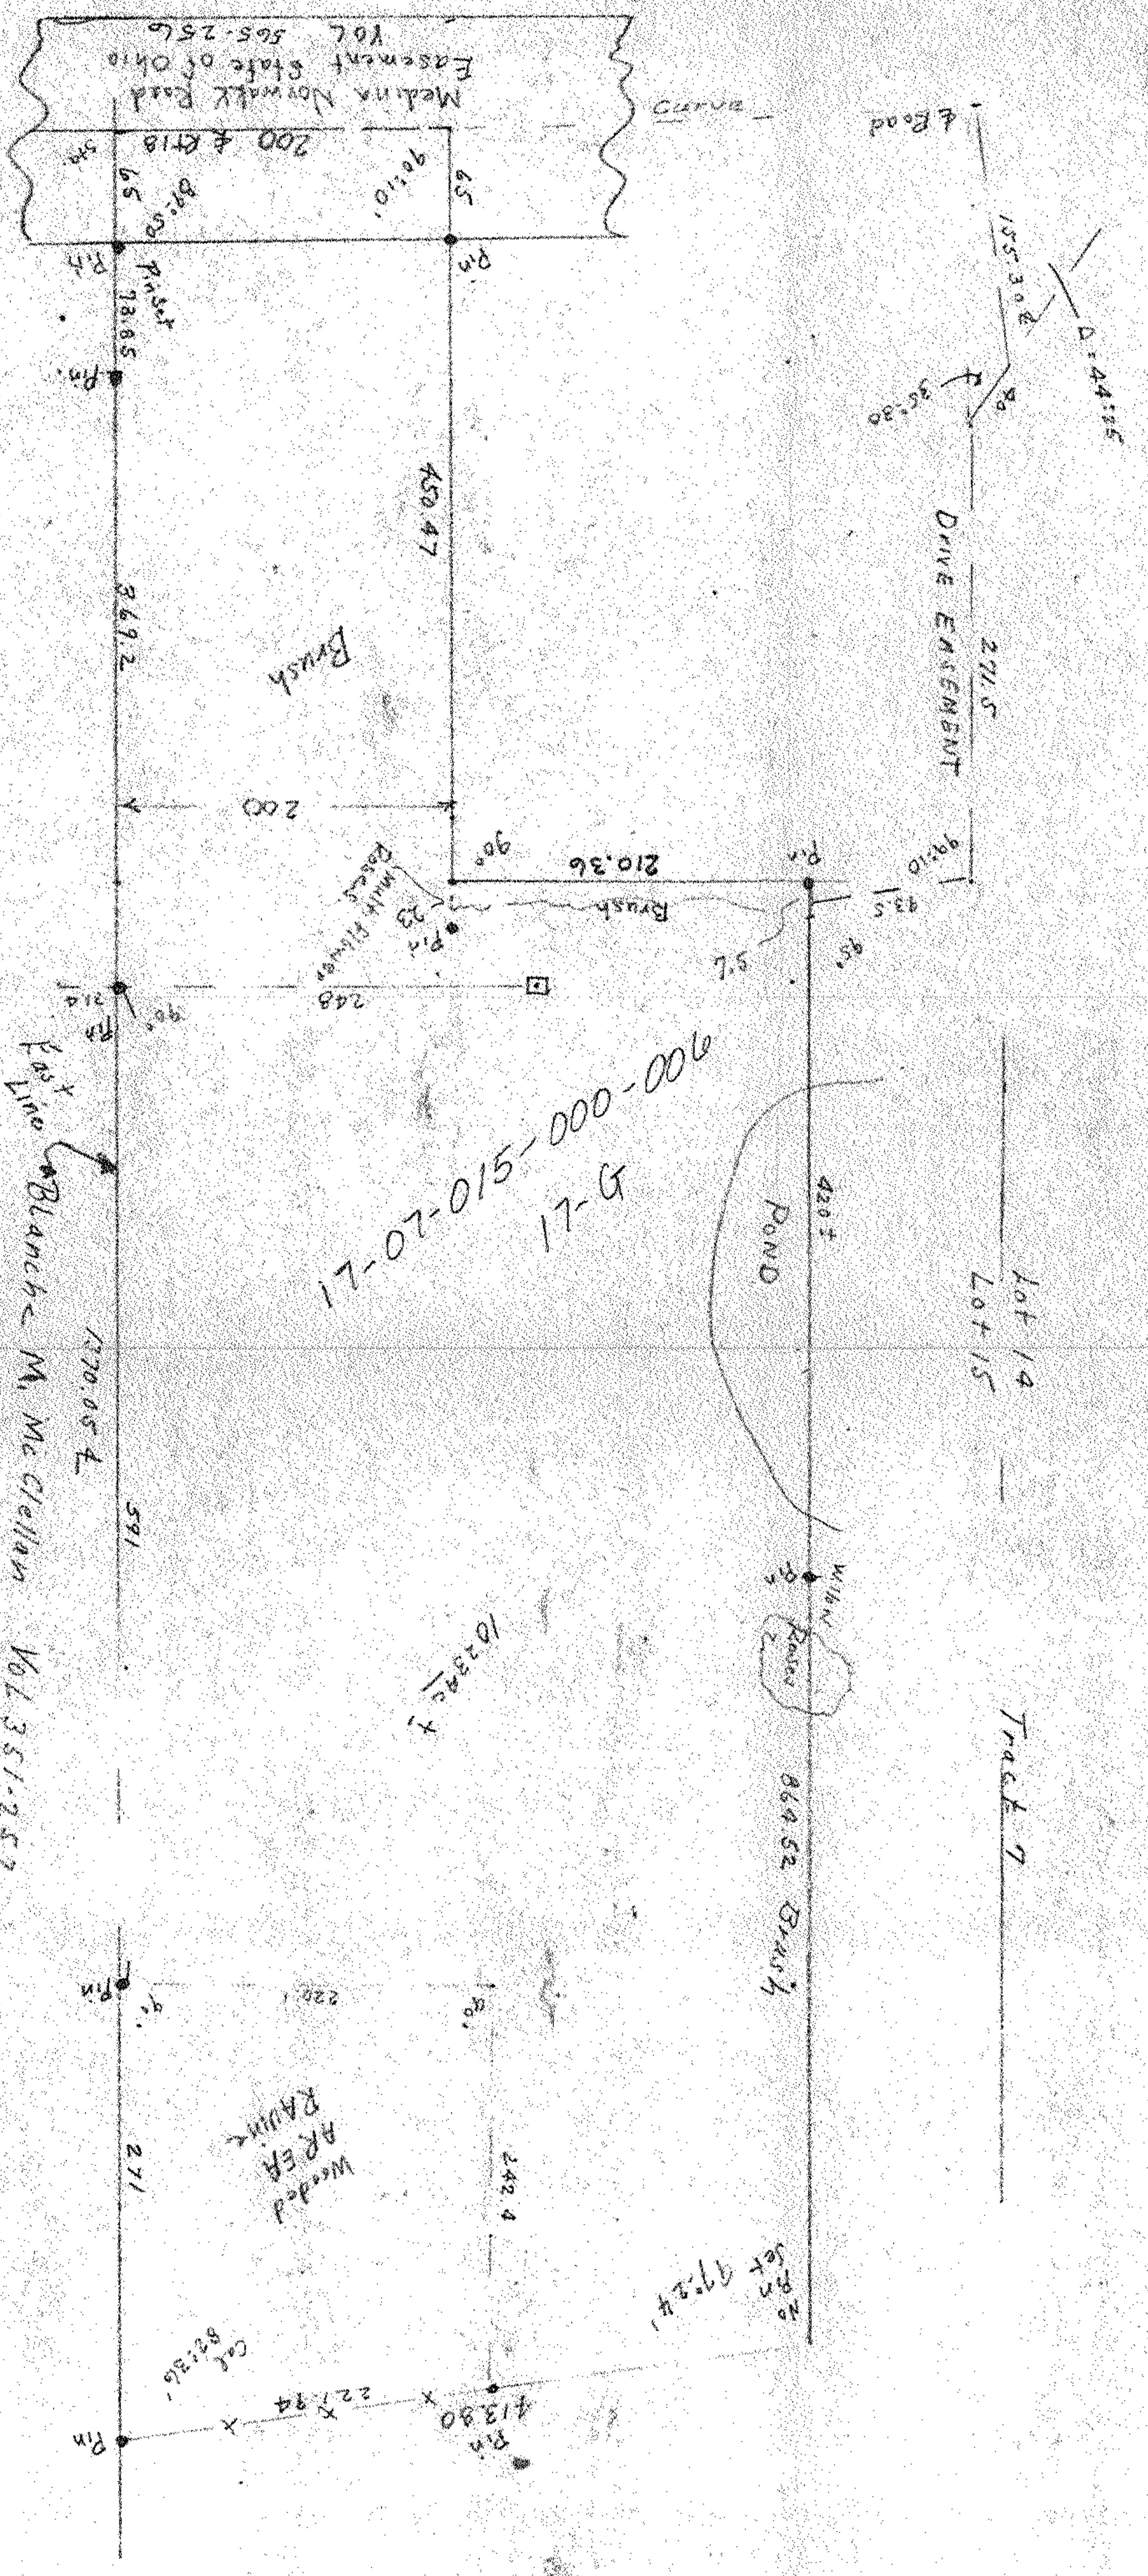


17-07-015
17-G

#10652
8-2-2-2
17-G

Map of Part of Tract 7 Lot 15 Brighton Twp Brown Co Ohio

Scale 1"=100' June 9-1997
By A F Koepf, Registered Surveyor No 4306

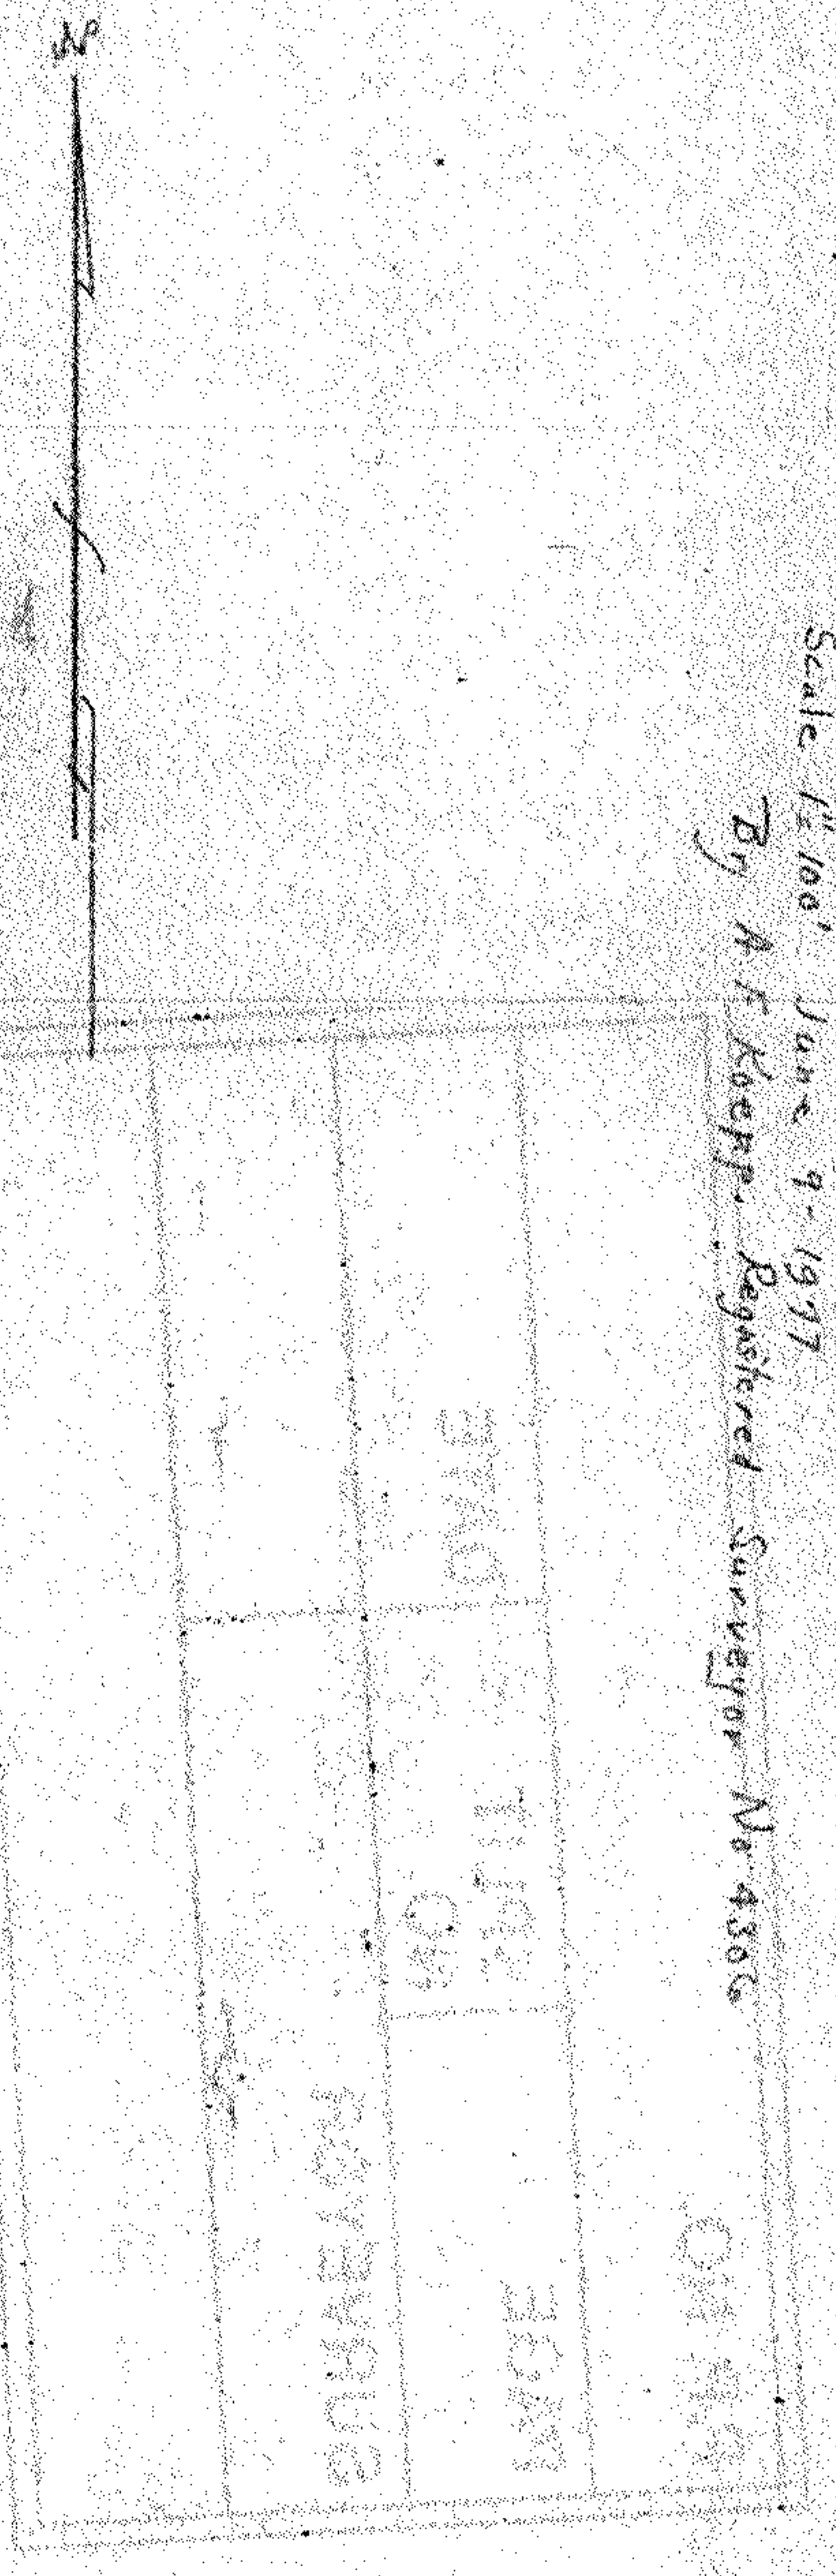

17-07-015-000-006
17-G

1770.054
591
Blanch M. McClellan Vol 351-252

17-07-015



17-G