


18-00-022-101-041

18-00-022-A scan#48386

HORTON AVE

5707

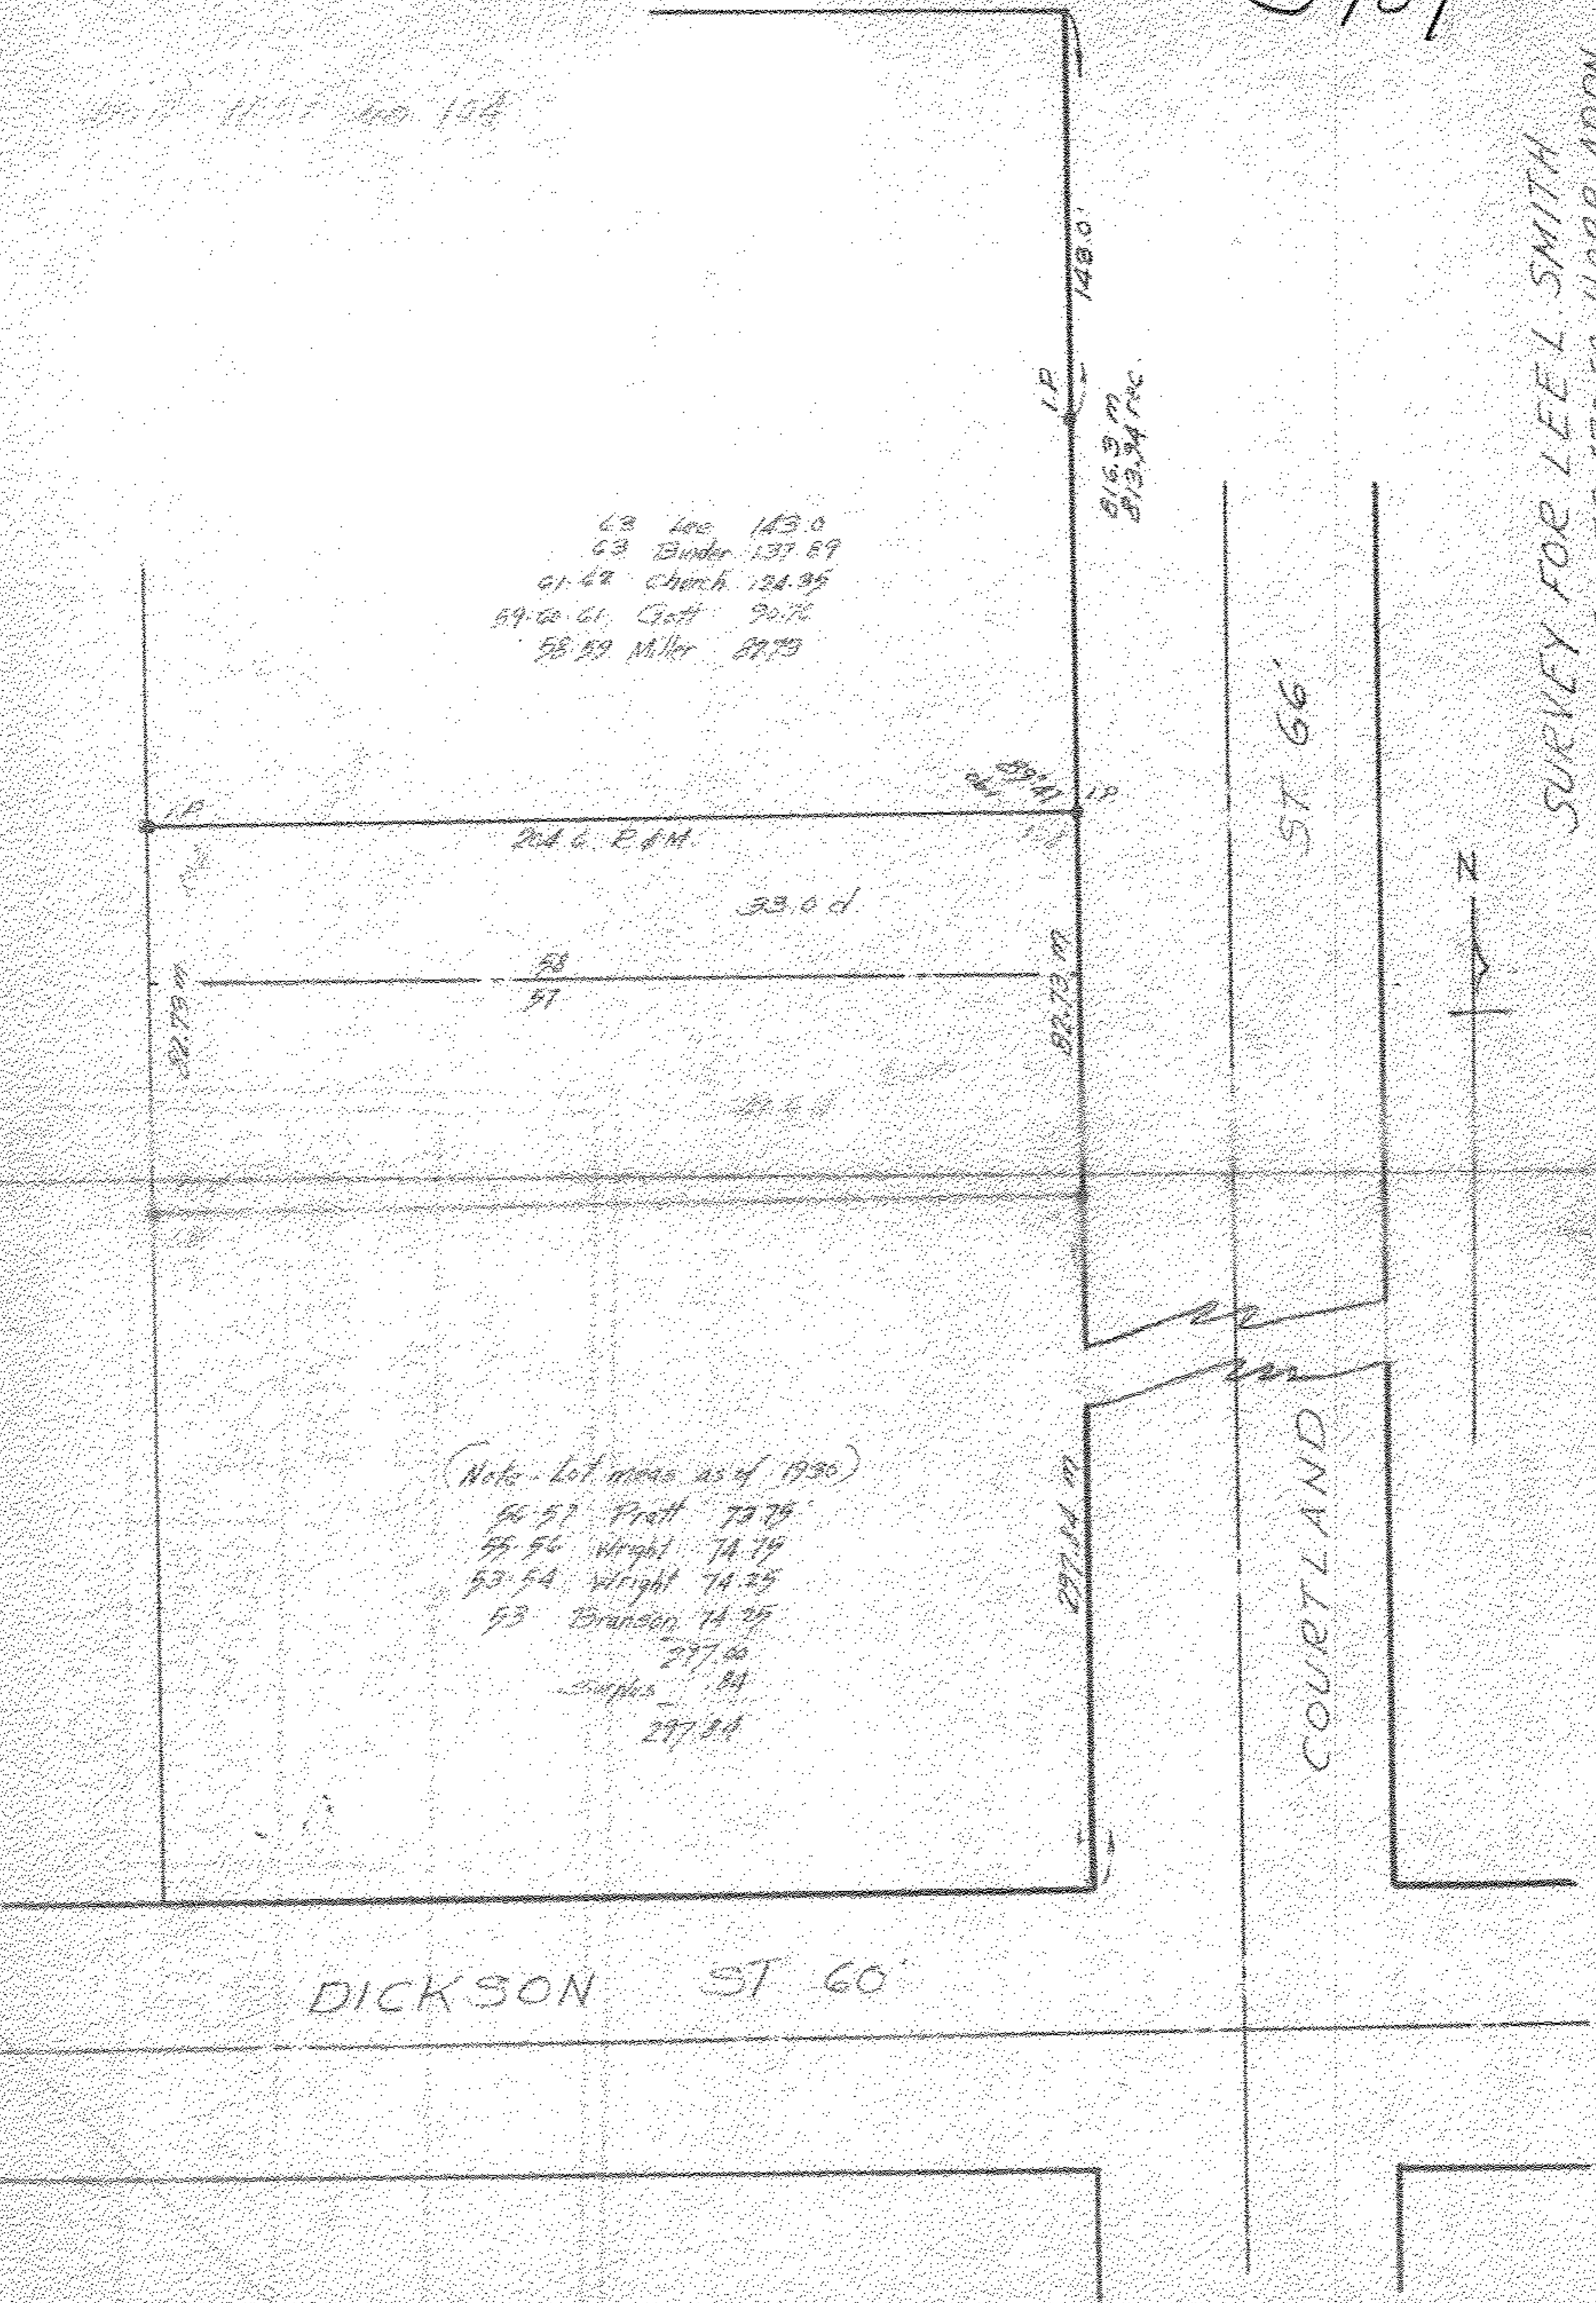

63 Lee 143.0  
 63 Buder 137.59  
 61-62 Church 124.95  
 59-60 61 Gatt 90.75  
 58-59 Miller 87.75

(Note - Lot areas as of 1930)  
 56-57 Pratt 73.75  
 55-56 Wright 74.79  
 53-54 Wright 74.25  
 53 Branson 74.25  
 297.00  
 surplus .84  
 297.84

SURVEY FOR LEE L SMITH  
 PARTS OF LOTS 578-58 MORE ADDN  
 WELLINGTON VILL LORAIN CO OHIO  
 SCALE 1"=50' OCT 16/1952

ST 66'

COURTLAND

DICKSON ST 60'

148.0'

I.P.  
516.3 m  
513.34 REC

I.P.

82.73 m

297.14 m

