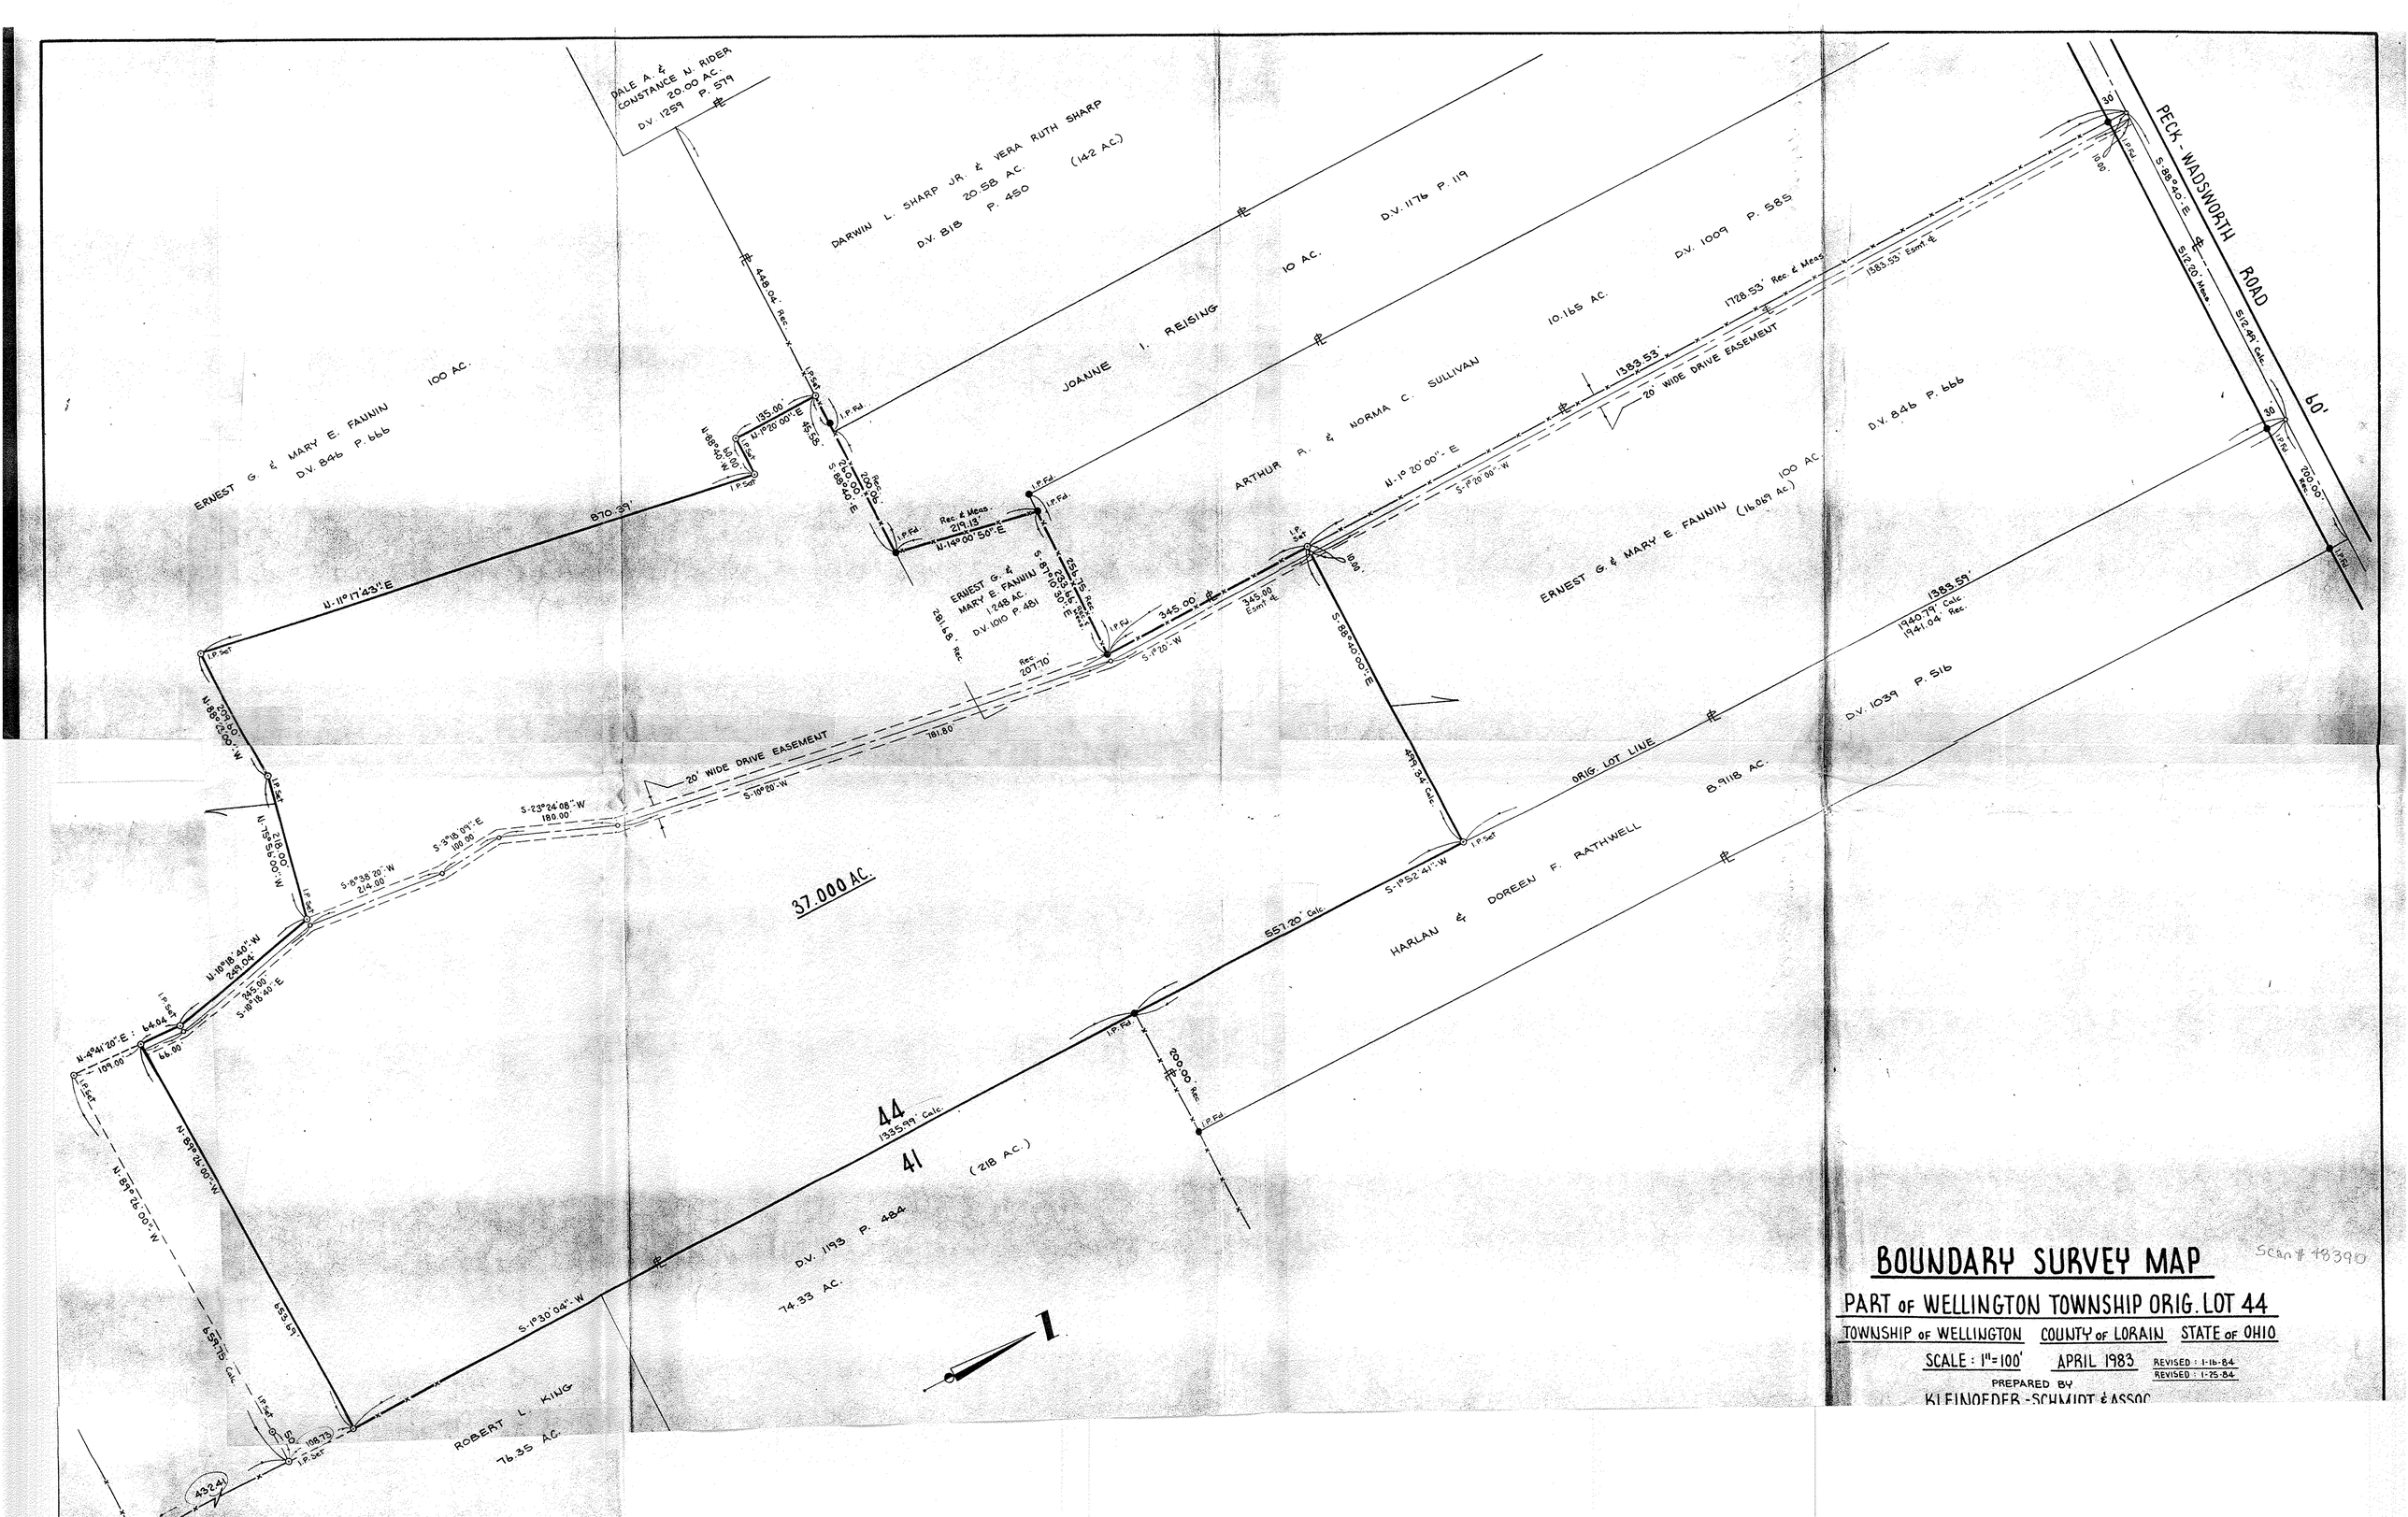

BOUNDARY SURVEY MAP

Scan # 48390

PART OF WELLINGTON TOWNSHIP ORIG. LOT 44

TOWNSHIP OF WELLINGTON COUNTY OF LORAIN STATE OF OHIO

SCALE: 1" = 100' APRIL 1983 REVISED: 1-16-84 REVISED: 1-25-84

PREPARED BY

KLEINOEDER - SCHMIDT & ASSOC.