SURVEY MAP

PART OF ORIGINAL WELLINGTON TWP.
LOT No. 28
VILLAGE OF WELLINGTON
COUNTY OF LORAIN STATE OF OHIO

PREPARED BY:
K S ASSOCIATES INC.
ENGINEERS SURVEYORS
01-24-96

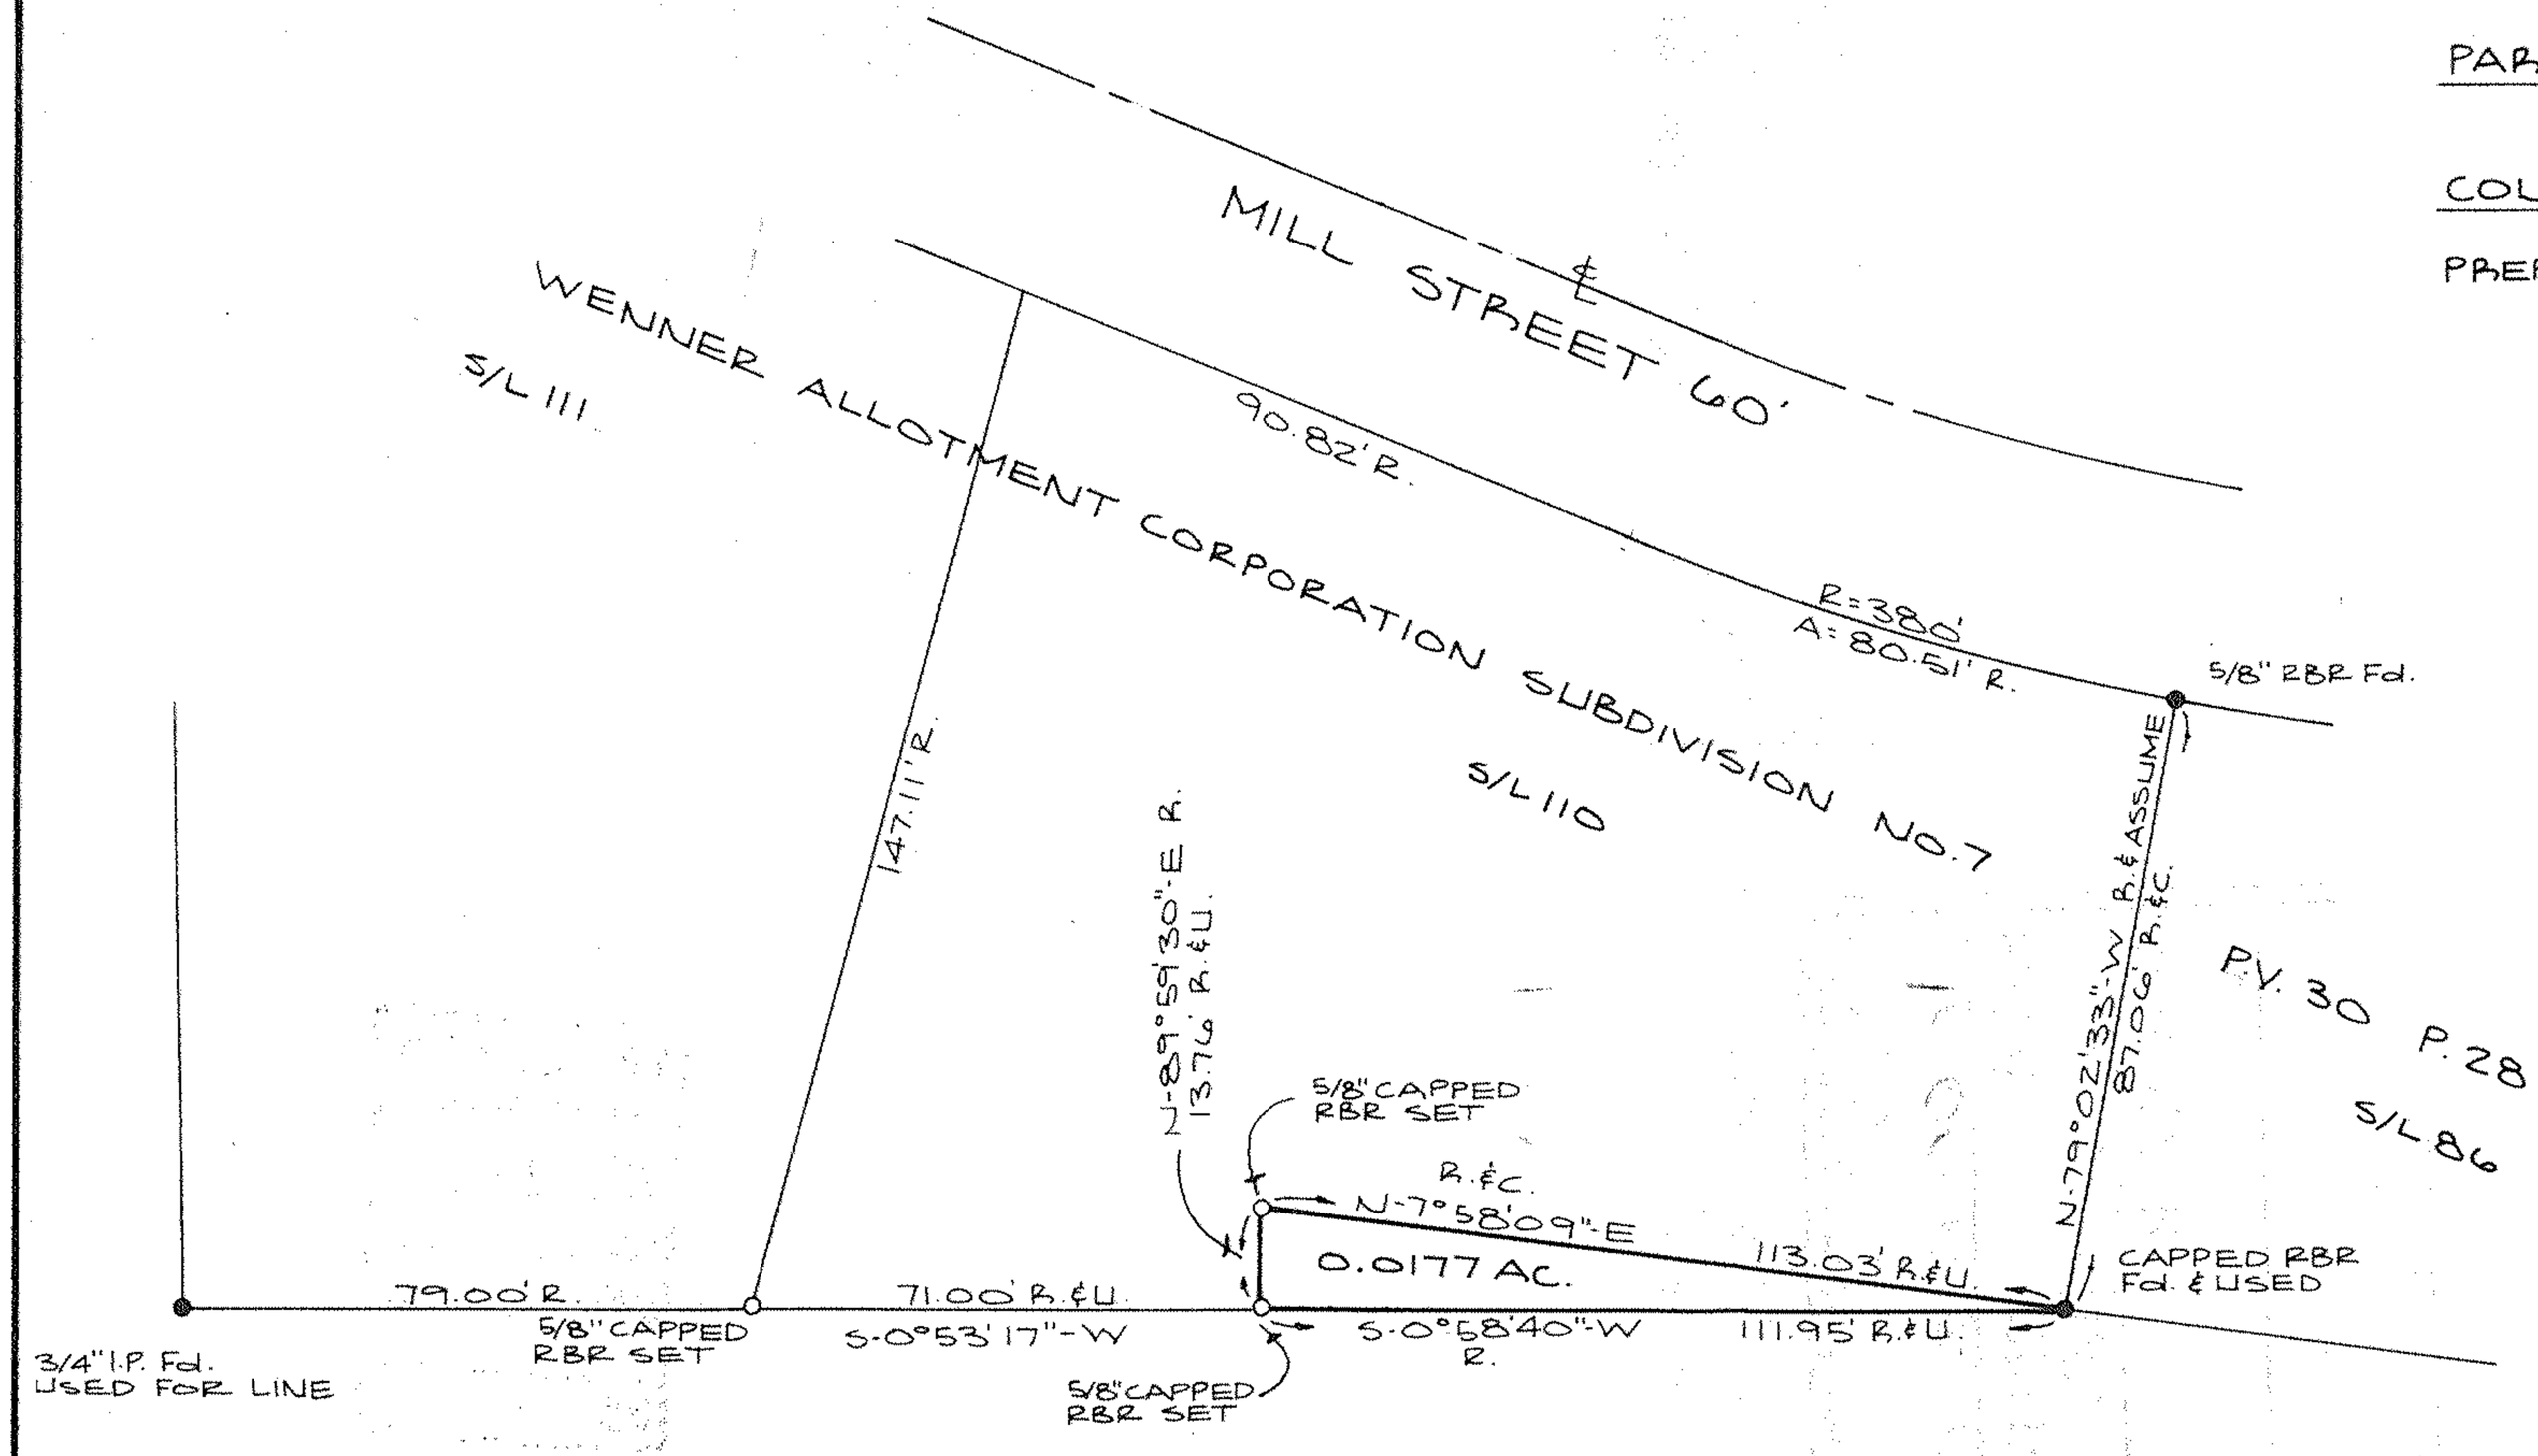

18-00-028-101-107
THE VILLAGE OF WELLINGTON D.V. 246 P. 584

NORTH

0 50 100
SCALE: 1" = 30'

22038

APPROVED
LORAIN CO.
MAP DEPT.
DATE 1-28-97
PAGE 18-00-028A
BY R. BELL
MAP NUMBER # 22038

STATE OF OHIO
DAVID L. ELWELL
6333
REGISTERED
SURVEYOR

David L. Elwell
REG. SURVEYOR No. 6333

Scan # 48400

95453