




18-00-023-B

18-00-028-101-186, 187, 188

Scan # 4840Z

THORNWOOD DRIVE 60'

MEADOW LANE 60'
500.74'

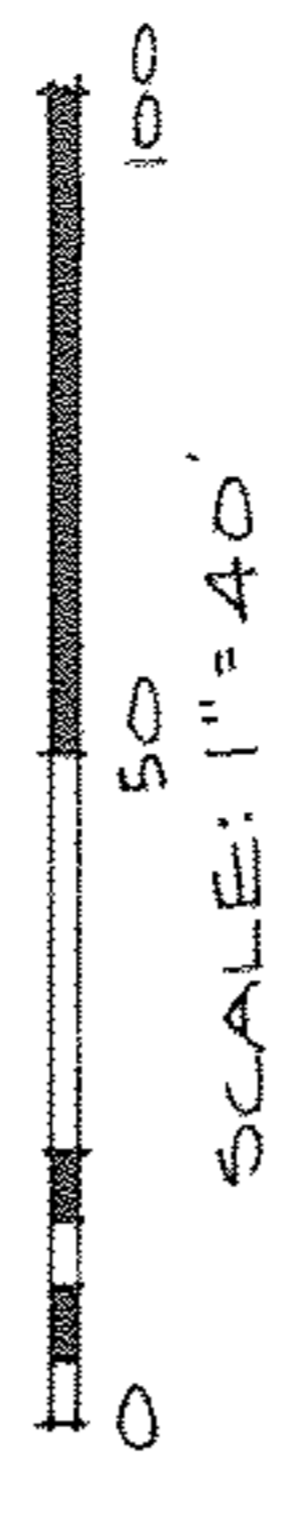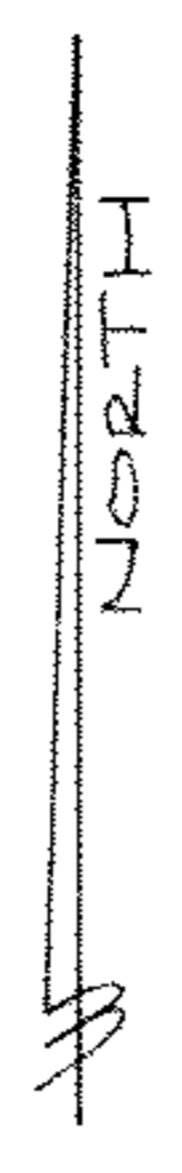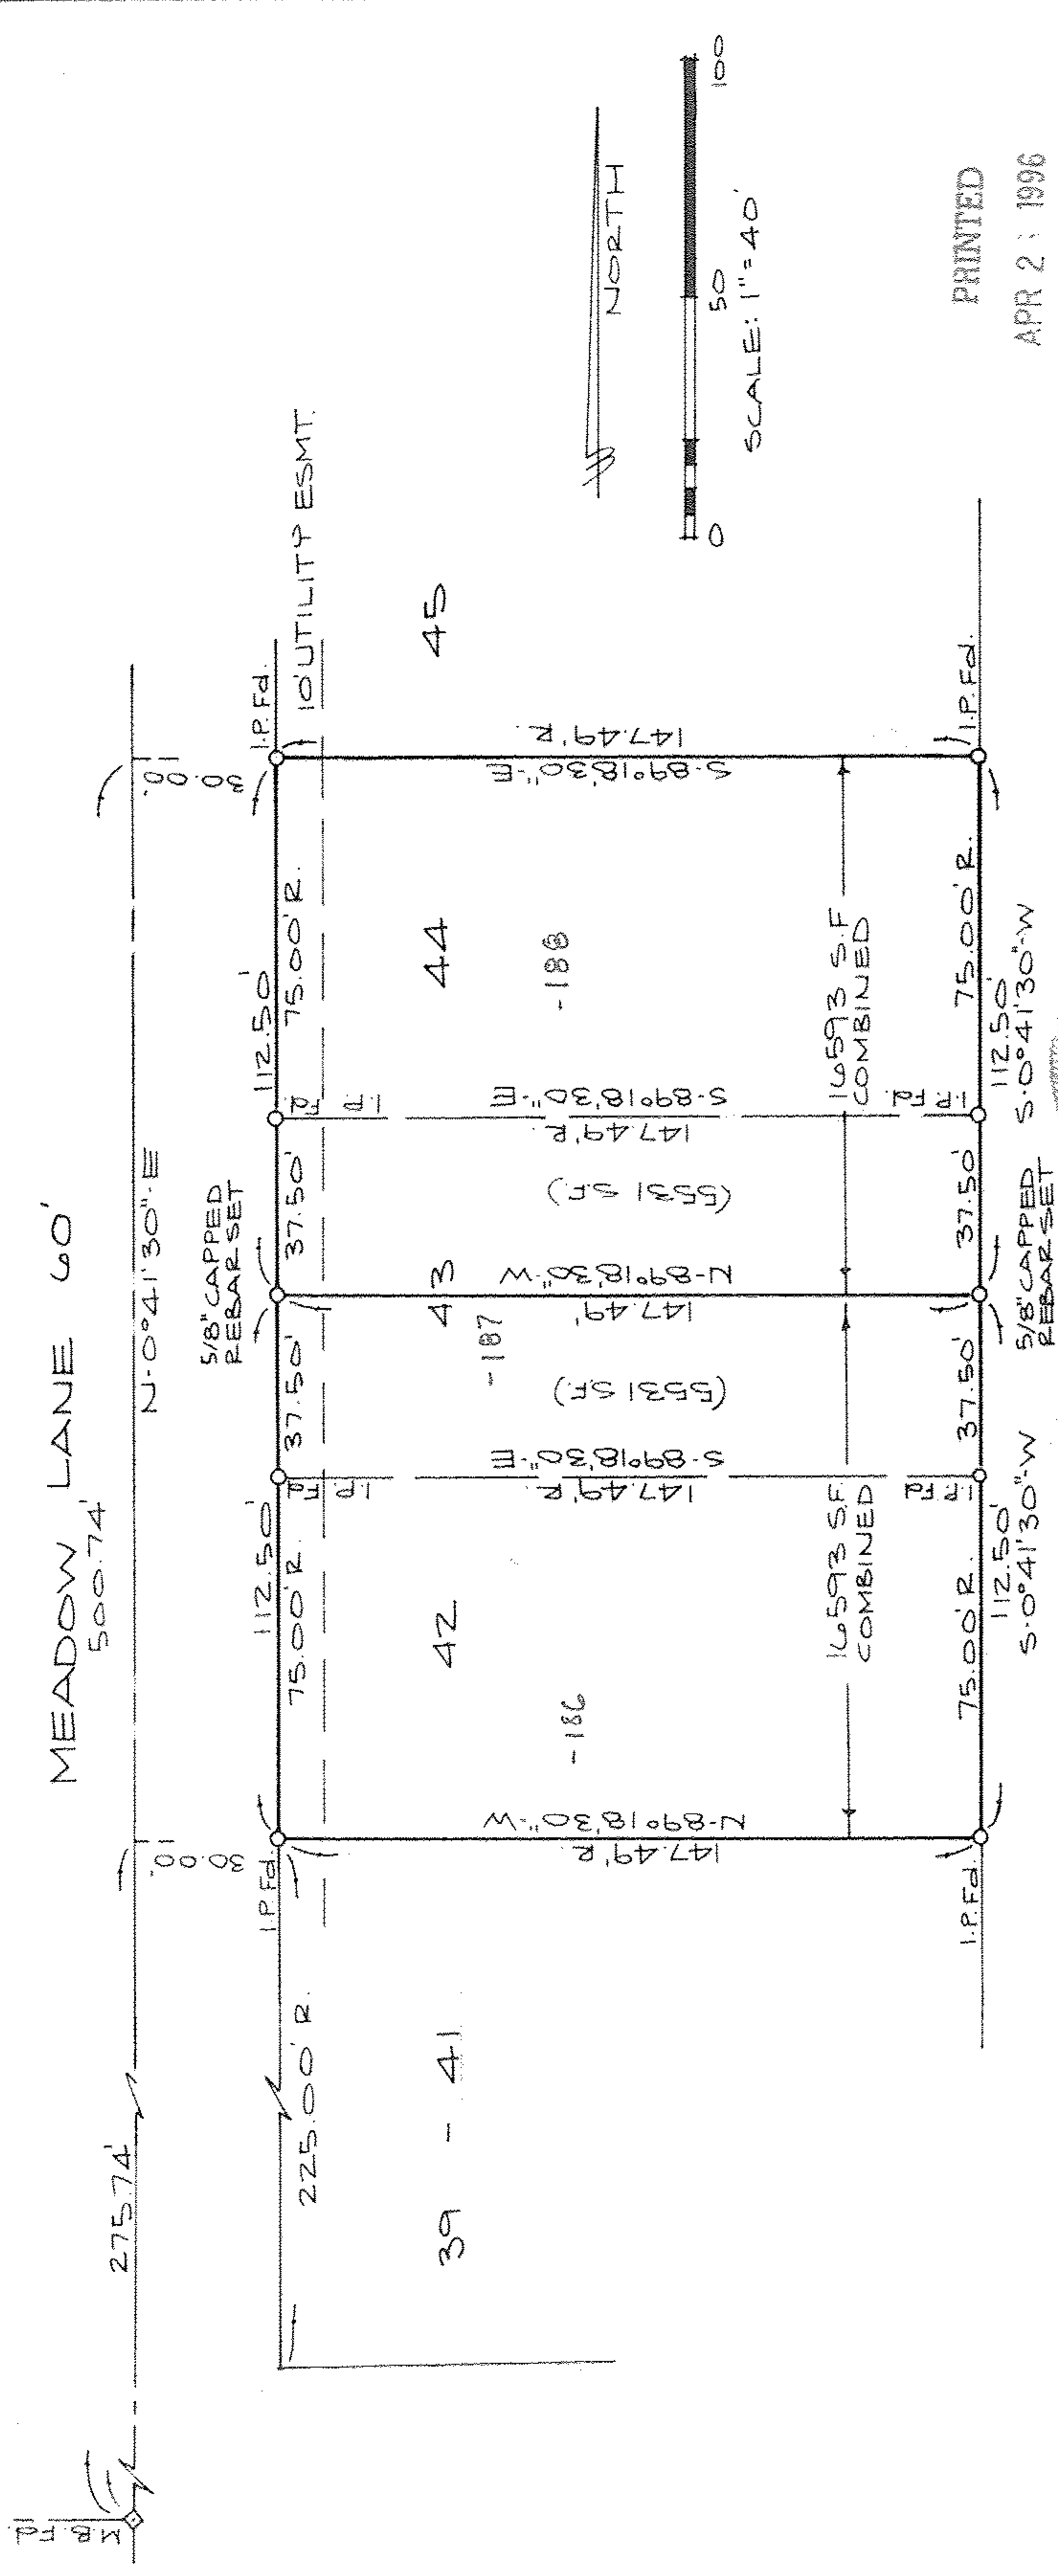

PRINTED

APR 2, 1996

KS ASSOCIATES, INC.

SURVEY MAP

SUBLOT No. 43 IN


THE MEADOWS SUBD. No. 3

P.V. 56 P. 66

VILLAGE OF WELLINGTON

COUNTY OF LOHAIN STATE OF OHIO

94571-543

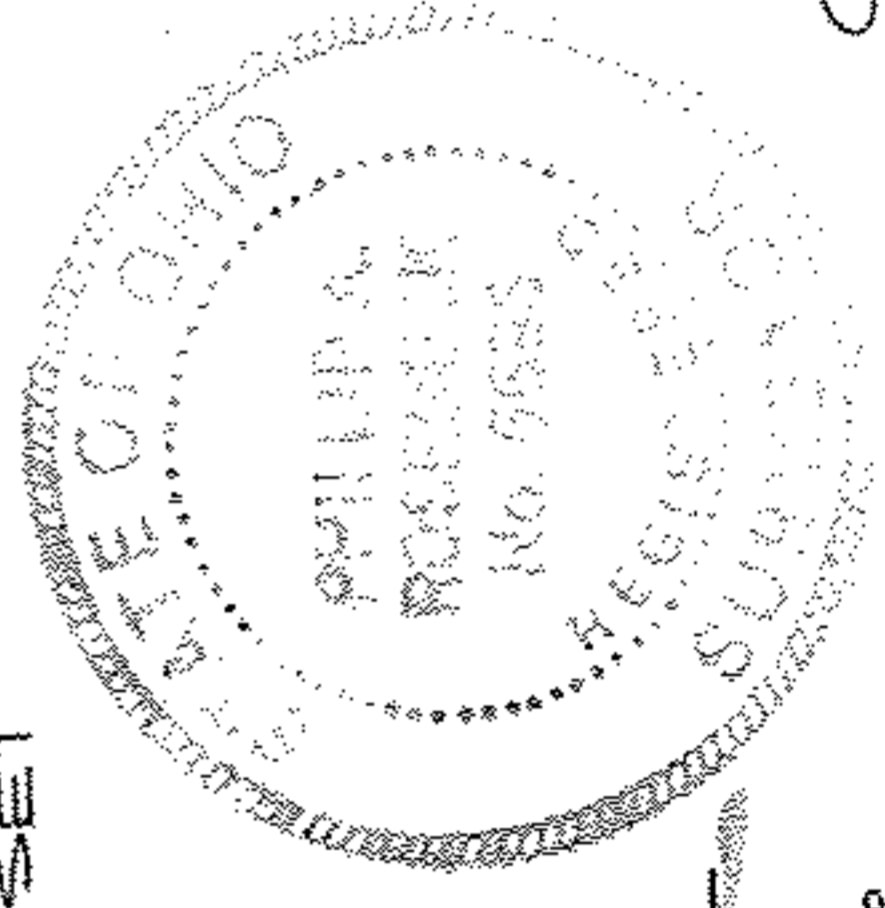

Phil A. Rosebeck
 PHIL A. ROSEBECK
 REG. SURVEYOR No. 5585

PREPARED BY:

KS ASSOCIATES INC.

ENGINEER SURVEYORS

4-23-96