06-24-083-101-023 6-80
Scan # 48430
(Lisa Brennenman) Smith

RIVERSTONE

civil engineers surveyors land planners

SUBLOT(S) / ORIGINAL LOT NO(S): PART OF 79
SUBDIVISION / ORIGINAL TOWNSHIP: BRAMAN SUBD.
PLAT VOL. NO: 3 PAGE: 1
RECORDED IN LORAIN COUNTY RECORDS
PERMANENT PARCEL NO: 06-24-083-101-023

RIV NO. 139094
DRAWN BY: KAY
DATE: 04-26-2007

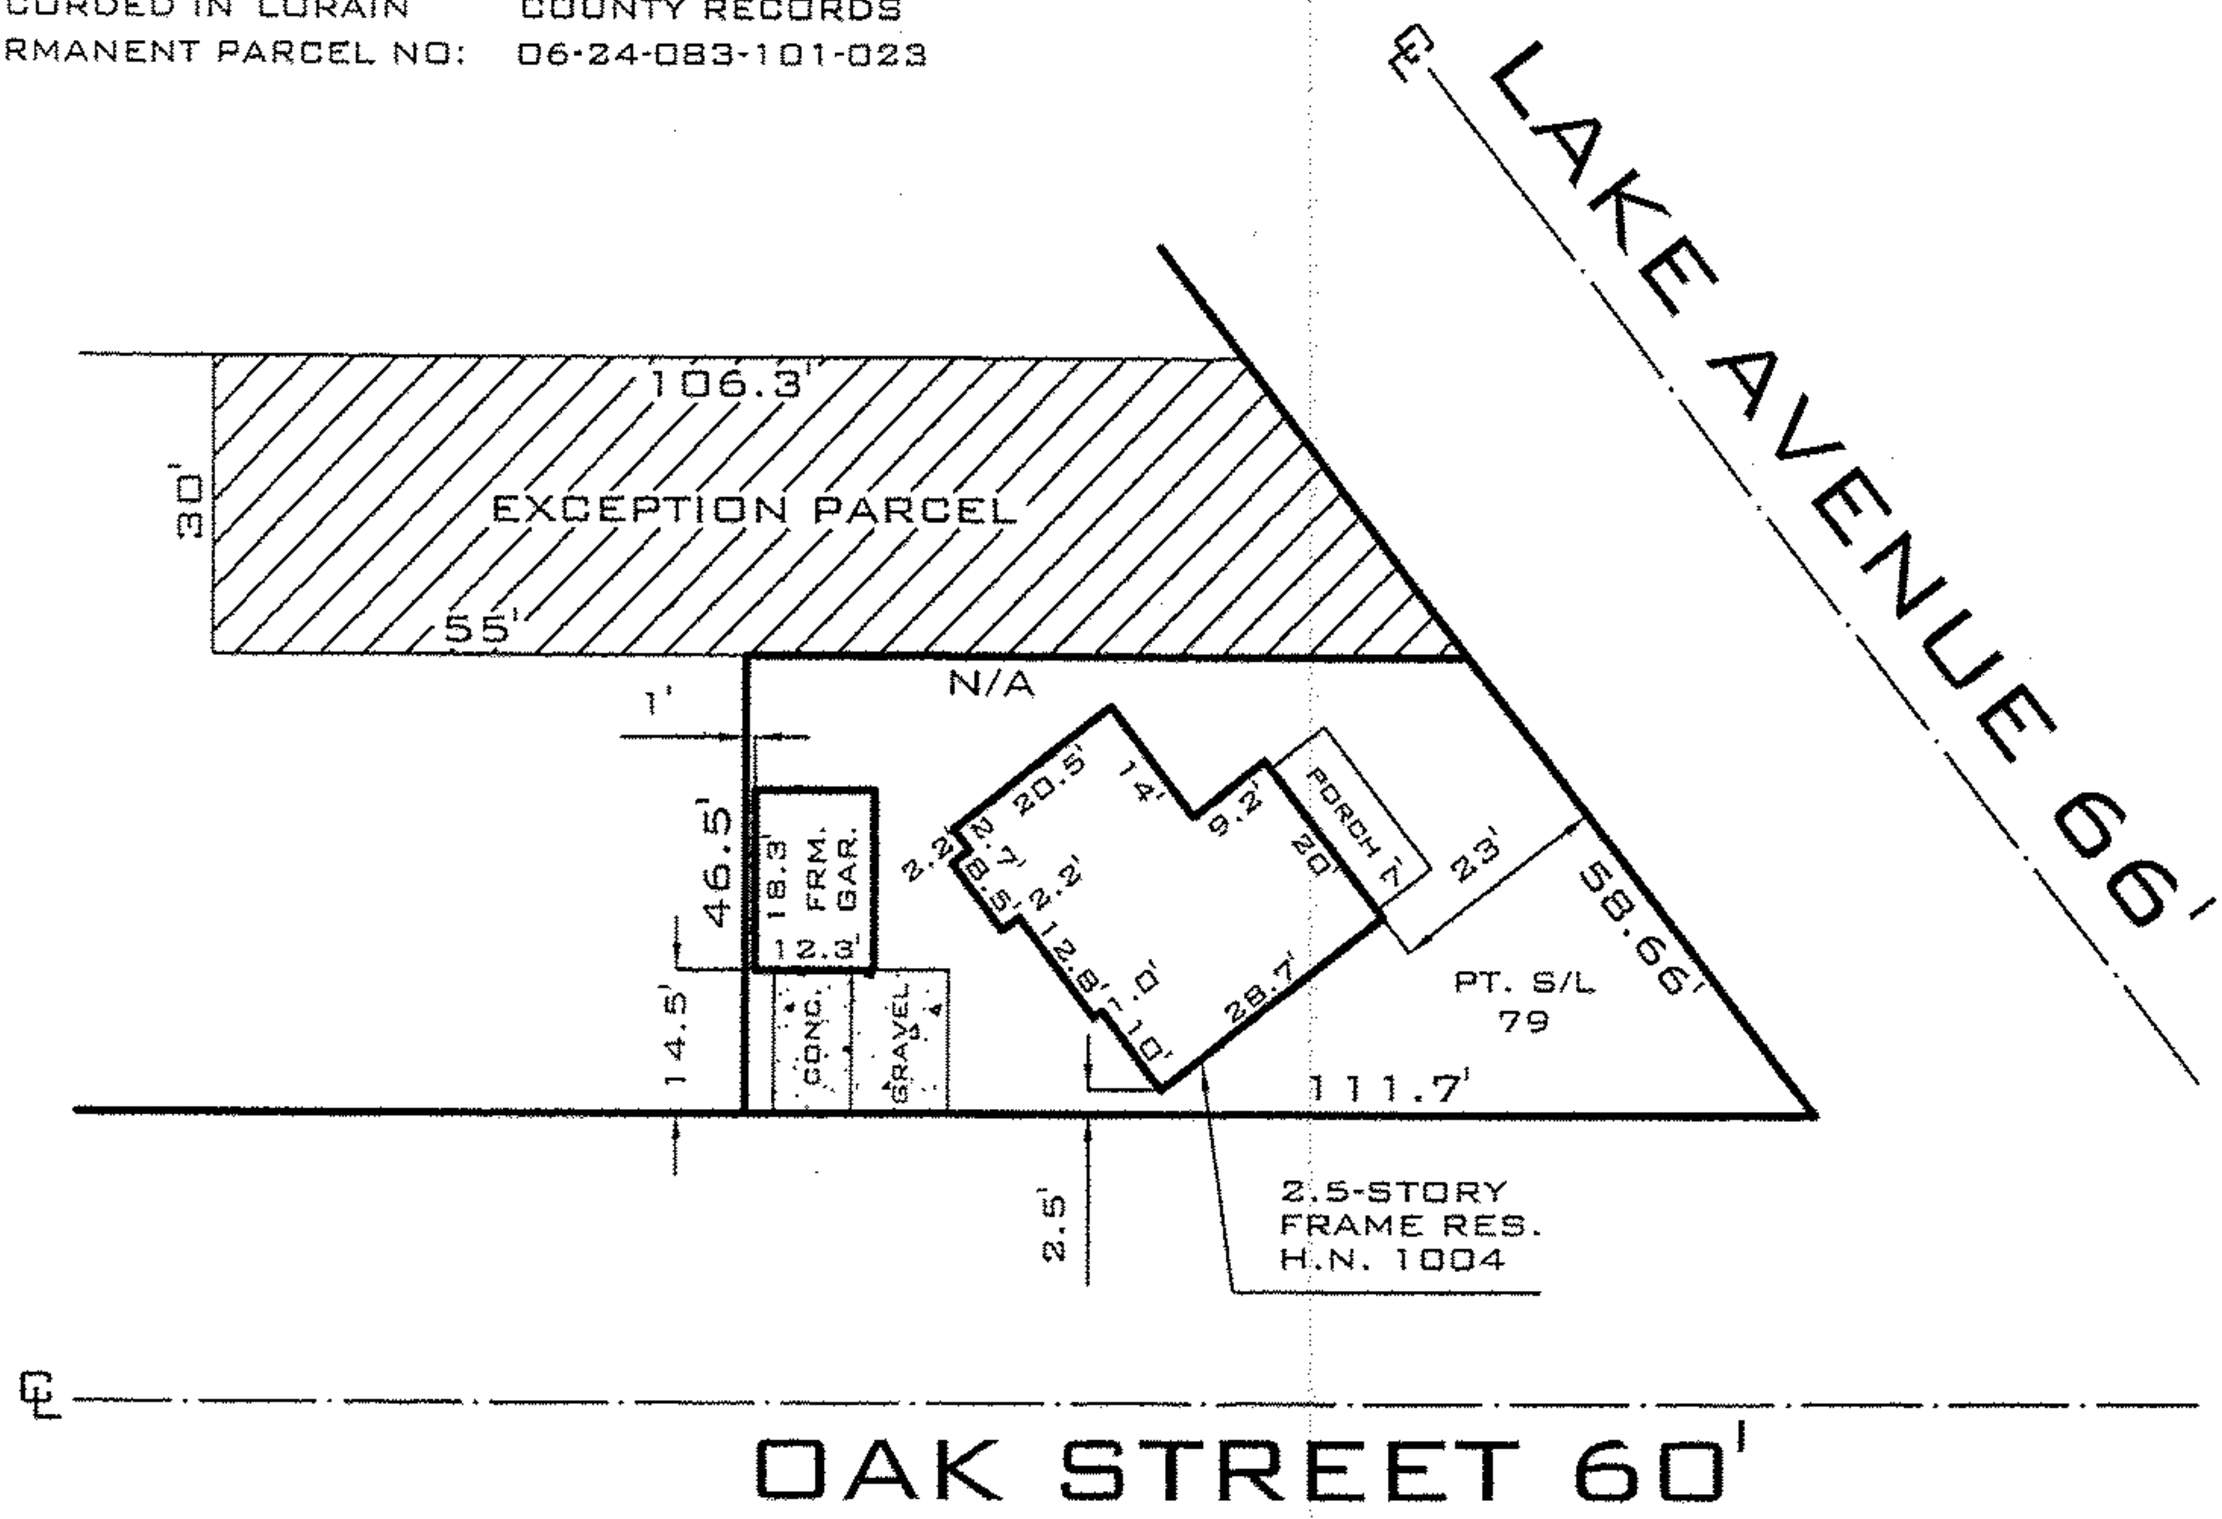

15 30 60

SCALE: 1" = 30'

ACKNOWLEDGED AND ACCEPTED:

X _____
BUYER/BORROWER DATE

X _____
BUYER/BORROWER DATE

STATE OF OHIO
EDWARD B. DUDLEY III
PS 6747
REGISTERED PROFESSIONAL SURVEYOR

I HEREBY DECLARE THAT THE BUILDING(S) SITUATED IN THE DESCRIBED REAL ESTATES ARE LOCATED ON AND WITH IN THE BOUNDARIES OF SAID PREMISES UNLESS SHOWN OTHERWISE. THIS SURVEY WAS NOT PERFORMED FOR THE PURPOSE OF ESTABLISHING BOUNDARY LINES, AND SHOULD NOT BE USED AS A BOUNDARY OR LAND SURVEY. THIS MORTGAGE LOCATION SURVEY IS IN ACCORDANCE WITH THE OHIO ADMINISTRATIVE CODES 4733-38 AND 4733-37.

WWW.RIVERSTONESURVEY.COM

☐ CLEVELAND 2618 North Moreland Blvd., Cleveland, OH 44120
P 216.491.2000 F 216.491.9640

☐ CANTON 4150 Belden Village St. N.W Suite 307, Canton, OH 44718
P 330.492.2747 F 330.492.2757