

21-0 21-05-003-000-001

503M-4884.5

O.L. 12 TR. 5
O.L. 4 TR. 5

BURSLEY ROAD

5.87°16'E.

O.L. 4 TRACT 5

233.00'

O.L. 3 TRACT 5

N. 3°45'E. 300.00'

91°01'

1.6044 Ac.


88°59'

S. 3°45'W. 300.00'

N. 87°16'W. 233.00'

O.L. 11 TRACT 5
O.L. 3 TRACT 5

Louis H. Wilson O.K. 601 Pg. 318 June 17, 1954

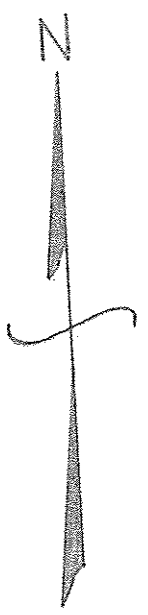

PLAT OF SURVEY FOR LOUIS H. WILSON
ORIGINAL LOT 3-TRACT 5-HUNTINGTON TWP.
LORAIN COUNTY - OHIO
SCALE: 1" = 60' JULY 11, 1956
C.E. Penfound Registered Surveyor

NOTE: Iron pins set shown thus: ●