21-15-000-000-068 SCAN# 48474
Parent 066

№ 01936

APPROVED
LORAIN CO.
MAP DEPT.
DATE 6-9-05
PAGE 21-G
BY R. MAINES
MAP 05-0193b

Plat of Survey
for
Barbara Lavely

Huntington Twp. Tract 15
Lorain Co. Ohio

Carlson Surveys
May 5, 2005

STATE OF OHIO
RICHARD D. CARLSON
7496
REGISTERED SURVEYOR
5-9-05

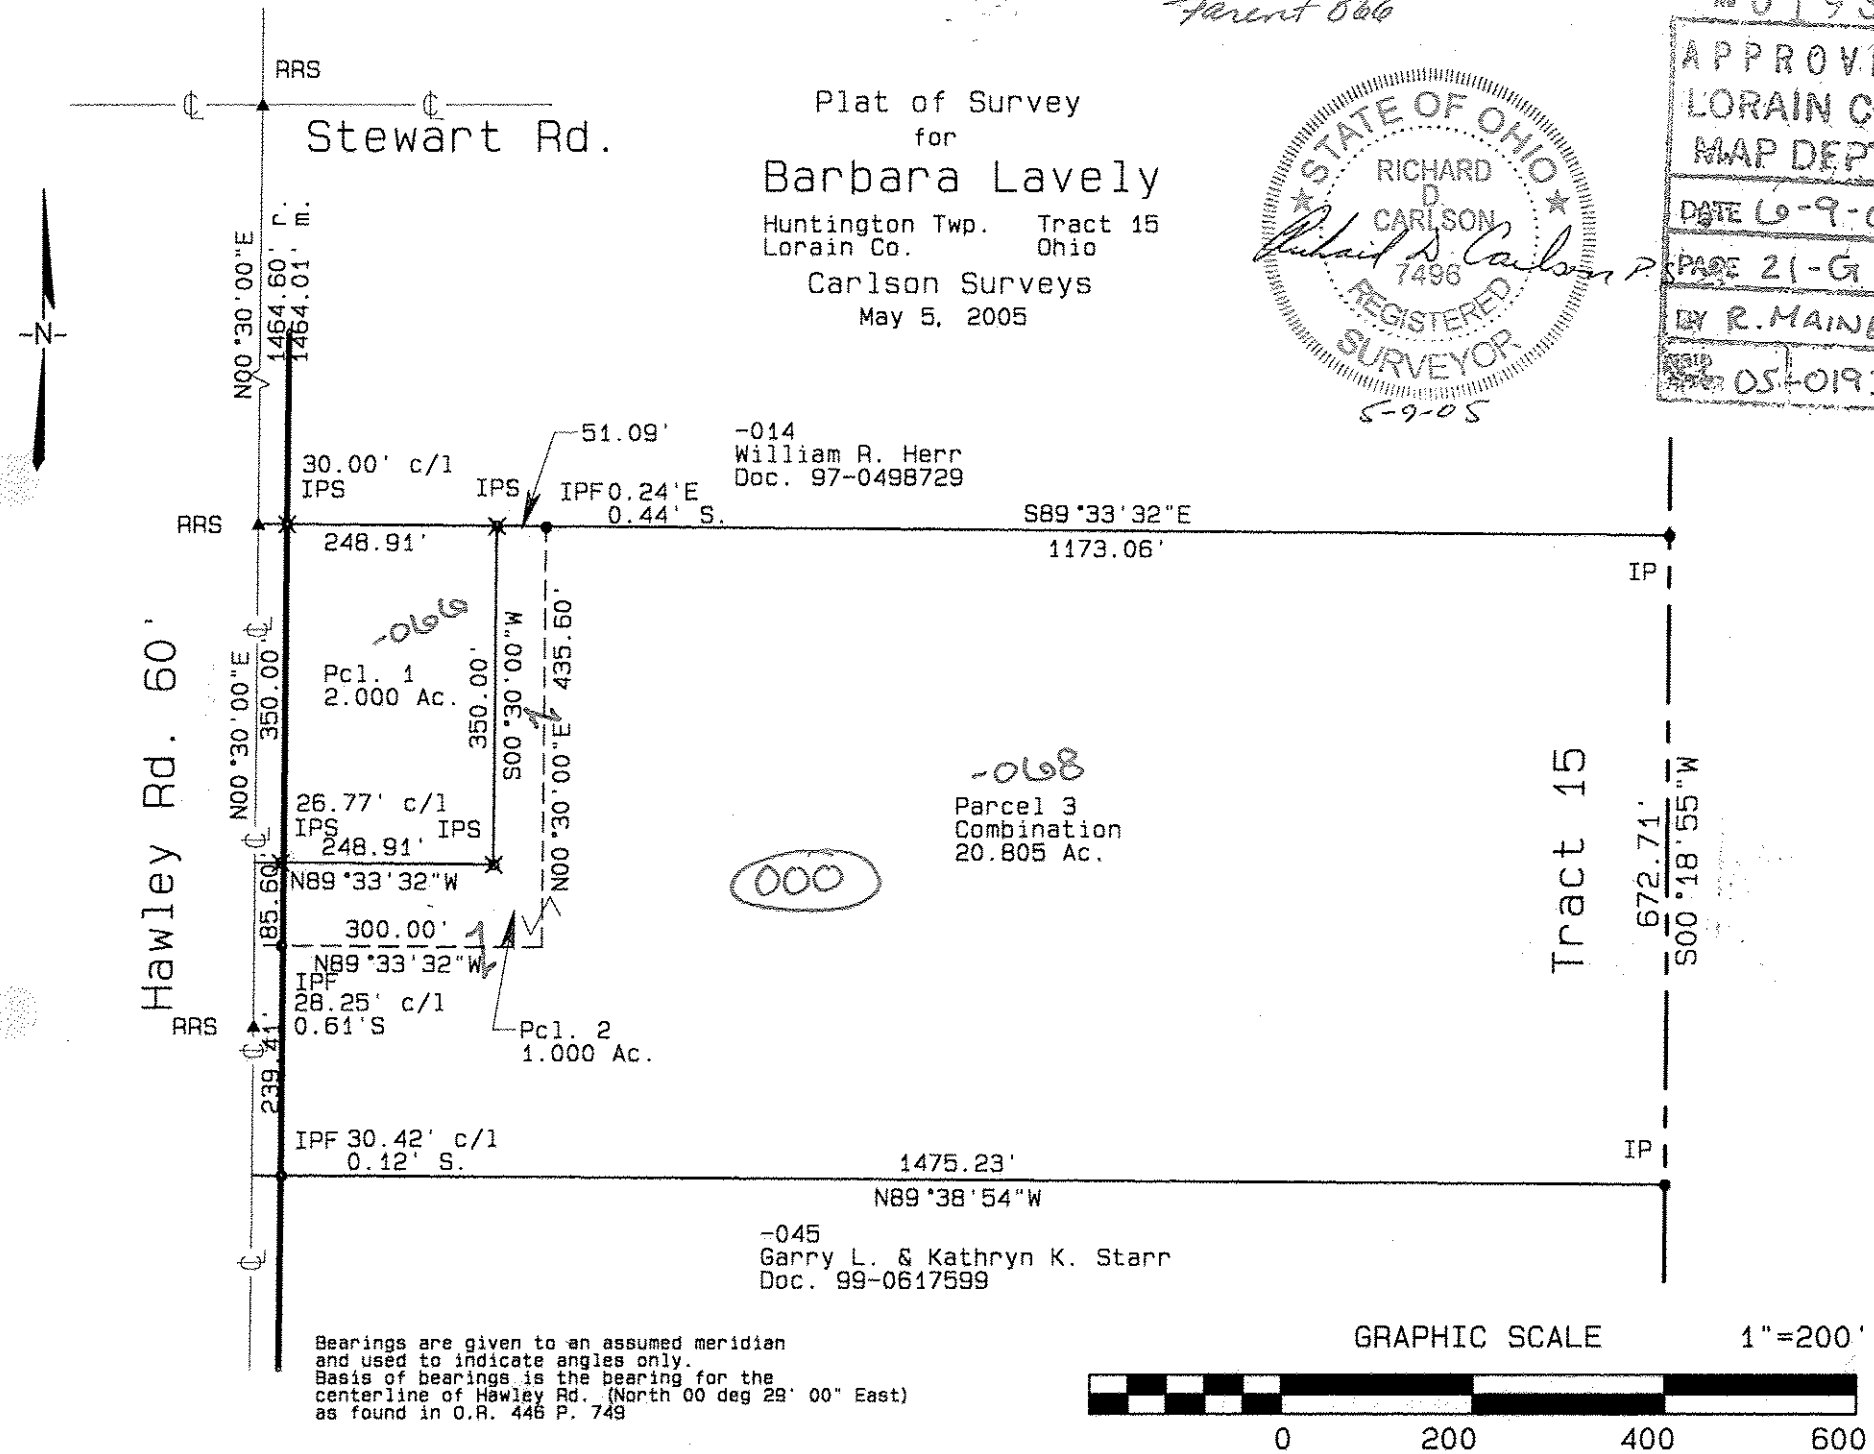

Bearings are given to an assumed meridian and used to indicate angles only. Basis of bearings is the bearing for the centerline of Hawley Rd. (North 00 deg 29' 00" East) as found in O.R. 446 P. 749

GRAPHIC SCALE 1"=200'

0 200 400 600