
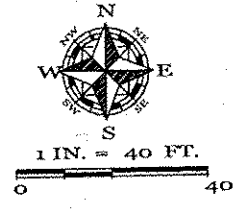


03-00-066-101-009
006

Scan # 48533

<p>Haywood Civil Engineering & Land Surveying, Inc.</p> <p>Dale R. Haywood, P.S. Professional Land Surveyor</p> <p>(440) 897-3655 dh@dhsurveying.com</p>	<p>BOUNDARY SURVEY MAP</p> <p>SITUATED IN THE VILLAGE OF SHEFFIELD, COUNTY OF LORAIN, STATE OF OHIO</p> <p>BEING PART OF ORIGINAL SHEFFIELD TOWNSHIP LOT 66 TOWNSHIP 7 NORTH, RANGE 17 WEST, CONNECTICUT WESTERN RESERVE</p> <p>CONTAINING 0.4991 ACRES</p>	 <p>1 IN. = 40 FT.</p>
---	--	---

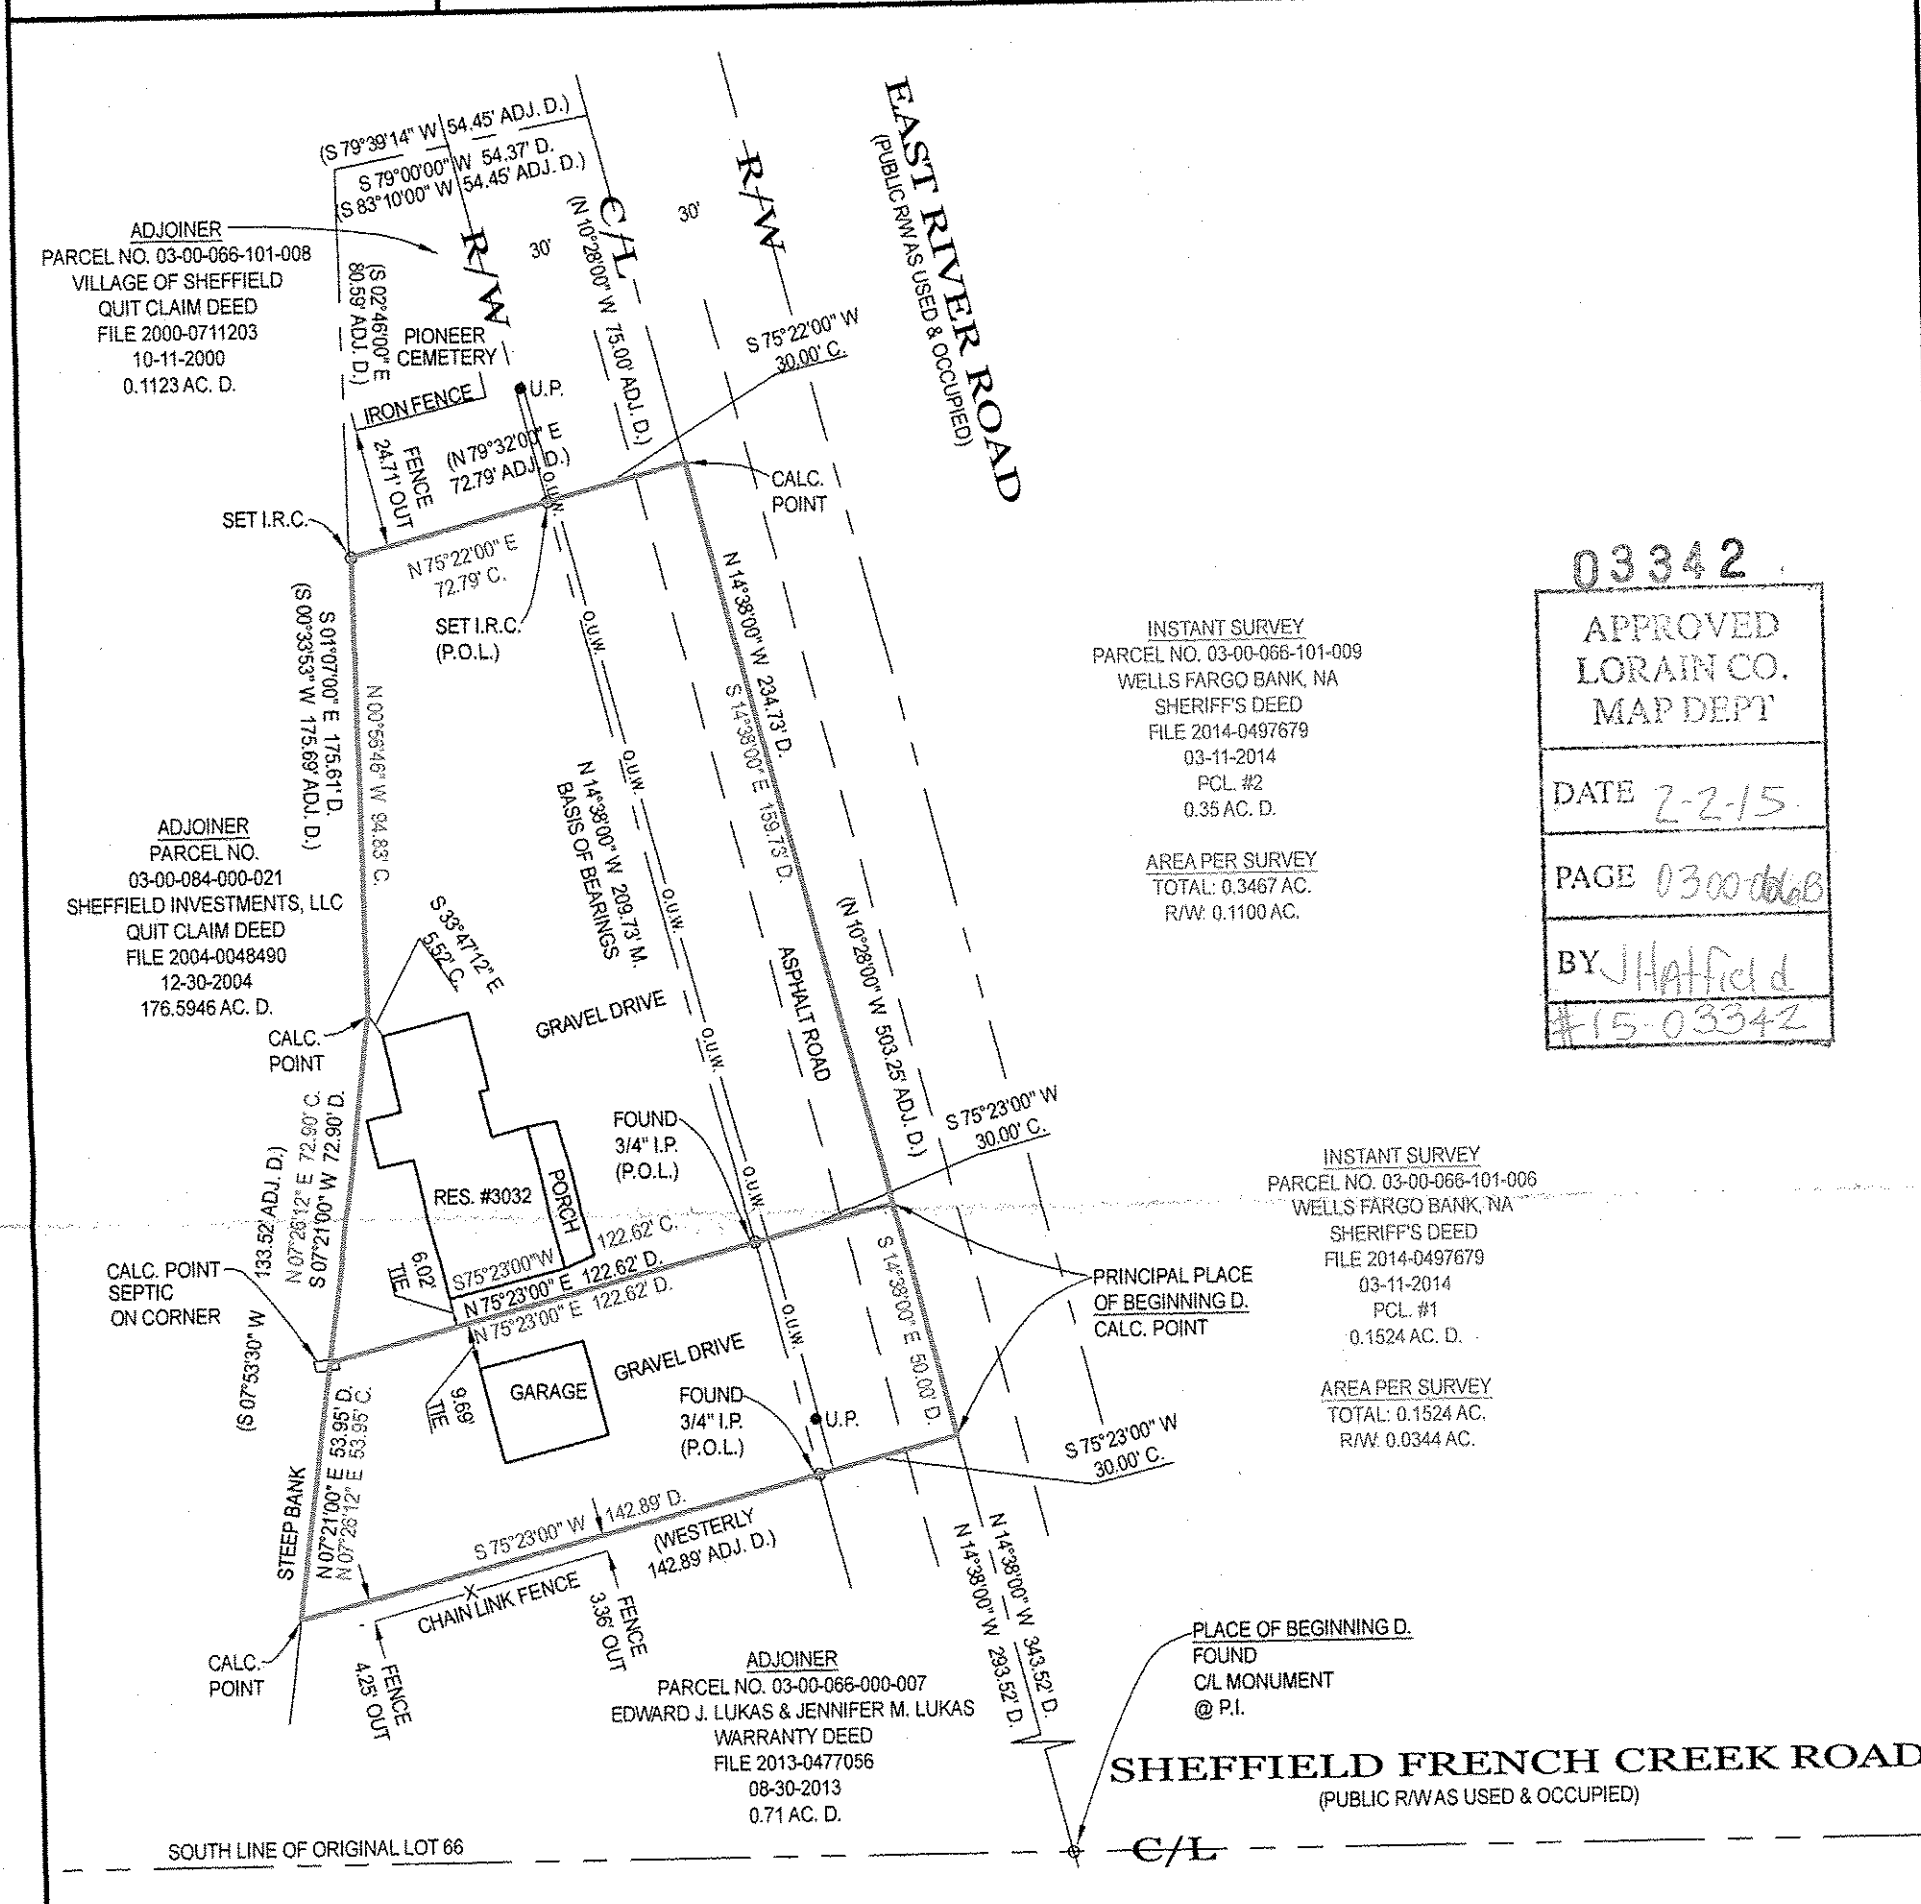

03342

APPROVED LORAIN CO. MAP DEPT
DATE 2-2-15
PAGE 0300-066B
BY J. Hatfield
#15-03342

LEGEND:

A/C = AIR CONDITIONER
AC. = ACRE
ADJ. = ADJOINER
ADJC. = ADJACENT
B.L. = BUILDING LINE
B.O.C. = BACK OF CURB
CH. = CHORD
CONC. = CONCRETE
C. = CALC. = CALCULATED
C.B. = CATCH BASIN
C.O. = CLEAN OUT
C/L = CENTERLINE

D. = DEED
D.S. = DOWNSPOUT
D.H. = DRILL HOLE
E.O.P. = EDGE OF PAVEMENT
E.O.W. = EDGE OF WATER
ELEC. = ELECTRIC
ELEV. = ELEVATION
E.M. = ELECTRIC METER
EX. = EXISTING
FF. = FINISHED FLOOR
F.G. = FINISHED GRADE
F.H. = FIRE HYDRANT
F/L = FLOWLINE

G.F. = GARAGE FLOOR
G.M. = GAS METER
G.V. = GAS VALVE
I.D. = IDENTIFICATION
I.P. = IRON PIPE
I.P.C. = IRON PIPE & I.D. CAP
I.R. = IRON ROD
I.R.C. = IRON ROD & I.D. CAP
INV. = INVERT
L. = LENGTH
LAT. = LATERAL
L.P. = LIGHT POLE
M. = MEASURED

M.H. = MANHOLE
N.G. = NATURAL GRADE
O.R. = OFFICIAL RECORDS
O.U.W. = OVERHEAD UTILITY WIRES
P. = PLAT
PCL. = PARCEL
P.C. = POINT OF CURVATURE
P.R.C. = POINT OF REVERSE CURVATURE
P.I. = POINT OF INTERSECTION
P.T. = POINT OF TANGENCY
P.O.L. = POINT ON LINE
PROP. = PROPOSED

P.S. = PROFESSIONAL SURVEYOR
SAN. = SANITARY
STM. = STORM
SWR. = SEWER
SVC. = SERVICE
S.Y. = SIDE YARD
R.Y. = REAR YARD
R. = RADIUS
REC. = RECORD
RES. = RESIDENCE
R/W. = RIGHT OF WAY
S.F. = SQUARE FEET
T. = TANGENT

T.C. = TOP OF CURB
T.O.B. = TOP OF BANK
TEL. = TELEPHONE
T.B.M. = TEMPORARY BENCHMARK
TIE = PERPENDICULAR DISTANCE TO BOUNDARY LINE
U.E. = UTILITY EASEMENT
U.P. = UTILITY POLE
WAT. = WATER
W.M. = WATER METER
W.V. = WATER VALVE
W.W. = WATER WELL
Δ = DELTA = INCLUDED ANGLE

NOTES:

SIZE OF MONUMENTATION FOUND IS NOTED ON MAP AND IS AT GRADE UNLESS NOTED OTHERWISE. MONUMENTATION ABOVE GRADE IS NOTED (+) AND BELOW GRADE IS NOTED (-). THE MONUMENTATION I.D. IS NOTED WHERE EXISTS AND LEGIBLE. IRON RODS SET ARE 30" LONG, 5/8" DIAMETER REBAR WITH I.D. CAP "HAYWOOD 8284" AND SET TO GRADE. SURVEYOR NAILS SET INCLUDE I.D. DISK. CORNERS NOT MONUMENTED ARE LABELED CALCULATED POINT.

COURSES DETERMINED FOR THIS SURVEY ARE COMPARED TO RECORD COURSES AND NOTED WHEN THEY VARY. DISTANCES SHOWN ON THE MAP ARE IN FEET AND DECIMAL PARTS THEREOF.

DOCUMENTS USED ARE CITED ON THE MAP. EASEMENTS OR OTHER RESTRICTIONS MAY AFFECT INSTANT PARCEL. THE SURVEYOR DID NOT RESEARCH THE TITLE ABSTRACT.

OCCUPATION IS CONSISTENT WITH TITLE LINES.

BASIS OF BEARINGS DESCRIBED IN RECORD DESCRIPTIONS OF INSTANT PARCEL, ADJOINING PARCELS, AND ADJACENT PARCELS MAY REFERENCE DIFFERENT MERIDIANS. COURSES LABELED ON THIS SURVEY MAP THAT REFERENCE A DIFFERENT MERIDIAN FROM THE MERIDIAN USED TO DESCRIBE THE BOUNDARIES OF INSTANT PARCEL ARE ENCLOSED IN PARENTHESIS ().

THE BASIS OF BEARINGS FOR INSTANT SURVEY IS N 14°38'00" W FOR THE WEST LINE OF EAST RIVER ROAD AS RECORDED IN FILE 2014-0497679. REFER TO MAP FOR LOCATION OF LINE USED TO ESTABLISH THE BASIS OF BEARINGS.

THE INTENT OF THIS SURVEY IS TO UPDATE THE DESCRIPTION OF AN EXISTING PARCEL.

FENCE OWNERSHIP NOT DETERMINED.

SURVEYOR'S CERTIFICATION

I CERTIFY THAT THIS PLAT OF SURVEY WAS PREPARED IN ACCORDANCE WITH OHIO ADMINISTRATIVE CODE CHAPTER 4733-37 STANDARDS FOR BOUNDARY SURVEYS.



FIELD: JUNE 27, 2014
DRAWING: JUNE 30, 2014

Dale Haywood
DALE HAYWOOD, P.S.
OHIO REG. S-8284