
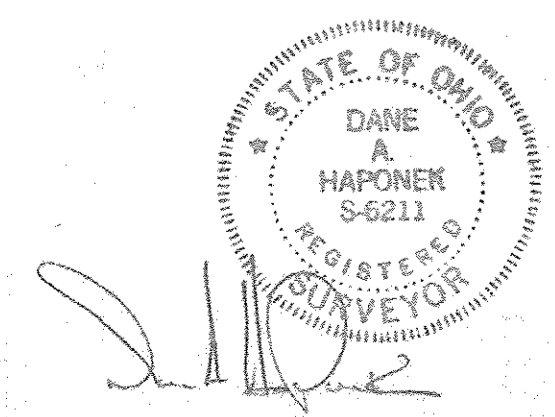


DATE: MARCH 1990  
SCALE: 1" = 50'

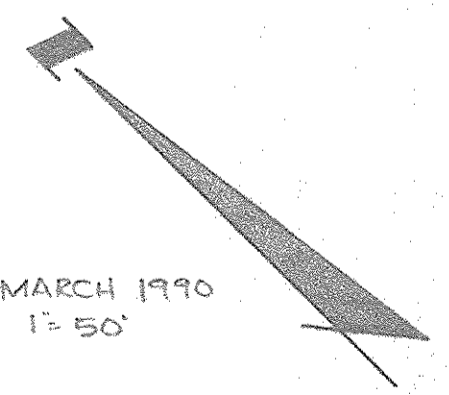

REVISED 4-18-90 PARCEL SPLITS ADDED  
REVISED 4-7-90 ADDED EXIST TRACKS

SHEET 2 OF 3