PLAT OF SURVEY
CLEARVIEW LOCAL SCHOOLS

SITUATED IN THE TOWNSHIP OF SHEFFIELD, COUNTY OF LORAIN AND STATE OF OHIO AND KNOWN AS BEING PART OF ORIGINAL BLACK RIVER TOWNSHIP TRACT 1, LOT 3 AND ORIGINAL SHEFFIELD TOWNSHIP LOTS 108 AND 113.

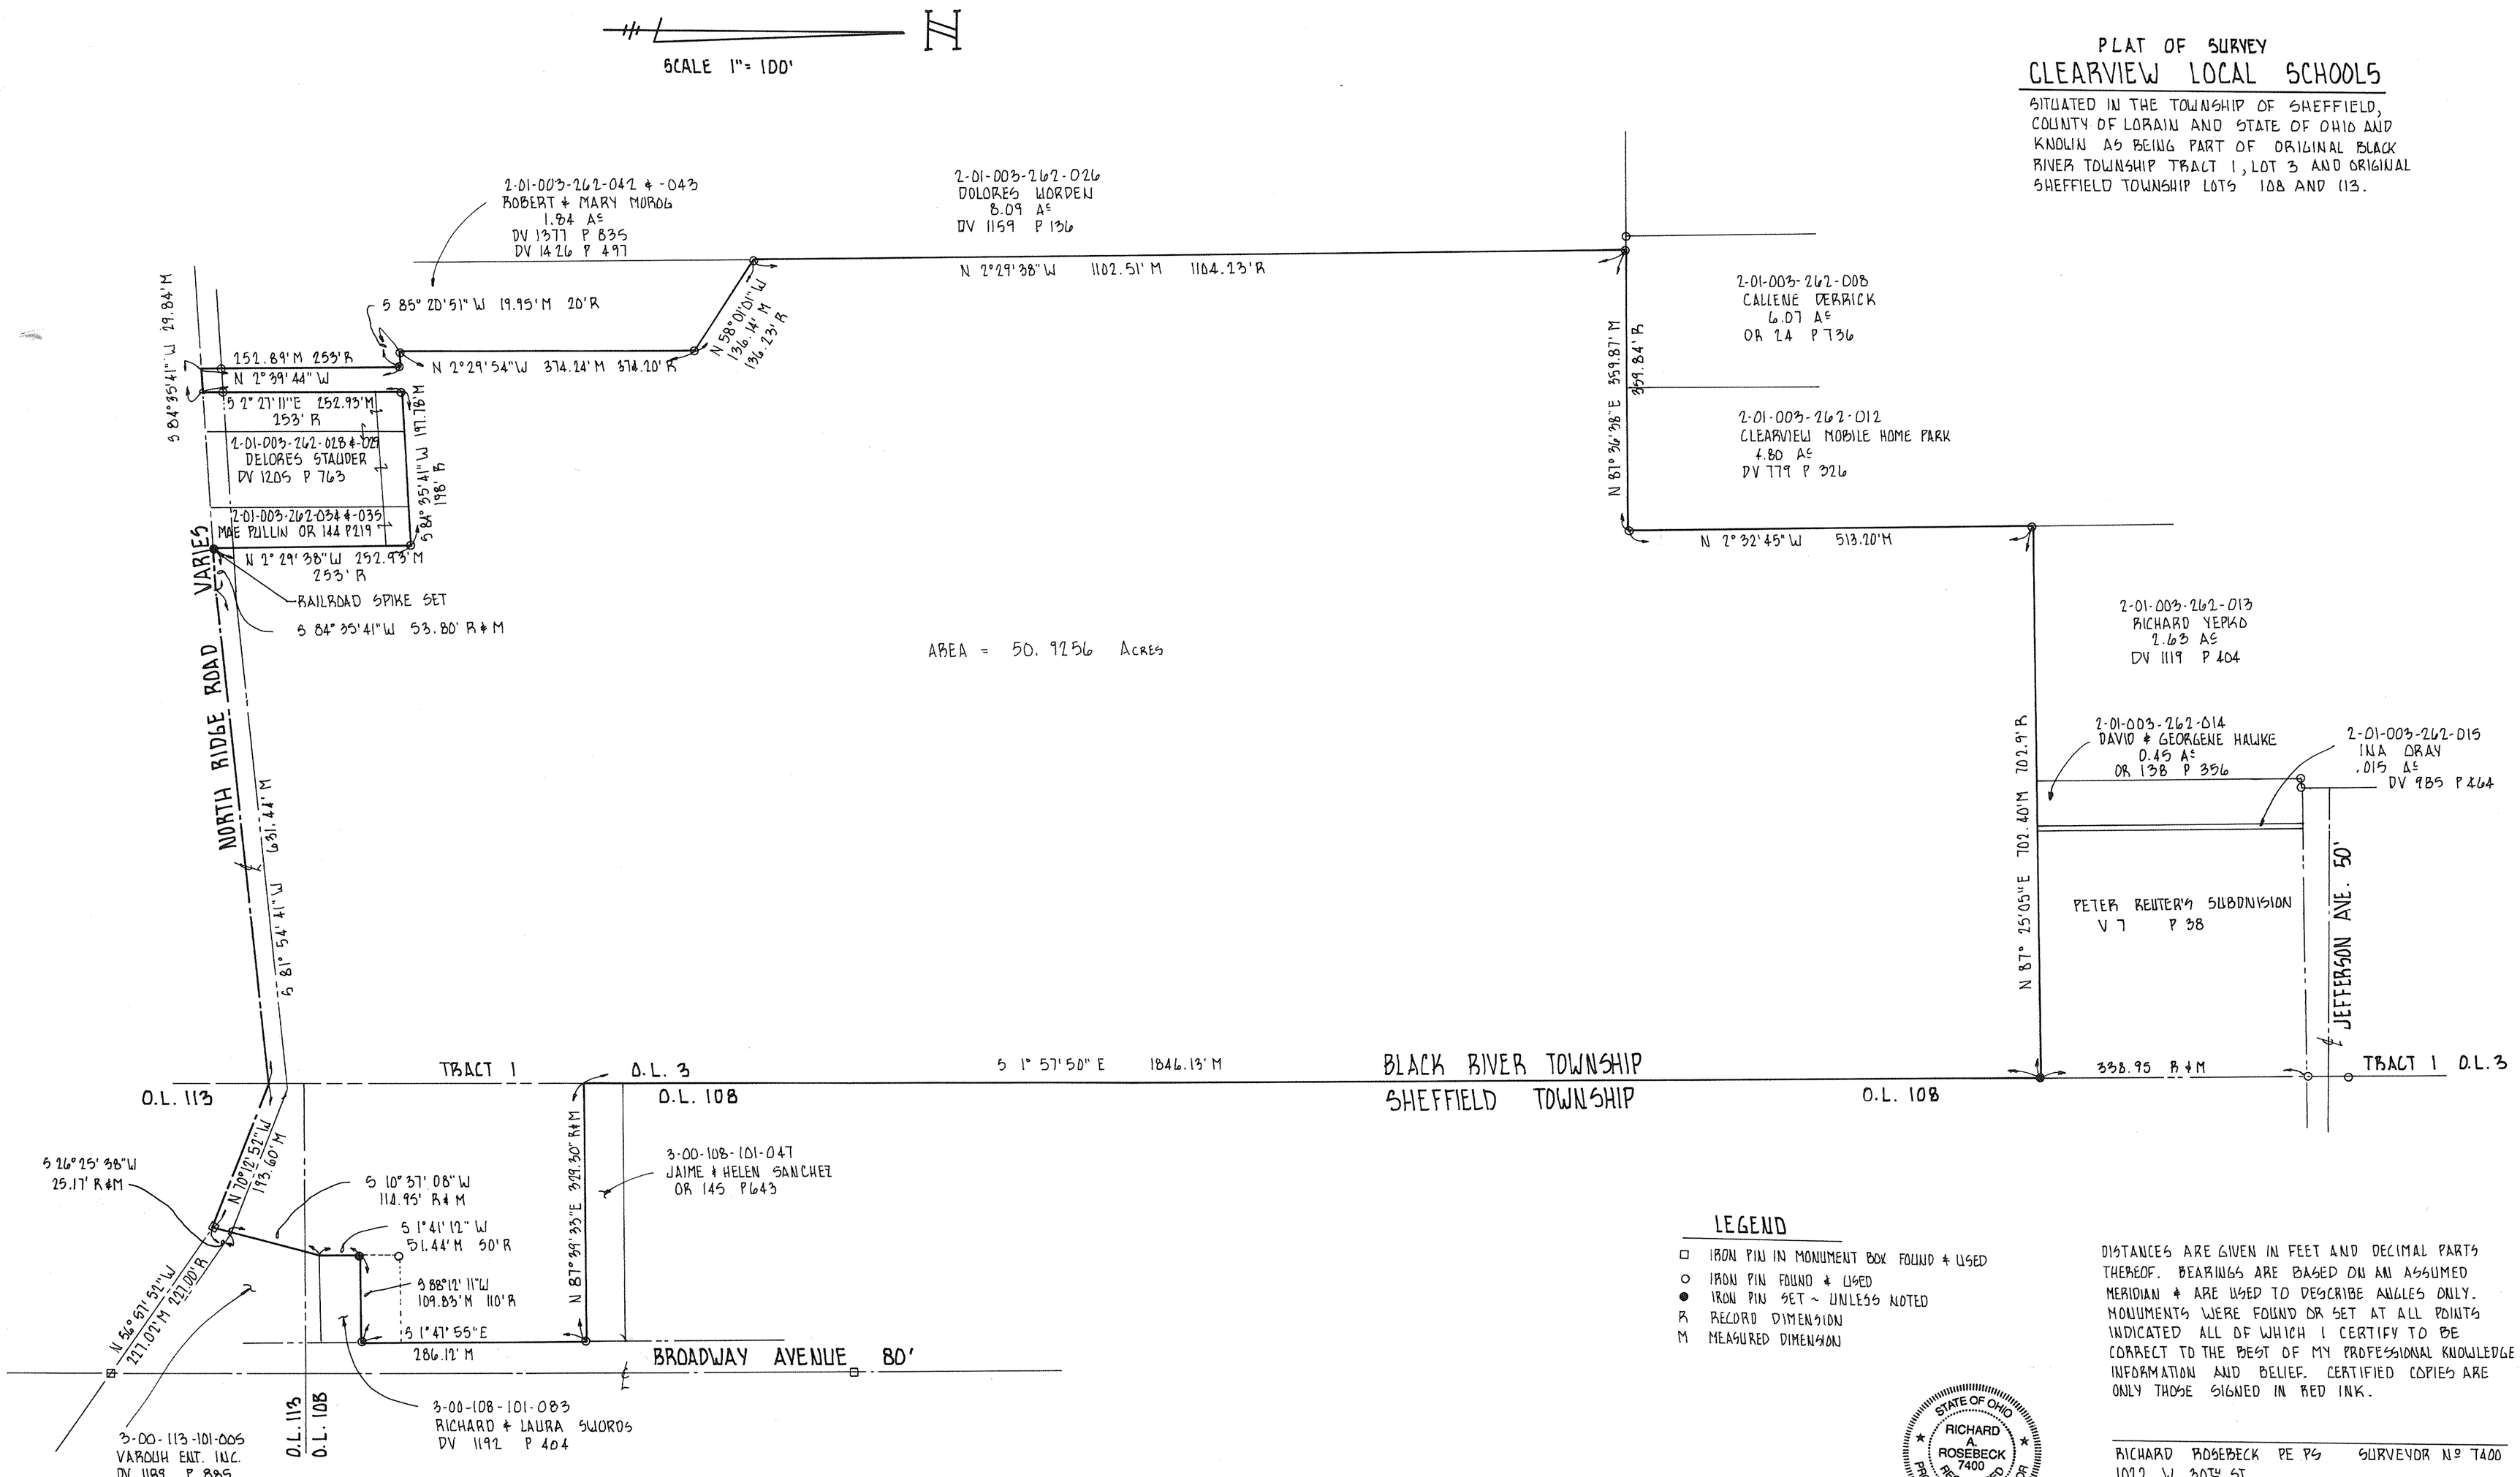

LEGEND

- □ IRON PIN IN MONUMENT BOX FOUND & USED
- ○ IRON PIN FOUND & USED
- ● IRON PIN SET ~ UNLESS NOTED
- R RECORD DIMENSION
- M MEASURED DIMENSION

DISTANCES ARE GIVEN IN FEET AND DECIMAL PARTS THEREOF. BEARINGS ARE BASED ON AN ASSUMED MERIDIAN & ARE USED TO DESCRIBE ANGLES ONLY. MONUMENTS WERE FOUND OR SET AT ALL POINTS INDICATED ALL OF WHICH I CERTIFY TO BE CORRECT TO THE BEST OF MY PROFESSIONAL KNOWLEDGE INFORMATION AND BELIEF. CERTIFIED COPIES ARE ONLY THOSE SIGNED IN RED INK.

STATE OF OHIO
RICHARD A. ROSEBECK
7400
REGISTERED
PROFESSIONAL SURVEYOR

RICHARD ROSEBECK PE PS SURVEYOR Nº 7400
1012 W 30TH ST.
LORAIN OHIO 44052
282-3872

02-01-003-262-044
02-01-003 L
Scan # 46558